



DRAWINGS AND WTP LAYOUTS



SITE PLAN AND BUILDING DRAWINGS



GNWT BUNDLED WTPs

WEKWEETI, NT

DRAWING LIST

GENERAL

G000 COVER SHEET

CIVIL

C101 SITE PLAN

C501 DETAILS

C502 DETAILS

ARCHITECTURE

A101 BUILDING ENVELOPE - GENERAL NOTES,

BUILDING CODE SUMMARY, FLOOR AND ROOF PLANS

A201 BUILDING ENVELOPE - EXTERIOR BUILDING ELEVATIONS,

EXTERIOR AND INTERIOR ROOM FINISH SCHEDULES

A301 BUILDING ENVELOPE - BUILDING SECTION AND DETAILS

A601 BUILDING ENVELOPE - DOOR, FRAME AND HARDWARE

SCHEDULE, SECTION AND DETAILS

STRUCTURAL

S001 NOTES & TABLES

S101 PLANS

S301 SECTIONS

S501 DETAILS

S502 DETAILS

S503 DETAILS

MECHANICAL

M010 SITE PLAN

M100 PLUMBING PLAN

M200 HVAC PLAN

M600 SCHEMATICS

M700 DETAILS

M800 SCHEDULES

ELECTRICAL


E100 SITE PLAN

E101 LIGHTING AND EMERGENCY LIGHTING PLAN

E102 POWER AND LOW TENSION PLAN


E500 ELECTRICAL DETAILS

E700 SCHEMATICS & SCHEDULES

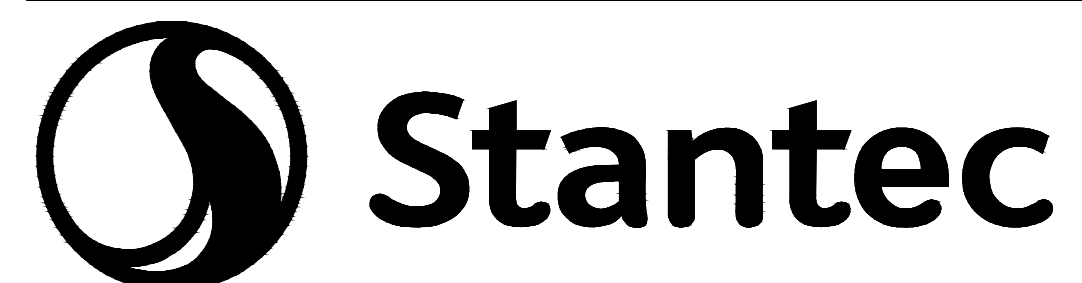


ISSUED FOR CONSTRUCTION - 11 SEPTEMBER 2018

Project Number: 144902412

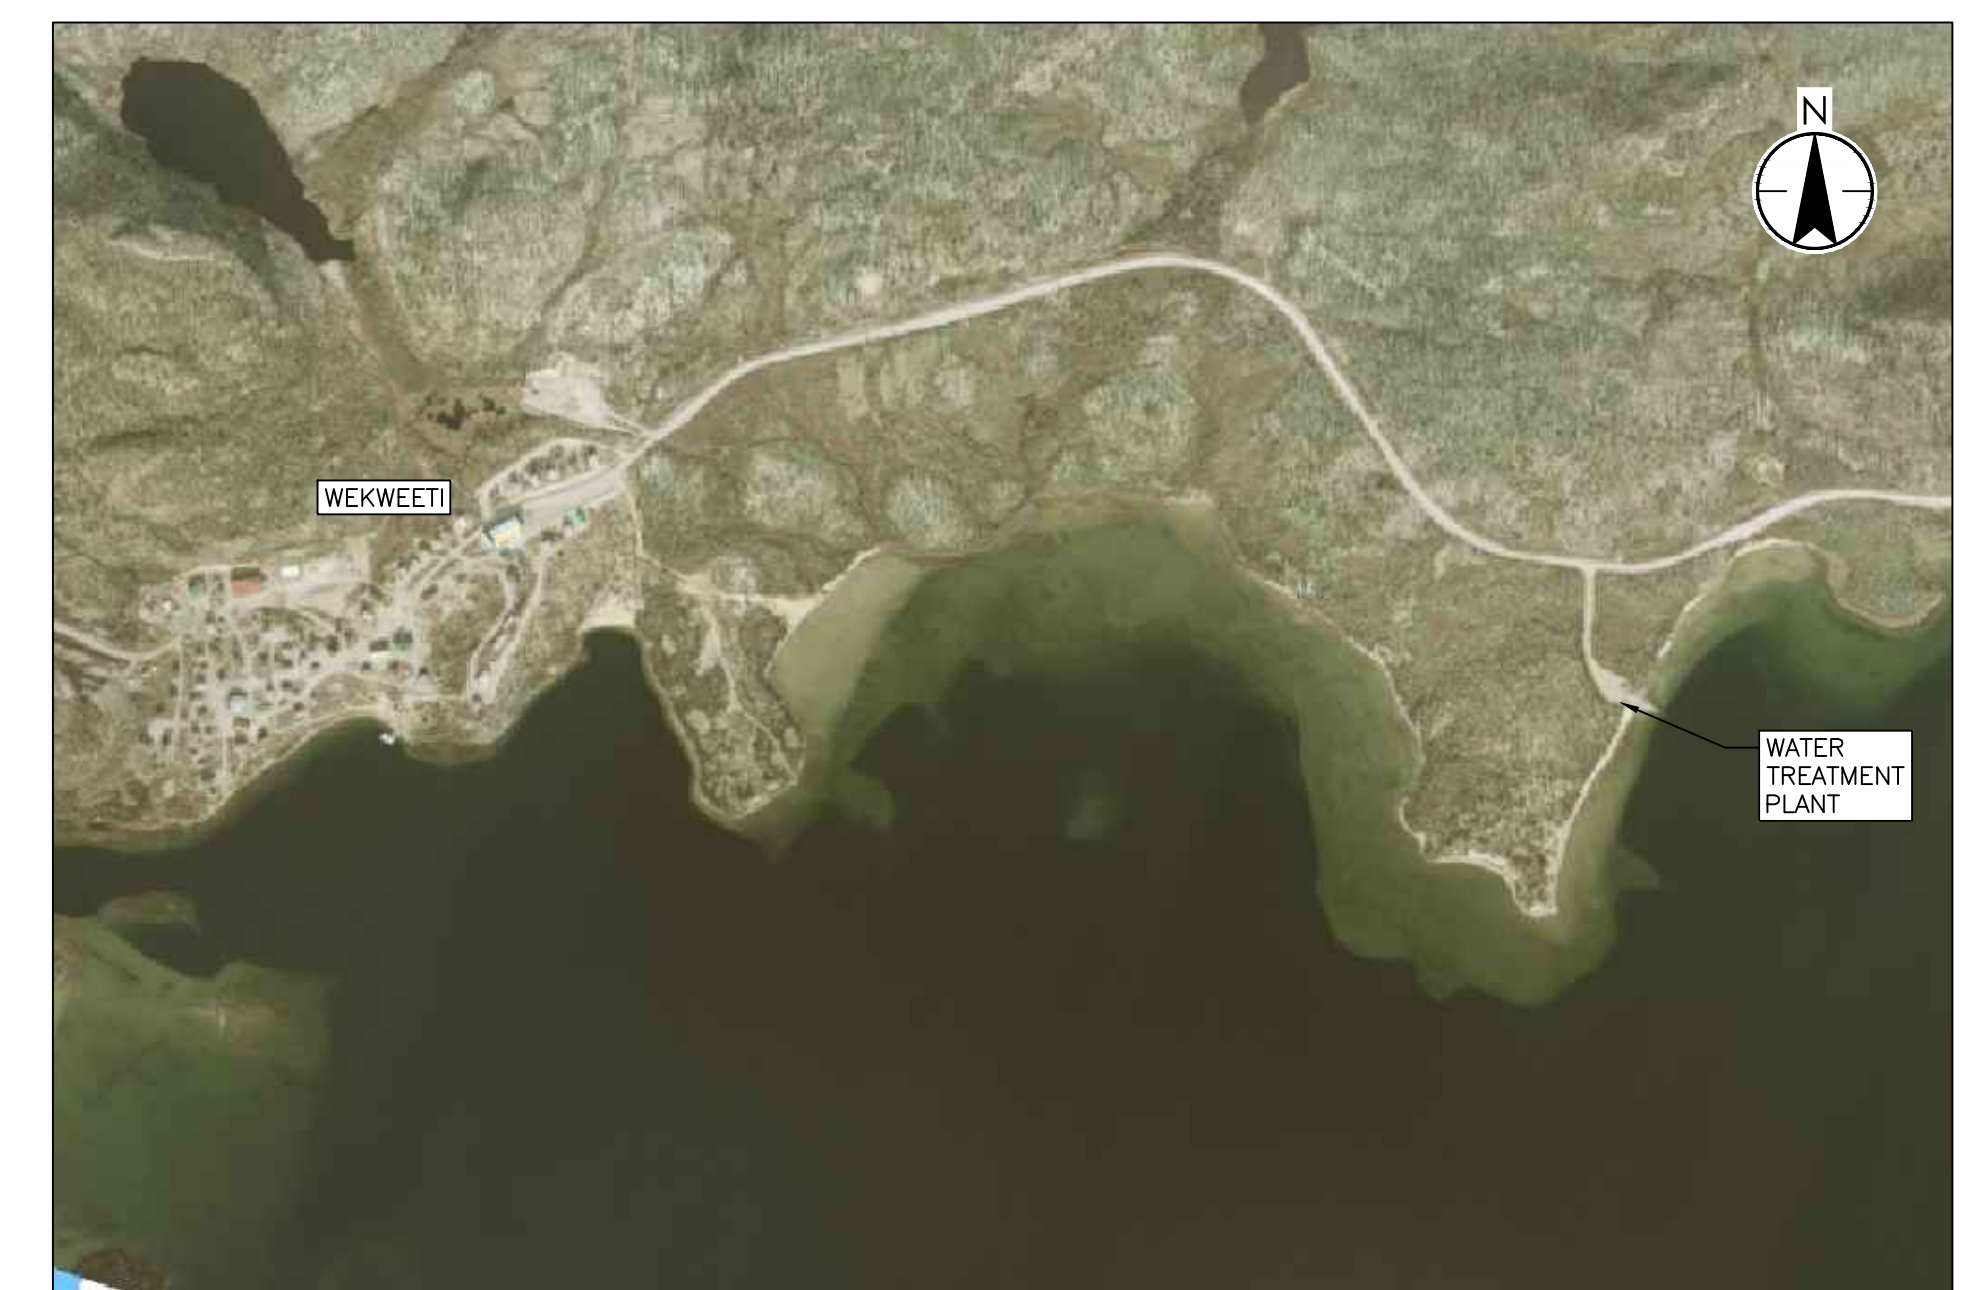


V:\1449 Active\144902412\04_drawing\c-101\04-101-Wekweeti.dwg
PLOT DATE: 2018.09.11 14:07:00 User: Logan Leung, Nelson

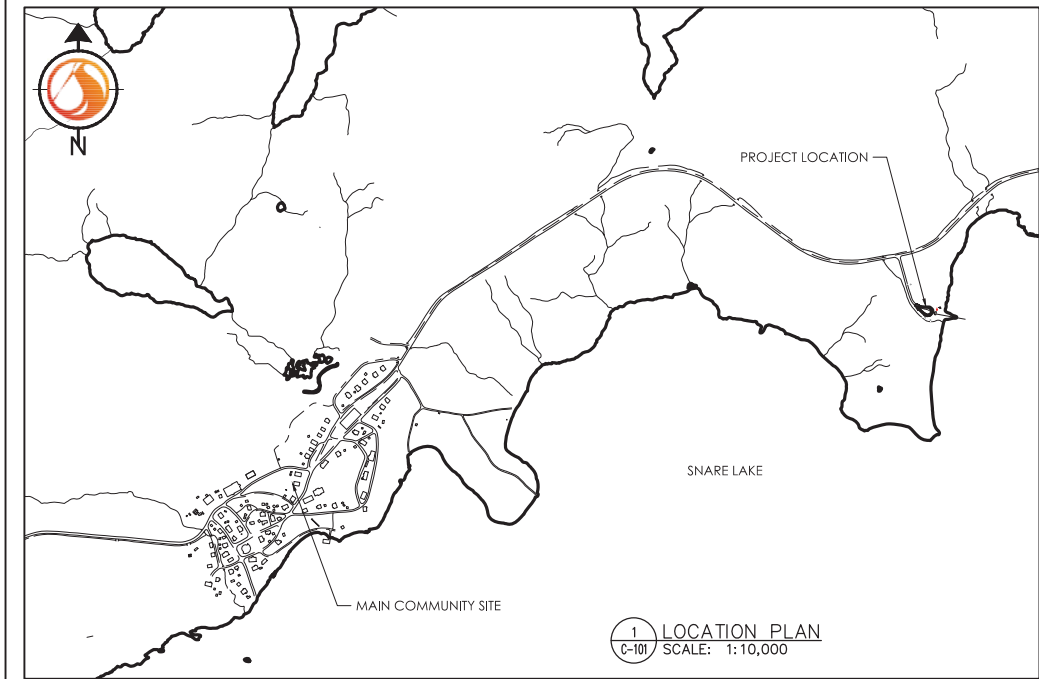


3 PHOTO #01 EXISTING WTP
C-101 SCALE: NTS



4 PHOTO #02 TURNAROUND PAD EXPANSION AREA
C-101 SCALE: NTS

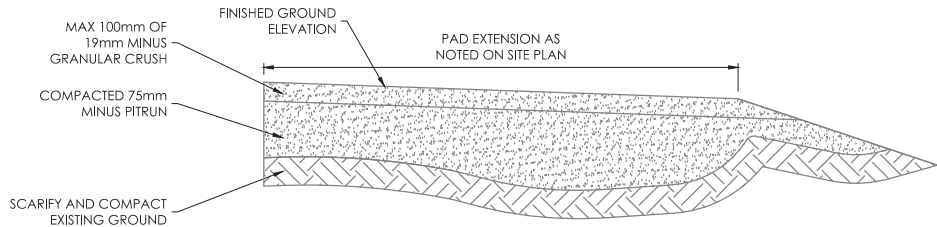

5 TURN AROUND STRUCTURE
C-101 SCALE: NTS

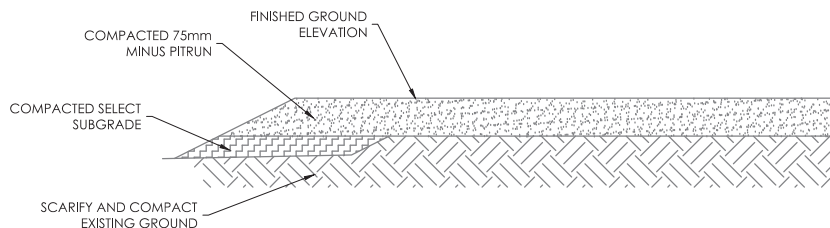

6 BUILDING PAD STRUCTURE
C-101 SCALE: NTS

STANTEC ARCHITECTURE LTD.
4910 53rd St
Yellowknife, NT, Canada X1A 2P4
Tel. 867.920.2882
www.stantec.com

Copyright Reserved

The Contractor shall verify and be responsible for all dimensions. DO NOT scale the drawing - any errors or omissions shall be reported to Stantec without delay.
The Copyrights to all designs and drawings are the property of Stantec. Reproduction or use for any purpose other than that authorized by Stantec is forbidden.

HORIZONTAL DATUM NOTE
PROJECTION: UNIVERSAL TRANSVERSE MERCATOR
GAMER: UTM ZONE 11 | PAULATUK: UTM ZONE 10 | WEKWEETI: UTM ZONE 11
DATUM: NAD 83 (CSRS 2002.0)

VERTICAL DATUM NOTE
ELEVATIONS ARE APPROXIMATE ONLY AND ARE DERIVED FROM CONTOURS PROVIDED BY MUNICIPAL AND COMMUNITY AFFAIRS (MCA) OF THE GNWT THROUGH THEIR PUBLIC GE WEBSITE: <http://orla.kanad.gov.nt.ca/Website/index.asp>


Legend

➔ FLOW ARROW

Notes

C	ISSUED FOR CONSTRUCTION	NL	AF	18.09.11
B	ISSUED FOR 100% REVIEW	NL	AF	18.07.13
A	ISSUED FOR 70% REVIEW	JD	AF	18.03.13
Issued		By	Appd.	YY.MM.DD

Permit-Seal

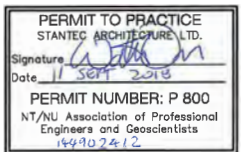


Client/Project

GOVERNMENT OF THE
NORTHWEST TERRITORIES
BUNDLED WATER TREATMENT PLANT

Wekweeti, NT

Title
SITE PLAN

Project No.	Scale
144902412	AS NOTED
Drawing No.	Sheet
C-101	1 of 3
	Revision
	C/

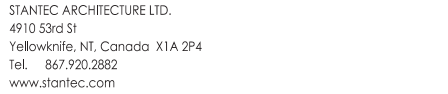

The Contractor shall verify and be responsible for all dimensions. DO NOT scale the drawing - any errors or omissions shall be reported to Stantec without delay.

The Copyrights to all designs and drawings are the property of Stantec. Reproduction or use for any purpose other than that authorized by Stantec is forbidden.

VERTICAL DATUM NOTE
ELEVATIONS ARE APPROXIMATE ONLY AND ARE DERIVED FROM CONTOURS PROVIDED BY MUNICIPAL AND COMMUNITY AFFAIRS (MACA) OF THE GNWT THROUGH THEIR PUBLIC GIS WEBSITE: <http://atlas.lands.gov.nt.ca/Website/index.asp>

Notes

C	ISSUED FOR CONSTRUCTION	NL	AF	18.09.11
B	ISSUED FOR 100% REVIEW	NL	AF	18.07.13
A	ISSUED FOR 70% REVIEW	JD	AF	18.03.13
Issued		By	Appd.	YY.MM.DD

PERMIT TO PRACTICE
STANTEC ARCHITECTURE LTD.
 Signature [Signature]
 Date 11 Sept 2018
PERMIT NUMBER: P 800
 NT/NU Association of Professional
 Engineers and Geoscientists
184902412




Title
DETAILS

C-501

2 of 3

C/

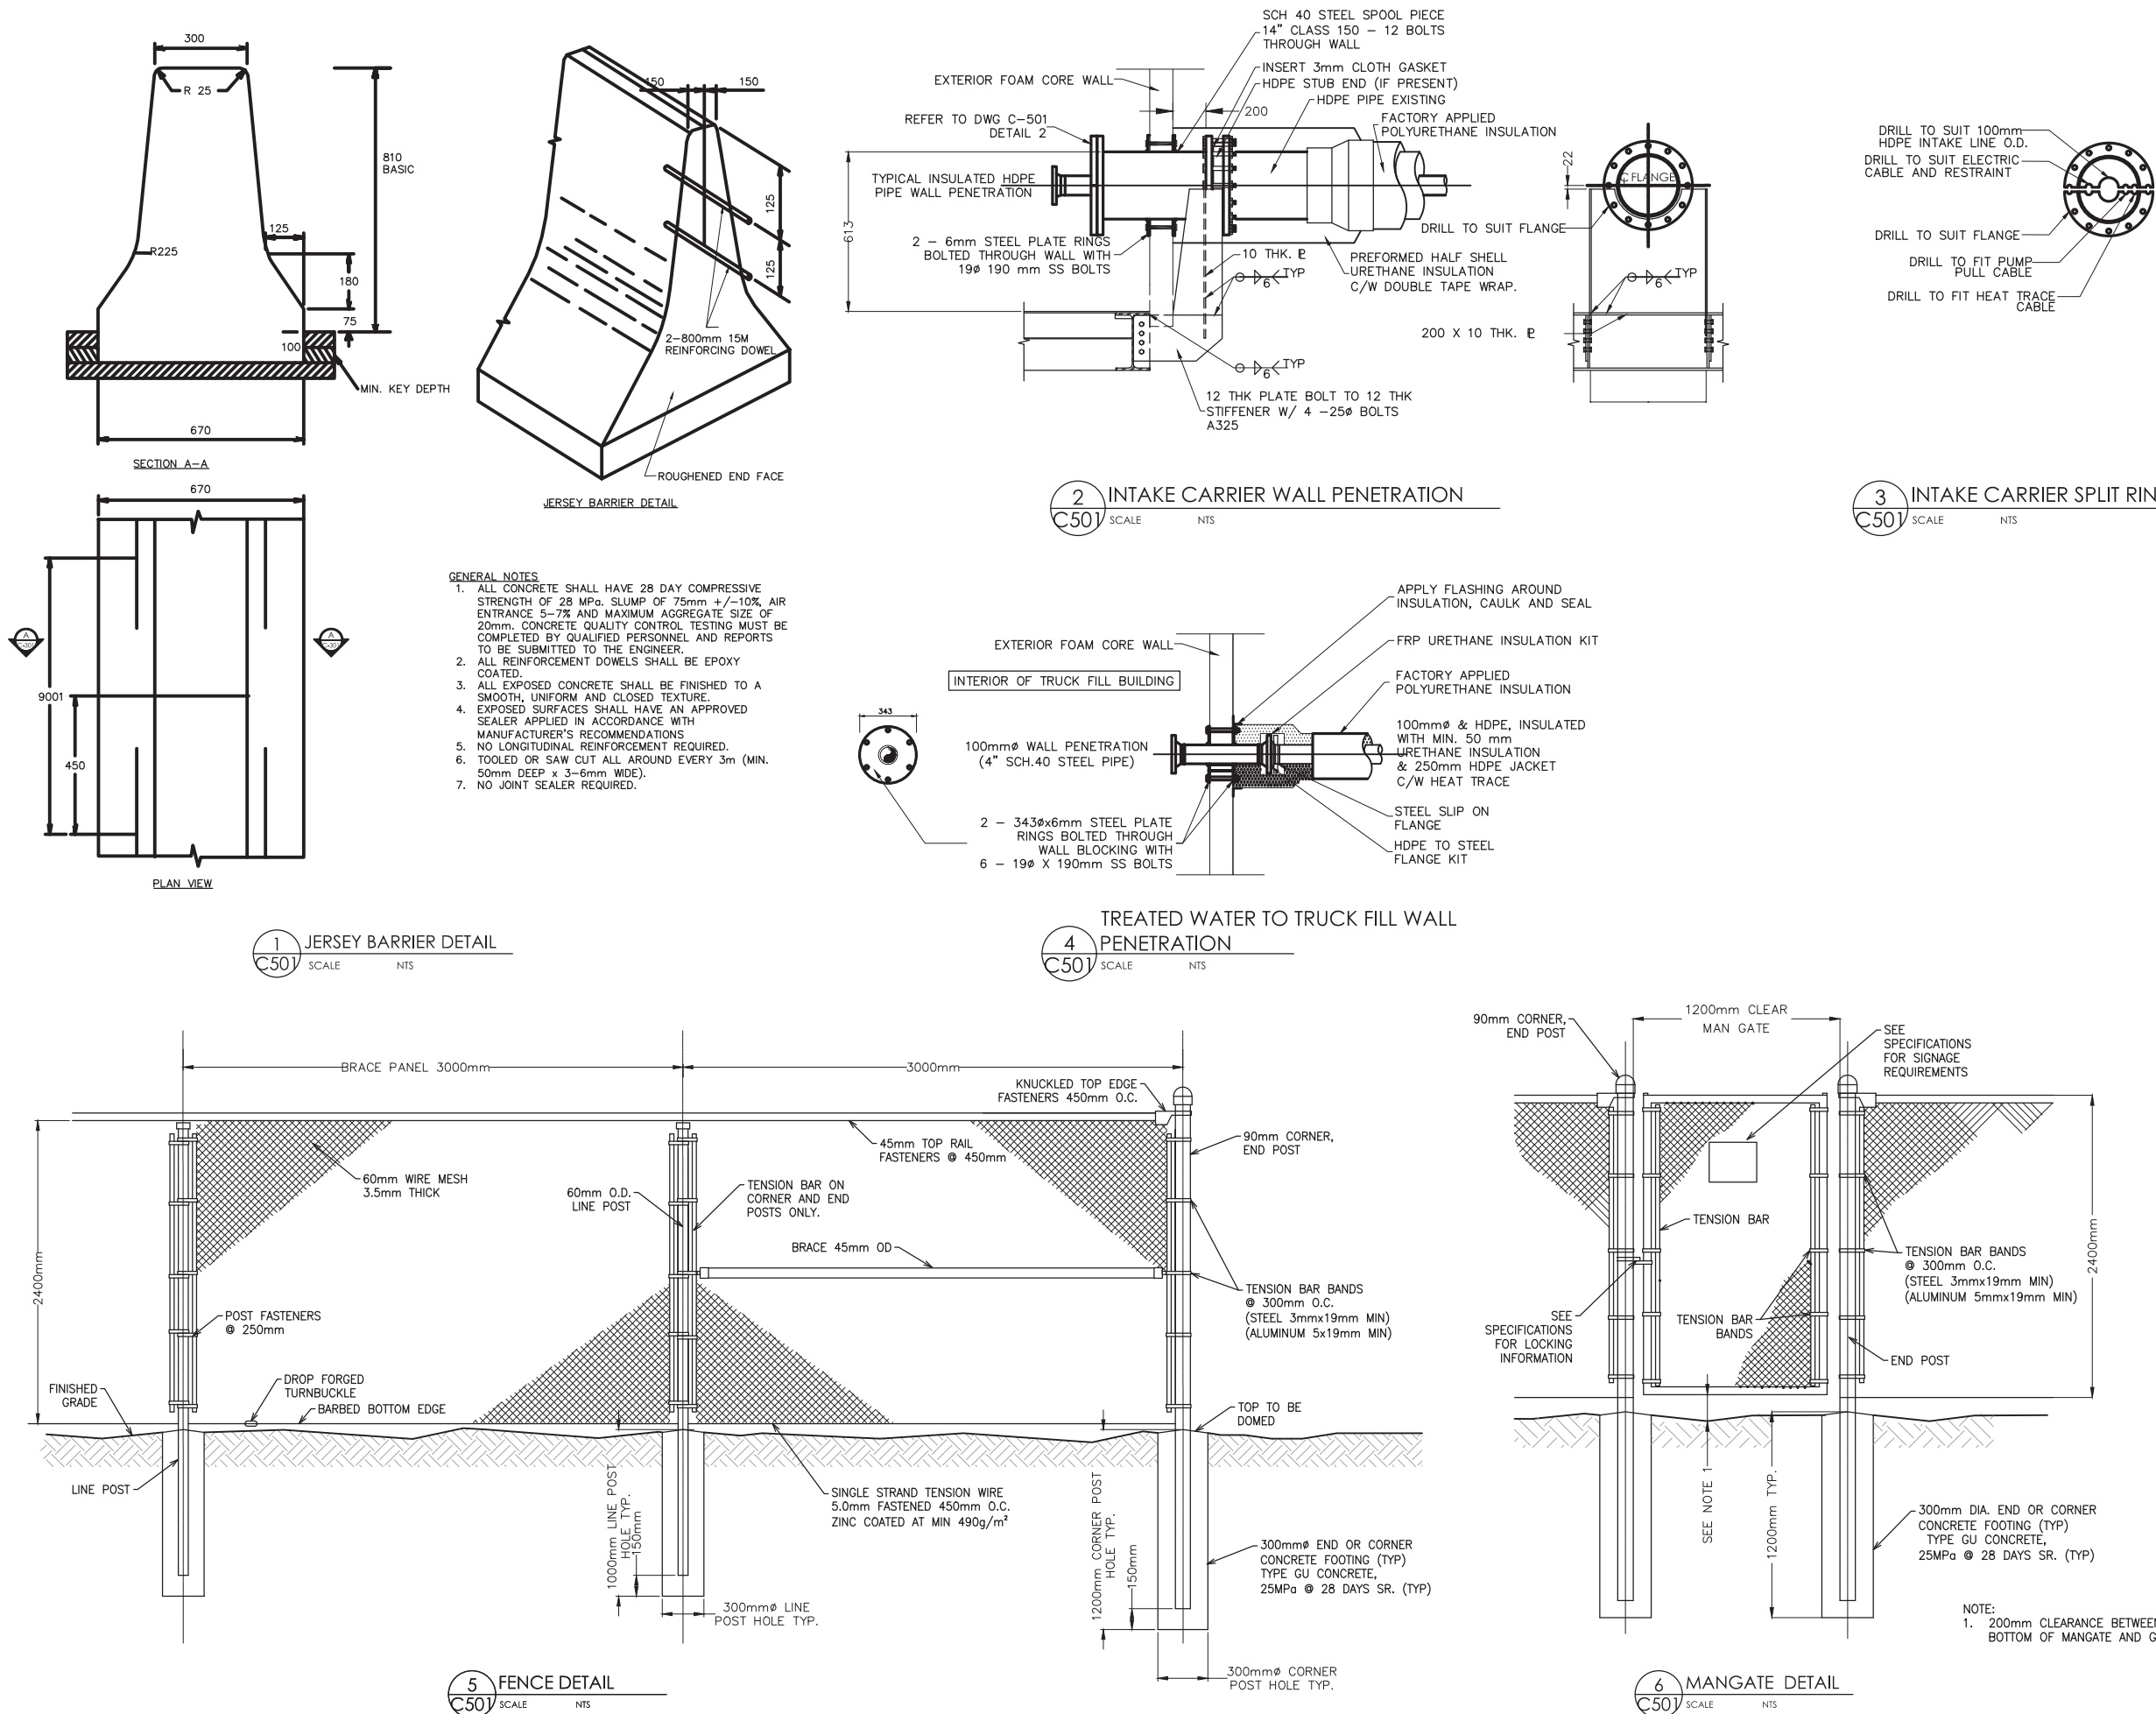

V:\449\Active\1449024\2\06_drawings\civil\024\25-501-Wekweeli.dwg
 PlotDate: 2018.mm.11 1:48 PM Login: Luong, Nelson

ORIGINAL SHEET • ANSI D

Copyright Reserved

The Contractor shall verify and be responsible for all dimensions. DO NOT scale the drawing - any errors or omissions shall be reported to Stantec without delay.
The Copyrights to all designs and drawings are the property of Stantec. Reproduction or use for any purpose other than that authorized by Stantec is forbidden.

HORIZONTAL DATUM NOTE
PROJECTION: UNIVERSAL TRANSVERSE MERCATOR
GAMER UTM ZONE 11 | PAULATUK UTM ZONE 10 | WEKWEET UTM ZONE 11
DATUM: NAD 83 (CSRS 2002.0)


VERTICAL DATUM NOTE
ELEVATIONS ARE APPROXIMATE ONLY AND ARE DERIVED FROM CONTOURS PROVIDED BY MUNICIPAL AND COMMUNITY AFFAIRS (M/C/A) OF THE GNWT THROUGH THEIR PUBLIC GIS WEBSITE: <http://gis.kanad.gov.nt.ca/Website/index.asp>

Legend

Notes

C	ISSUED FOR CONSTRUCTION	NL	AF	18.09.11
B	ISSUED FOR 100% REVIEW	NL	AF	18.07.13
A	ISSUED FOR 70% REVIEW	JD	AF	18.03.13
Issued		By	Appd.	YY/MM/DD

Permit-Seal

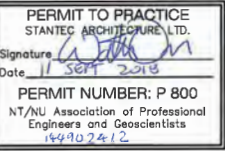

Client/Project



GOVERNMENT OF THE
NORTHWEST TERRITORIES

BUNDLED WATER TREATMENT PLANT

Wekweeti, NT


Title
DETAILS

Project No. 144902412	Scale AS NOTED
Drawing No. C-502	Sheet 3 of 3
	Revision C/

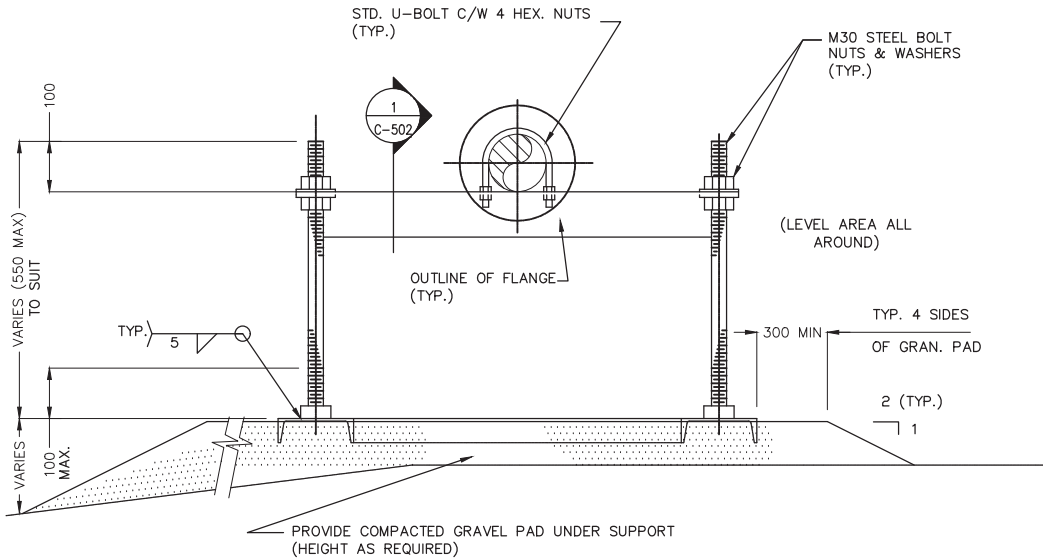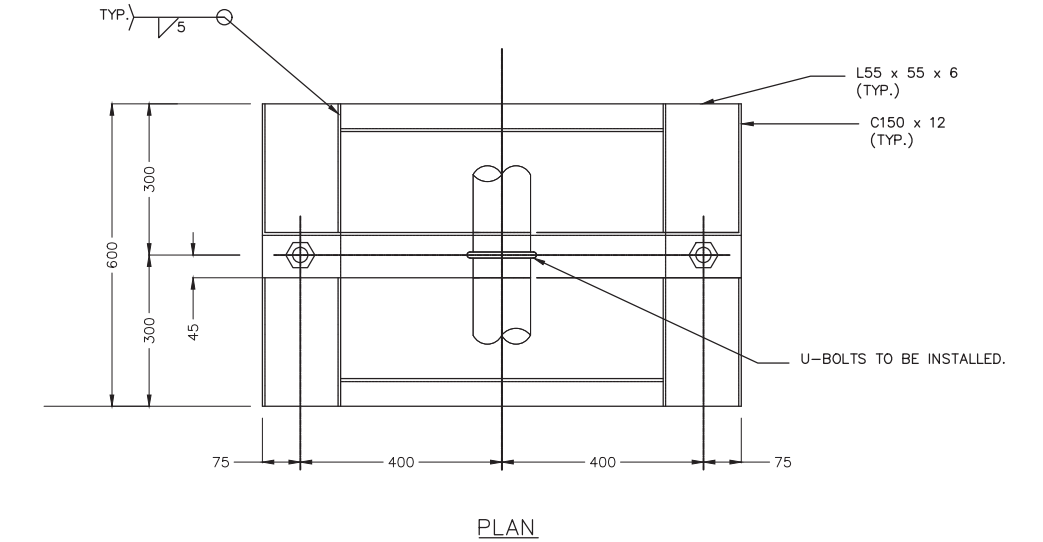


NOTE:
FOR SLOPING GROUND USE 2:1
FINISH SLOPE AT SIDES OF
GRAVEL PAD (TYP.)

ELEVATION

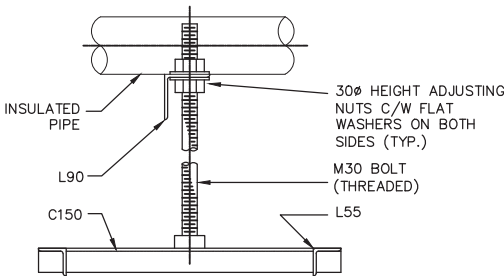


SECTION

1 TYPICAL PIPE SUPPORT - TYPE 1
C502 SCALE 1:7.50

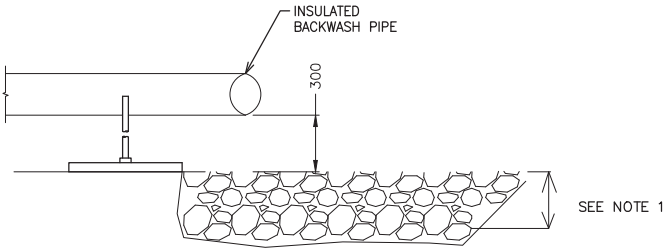


SECTION

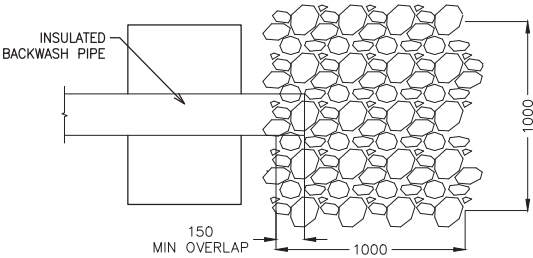


PLAN

2 TYPICAL RIPRAP DETAIL
C502 SCALE 1:20

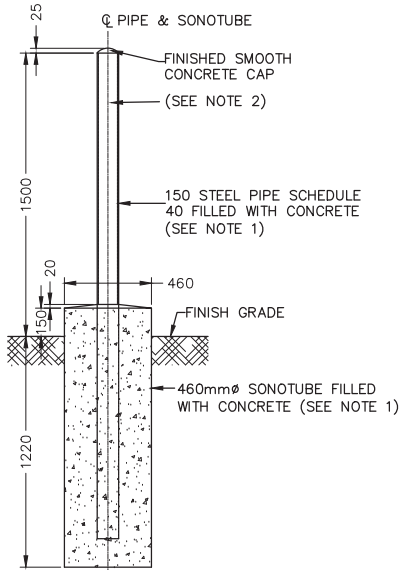


NOTES:
1. ALL CONCRETE SHALL HAVE 28 DAY COMPRESSIVE STRENGTH OF 25 MPa. SLUMP OF 75 mm+/-10%, AIR ENTRANCE 5-7% AND MAXIMUM AGGREGATE SIZE OF 20mm.
2. BOLLARD TO BE PAINTED YELLOW.

3 TYPICAL BOLLARD DETAIL
C502 SCALE 1:20

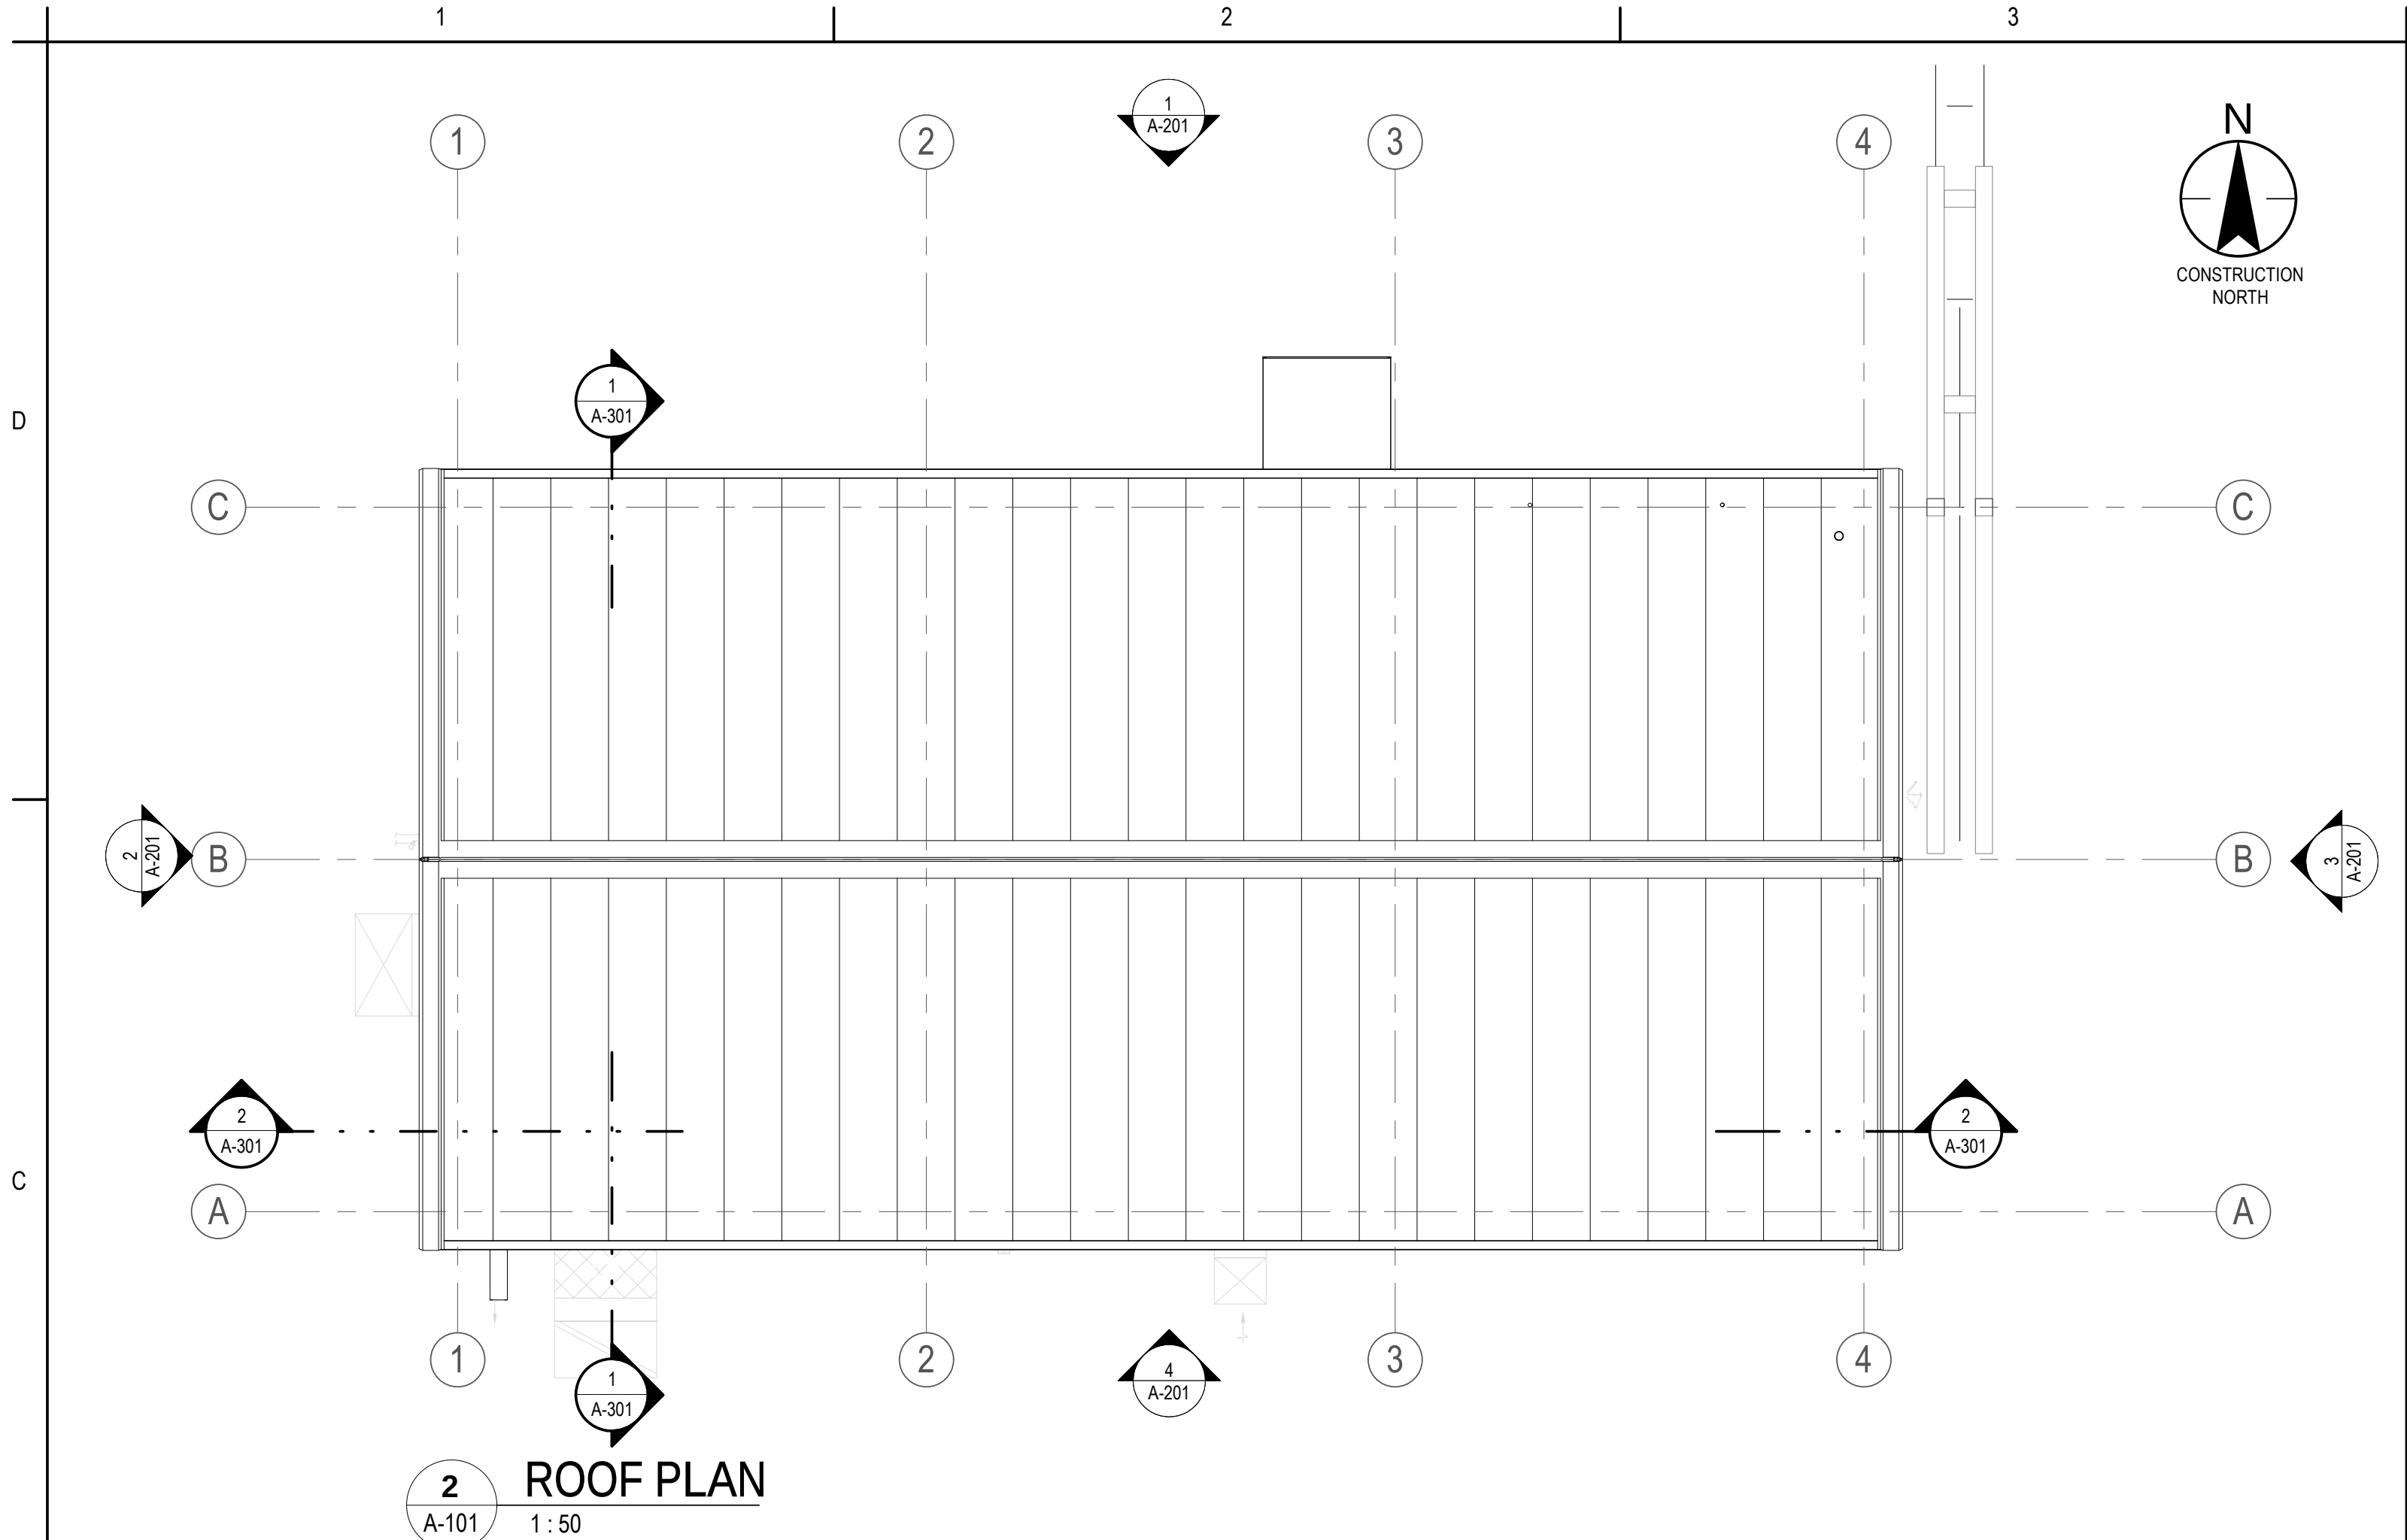

2 ROOF PLAN
A-101 1:50

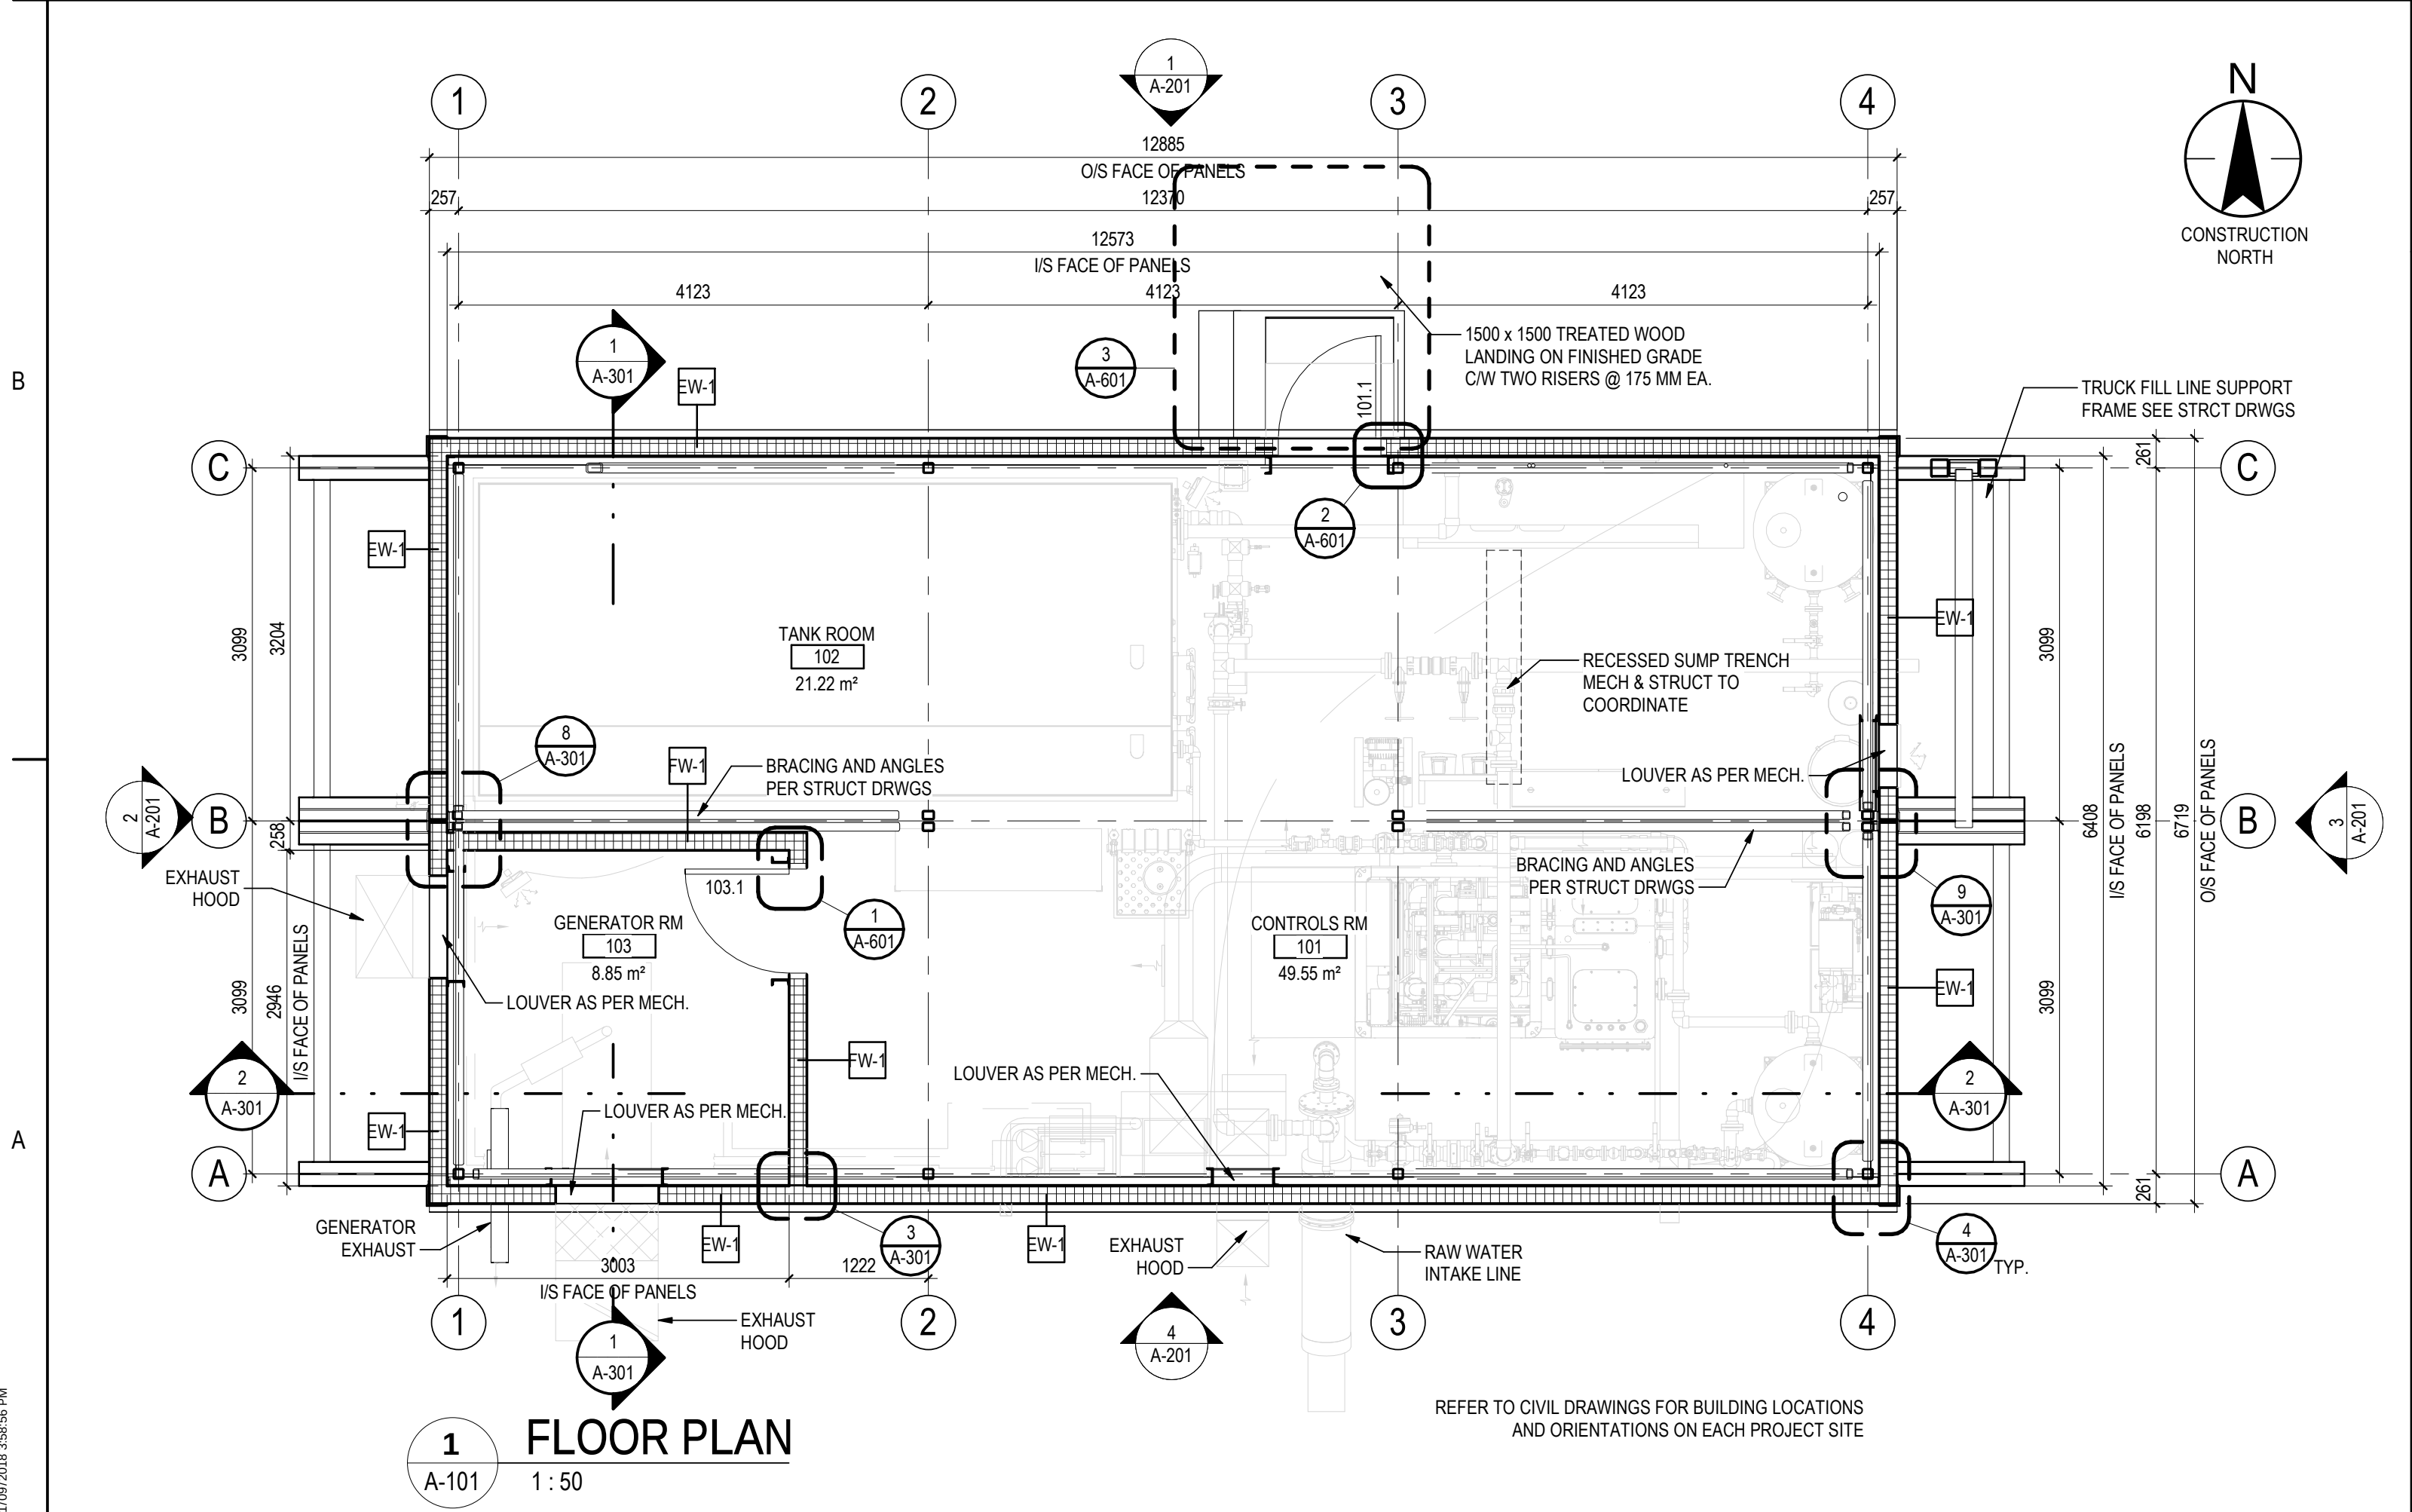

1 FLOOR PLAN
A-101 1:50

REFER TO CIVIL DRAWINGS FOR BUILDING LOCATIONS AND ORIENTATIONS ON EACH PROJECT SITE

BUILDING CODE SUMMARY					
ITEM	DESCRIPTION				Article NBCC
01	BASIS FOR CODE ANALYSIS				Division B – Part 3
02	PROJECT DESCRIPTION				
03	BUILDING OCCUPANCY				1.3.3.2.1a)ii)
04	BUILDING CODE SUMMARY LIMITATIONS				A-1.4.1.2. A-1.4.1.2. A-1.4.1.2.
05	DIVISION A PART 3: COMPLIANCE				1.1.1.1. & 1.3.2.1. 1.1.1.1. & 1.3.3.1.
06	DIVISION B PART 1: GENERAL				1.1.3. 1.1.4.
07	BUILDING CLASSIFICATION				3.2.2.89. 3.2.2.89.2)
08	OCCUPANT LOAD CALCULATIONS				
09	REQUIRED FIRE RESISTANCE RATING				3.6.2.8.
10	SPATIAL SEPARATION AND EXPOSURE PROTECTION				3.2.3.1.
11	HEALTH REQUIREMENTS AND ACCESSIBILITY				3.8

GENERAL NOTES

- ALL CONSTRUCTION MUST MEET OR EXCEED THE REQUIREMENTS OF THE NATIONAL BUILDING CODE OF CANADA 2015.
- ARCHITECTURAL DRAWINGS TO BE READ IN CONJUNCTION WITH CIVIL, STRUCTURAL, PROCESSING, MECHANICAL AND ELECTRICAL DRAWINGS.
- ALL WORK TO BE PERFORMED IN ACCORDANCE WITH GOOD BUILDING PRACTICES. CONTRACTOR TO CAREFULLY INSPECT THE SITE OF WORK AND BE FULLY INFORMED OF CONDITIONS AND LIMITATIONS. CONTRACTOR WILL ACCEPT THE SITE AS IS, AND THEREFORE, ASSUME ALL COST RELATED TO THE SCOPE OF WORK REQUIRED BY THE CONTRACT DOCUMENTS.
- CONTRACTOR TO CONFIRM ALL DIMENSIONS ON SITE AND IMMEDIATELY REPORT ANY DISCREPANCIES TO THE DESIGN TEAM PRIOR TO PROCEEDING.
- CONFIRM ALL ELEVATIONS ON SITE. REPORT ANY VARIANCES TO THE DESIGN TEAM PRIOR TO PROCEEDING.
- PROVIDE MINIMUM 2% SLOPE AWAY FROM THE BUILDING FOR ALL EXTERIOR GRADING U.N.O. OR DICTATED BY EXIST. SITE CONDITIONS. CONFIRM WITH THE DESIGN TEAM PRIOR TO PROCEEDING.
- WALLS NOT LOCATED BY DIMENSIONS ARE ASSUMED TO BE CENTERED ON GRID LINES. ALL WALL DIMENSIONS ARE FROM FACE OF PANEL U.N.O.
- DOOR SIZES ARE NOMINAL. CONTRACTOR TO CONSULT SUPPLIER FOR EXACT SIZES AND ROUGH OPENINGS.
- WHERE PROCESSING PIPES, MECHANICAL DUCTS AND ELECTRICAL CONDUIT PENETRATE FIRE SEPARATIONS OR WALLS WHICH ARE CONSTRUCTED TO U.S OF STRUCTURE, PROVIDE FIRESTOPPING AND SMOKE SEALS AT PENETRATIONS TO MAINTAIN FRR NOTED ON PARTITION TYPES SCHEDULE.
- ALL ELEVATIONS TO BE VERIFIED BY CONTRACTOR AND TO COORDINATE LOCATIONS OF ALL PROCESSING, MECHANICAL AND ELECTRICAL EQUIPMENT PRIOR TO ROUGH-IN AND INSTALLATION.
- WHEN INSTALLING PLUMBING, INSTALL GASKETS AT ALL SUPPORT CONNECTIONS. PIPES MUST NOT COME INTO DIRECT CONTACT WITH INSULATED METAL PANELS.
- PROVIDE SECONDARY STEEL FRAMING AROUND DOORS AND OPENINGS. SECONDARY FRAMING SHALL TIE INTO PRIMARY STRUCTURE ROOF AND FLOOR FRAMING AND RIGIDLY SUPPORT THE INSULATED BUILDING PANELS. OPENINGS SMALLER THAN 400MM WIDE MAY NOT REQUIRE SECONDARY FRAMING UNLESS RECOMMENDED BY BUILDING ENVELOPE SUPPLIER.
- PROVIDE ALL FRAMING / BLOCKING AS REQUIRED TO ENSURE PROPER SECUREMENT OF ALL MATERIALS, EQUIPMENTS, ACCESSORIES, ETC. PROVIDE BACKING FOR ITEMS.
- PROVIDE FLASHING OVER EXTERIOR DOOR. FLASHING TO BE PREFINISHED TO SUIT COLOUR SCHEME.
- MAINTAIN INTEGRITY OF THE AIR BARRIER/ VAPOUR MEMBRANE ON THE EXTERIOR WALLS AND ROOF STRUCTURE.
- PROVIDE CONTINUOUS ROD AND SEALANT AT ALL JUNCTIONS OF DISSIMILAR MATERIALS, CONTROL JOINTS AND OTHER LOCATIONS INDICATED.
- IN THE EVENT OF CONFLICT, SPECIFICATIONS SHALL TAKE PRECEDENCE OVER GENERAL CONSTRUCTION NOTES.
- REFER TO PROCESSING AND MECHANICAL DRAWINGS FOR SIZE AND LOCATION OF DRAINS, STANDPIPES, INTAKE & EXHAUST LOUVERS, GRILLES, SMOKE & FIRE DAMPERS & ALL RELATED MECHANICAL EQUIPMENT.
- MAINTAIN SAFE ACCESS TO ALL REQUIRED EXITS AT ALL TIMES.
- DO NOT SCALE THE DRAWINGS.

CONSTRUCTION ASSEMBLIES

- IMPS = INSULATED METAL PANELS
- RT-1 R-49 / RSI 8.62
152MM SR2 STANDING SEAM INSULATED (POLYISOCYANURATE FOAM) 24ga INTEGRATED LOCKING AND DOUBLE SEALING JOINTS METAL PANELS BY AIWPI ANCHORED TO STRUCTURAL ROOF BEAMS AND PURLINS AS PER PANEL MANUFACTURERS RECOMMENDATIONS FOR CONCEALED FASTENERS PREFINISHED RIDGE CAP, RAKED FASCIA AND GUTTERLESS EAVES
- EW-1 R-49 / RSI 8.62
152 MM DM40 MESA INSULATED (POLYISOCYANURATE FOAM) 24ga INTEGRATED LOCKING AND DOUBLE SEALING JOINTS METAL PANELS BY AIWPI ANCHORED TO PERIMETER STRUCTURAL ROOF AND FLOOR BEAMS AS PER PANEL MANUFACTURERS RECOMMENDATIONS FOR CONCEALED FASTENERS PREFINISHED INTERIOR & EXTERIOR TRIM FOR INTERMEDIATE AND CORNER PANEL TRANSITIONS
- FW-1 R-22 / RSI 3.87 - 2hr FRR
152 MM PL42-MF 2HR FIRE RATED INSULATED (MINERAL WOOL) 26ga METAL PANELS BY AIWPI CONNECTED TO FLOOR, ROOF AND INTERSECTION INSULATED METAL PANELS AS PER PANEL MANUFACTURERS RECOMMENDATIONS FOR CONCEALED FASTENERS PREFINISHED INTERIOR & EXTERIOR TRIM FOR INTERMEDIATE AND CORNER PANEL TRANSITIONS
- FL-1 R-40 / RSI 7.0
4.7MM THK 304 STAINLESS STEEL PLATE OR ALGRIP SLIP-RESISTANT FLOOR PLATE ON STRUCTURAL FLOOR JOISTS AND BEAMS FLUID-APPLIED INSULATION (THERMAL BREAK) COATING TO BE APPLIED TO SKID BEAMS 152 MM SPRAY APPLIED FOAM INSULATION/AIR BARRIER
- DK-1
32 x 140 x 1500 PRESSURE TREATED DECKING AND TREAD ON 4 - 38 x 235 PRESSURE TREATED STRINGERS NOTCHED FOR TREAD 4 - 38 x 140 PRESSURE TREATED PLANKS ON FINISHED GRADE



Stantec Architecture Ltd.
2nd Floor 4910 53 Street
PO Box 1777
Yellowknife, NT X1A 2P4
Tel: (867) 920-2882 • www.stantec.com

Copyright Reserved

The Contractor shall verify and be responsible for all dimensions. DO NOT scale the drawing - any errors or omissions shall be reported to Stantec without delay. The Copyrights to all designs and drawings are the property of Stantec. Reproduction or use for any purpose other than that authorized by Stantec is forbidden.

Consultant

Notes

- DO NOT SCALE DRAWINGS.
- ALL DIMENSIONS IN MILLIMETERS UNLESS OTHERWISE NOTED.
- CONTRACTOR IS TO COORDINATE WITH STRUCTURAL, MECHANICAL, ELECTRICAL, CIVIL, PROCESS AND CONTROLS DRAWINGS BEFORE CONSTRUCTION.
- CONTRACTOR IS TO REPORT IMMEDIATELY TO THE ARCHITECT IF ANY ERRORS OR DISCREPANCIES ARE FOUND ON THE DRAWING.
- FLUID APPLIED MEMBRANE TO BE APPLIED TO LENGTHS OF STRUCTURAL BEAMS AND STEEL ANGLES TO ACT AS THERMAL BREAK.

BUILDING ENVELOPE DRAWING INDEX

NO.	DRAWING NAME
WEKWEETI	
A-101	BUILDING ENVELOPE - GENERAL NOTES, BUILDING CODE SUMMARY, FLOOR AND ROOF PLANS
A-201	BUILDING ENVELOPE - EXTERIOR BUILDING ELEVATIONS, EXTERIOR AND INTERIOR ROOM FINISH SCHEDULES
A-301	BUILDING ENVELOPE - BUILDING SECTIONS AND DETAILS
A-601	BUILDING ENVELOPE - DOOR, FRAME AND HARDWARE SCHEDULE, SECTIONS AND DETAILS

Revision	By	Appd	YYYY.MM.DD
-			
-			
C ISSUED FOR CONSTRUCTION	S.M.	A.F.	18.08.11
B ISSUED FOR 100% REVIEW	C.E.	A.F.	18.07.13
A ISSUED FOR 70% REVIEW	C.E.	A.F.	18.03.13
Issued	By	Appd	YYYY.MM.DD
File Name: N/A	S.M./C.E. Dwn.	C.E. Dsgn.	- Chkd.
			2018.04.13
			YYYY.MM.DD

Permit/Seal



Client/Project Logo



Client/Project
GOVERNMENT OF NORTHWEST TERRITORIES

BUNDLED WATER TREATMENT PLANT

Title		Scale	
BUILDING ENVELOPE - GENERAL NOTES, BUILDING CODE SUMMARY, FLOOR AND ROOF PLANS		As indicated	
Project No.	144902412	Revision	Sheet
Revision	Sheet	Drawing No.	A-101



Copyright Reserved

The Contractor shall verify and be responsible for all dimensions. DO NOT scale the drawing - any errors or omissions shall be reported to Stantec without delay.

The Copyrights to all designs and drawings are the property of Stantec. Reproduction or use for any purpose other than that authorized by Stantec is forbidden.

Consultant

EXTERIOR FINISH SCHEDULE	
ELEVATION TAG	WALLS, ROOF TRIM COLOUR
NORTH	ROYAL BLUE
EAST	ROYAL BLUE
SOUTH	ROYAL BLUE
WEST	ROYAL BLUE
ROOF AND WALL PANEL TRIM	
ROOF PANELS	EVERGREEN
RIDGE	EVERGREEN
FASCIA TRIM	EVERGREEN
EAVE TRIM	EVERGREEN
CORNER TRANSITION	EVERGREEN
WALL PANEL TRANSITION	ROYAL BLUE

INTERIOR FINISH SCHEDULE	
ROOM / No.	WALLS, CEILING & TRIM COLOUR
CONTROL ROOM 101 - 49.50 m2	
NORTH	IMPERIAL WHITE
EAST	IMPERIAL WHITE
SOUTH	IMPERIAL WHITE
WEST	IMPERIAL WHITE
CEILING	IMPERIAL WHITE
TANK ROOM 102 - 21.19 m2	
NORTH	IMPERIAL WHITE
EAST	IMPERIAL WHITE
SOUTH	IMPERIAL WHITE
CEILING	IMPERIAL WHITE
GENSET ROOM 103 - 8.84 m2	
NORTH	IMPERIAL WHITE
EAST	IMPERIAL WHITE
SOUTH	IMPERIAL WHITE
WEST	IMPERIAL WHITE
CEILING	IMPERIAL WHITE

Notes

1. DO NOT SCALE DRAWINGS.
2. ALL DIMENSIONS IN MILLIMETERS UNLESS OTHERWISE NOTED.
3. CONTRACTOR IS TO COORDINATE WITH STRUCTURAL, MECHANICAL, ELECTRICAL, CIVIL, PROCESS AND CONTROLS DRAWINGS BEFORE CONSTRUCTION.
4. CONTRACTOR IS TO REPORT IMMEDIATELY TO THE ARCHITECT IF ANY ERRORS OR DISCREPANCIES ARE FOUND ON THE DRAWING.
5. FLUID APPLIED MEMBRANE TO BE APPLIED TO LENGTHS OF STRUCTURAL BEAMS AND STEEL ANGLES TO ACT AS THERMAL BREAK.



Revision	By	App'd	YYYY.MM.DD
-			
-			
C ISSUED FOR CONSTRUCTION	S.M.	A.F.	18.09.11
B ISSUED FOR 100% REVIEW	C.E.	A.F.	18.07.13
A ISSUED FOR 70% REVIEW	C.E.	A.F.	18.03.13
Issued	By	App'd	YYYY.MM.DD
File Name: N/A	S.M./C.E.	C.E.	-
	Dwn	Dson	Chkd
			YYYY.MM.DD

Permit/Seal



Client/Project Logo



Client/Project
GOVERNMENT OF NORTHWEST TERRITORIES

BUNDLED WATER TREATMENT PLANT

Wekweeti. NT

Title
BUILDING ENVELOPE - EXTERIOR
BUILDING ELEVATIONS, EXTERIOR AND
INTERIOR ROOM FINISH SCHEDULES

Project No.	Scale
144902412	As indicated

Revision	Sheet	Drawing No.
----------	-------	-------------

A-201



The Contractor shall verify and be responsible for all dimensions. DO NOT scale the drawing - any errors or omissions shall be reported to Stantec without delay. The Copyrights to all designs and drawings are the property of Stantec. Reproduction or use for any purpose other than that authorized by Stantec is forbidden.

Notes

1. DO NOT SCALE DRAWINGS.
2. ALL DIMENSIONS IN MILLIMETERS UNLESS OTHERWISE NOTED.
3. CONTRACTOR IS TO COORDINATE WITH STRUCTURAL, MECHANICAL, ELECTRICAL, CIVIL, PROCESS AND CONTROLS DRAWINGS BEFORE CONSTRUCTION.
4. CONTRACTOR IS TO REPORT IMMEDIATELY TO THE ARCHITECT IF ANY ERRORS OR DISCREPANCIES ARE FOUND ON THE DRAWING.
5. FLUID APPLIED MEMBRANE TO BE APPLIED TO LENGTHS OF STRUCTURAL BEAMS AND STEEL ANGLES TO ACT AS THERMAL BREAK.



Issued	By	Appd	YYYY.MM.DD
File Name: N/A	S.M./C.E.	-	2018.04.13
	Dwn	Chld	YYYY.MM.DD

PERMIT TO PRACTICE
STANTEC ARCHITECTURE LTD.
Signature [Signature]
Date 11 SEPT 2018
PERMIT NUMBER: P 800
NT/NU Association of Professional
Engineers and Geoscientists
1466917412



Northwest Territories

BUNDLED WATER TREATMENT PLANT

Wekweeti, NT

Title
BUILDING ENVELOPE - BUILDING
SECTIONS AND DETAILS

Project No. _____

144902412

Revision Sheet


Scale

As indicated

Drawing No. _____

A-301



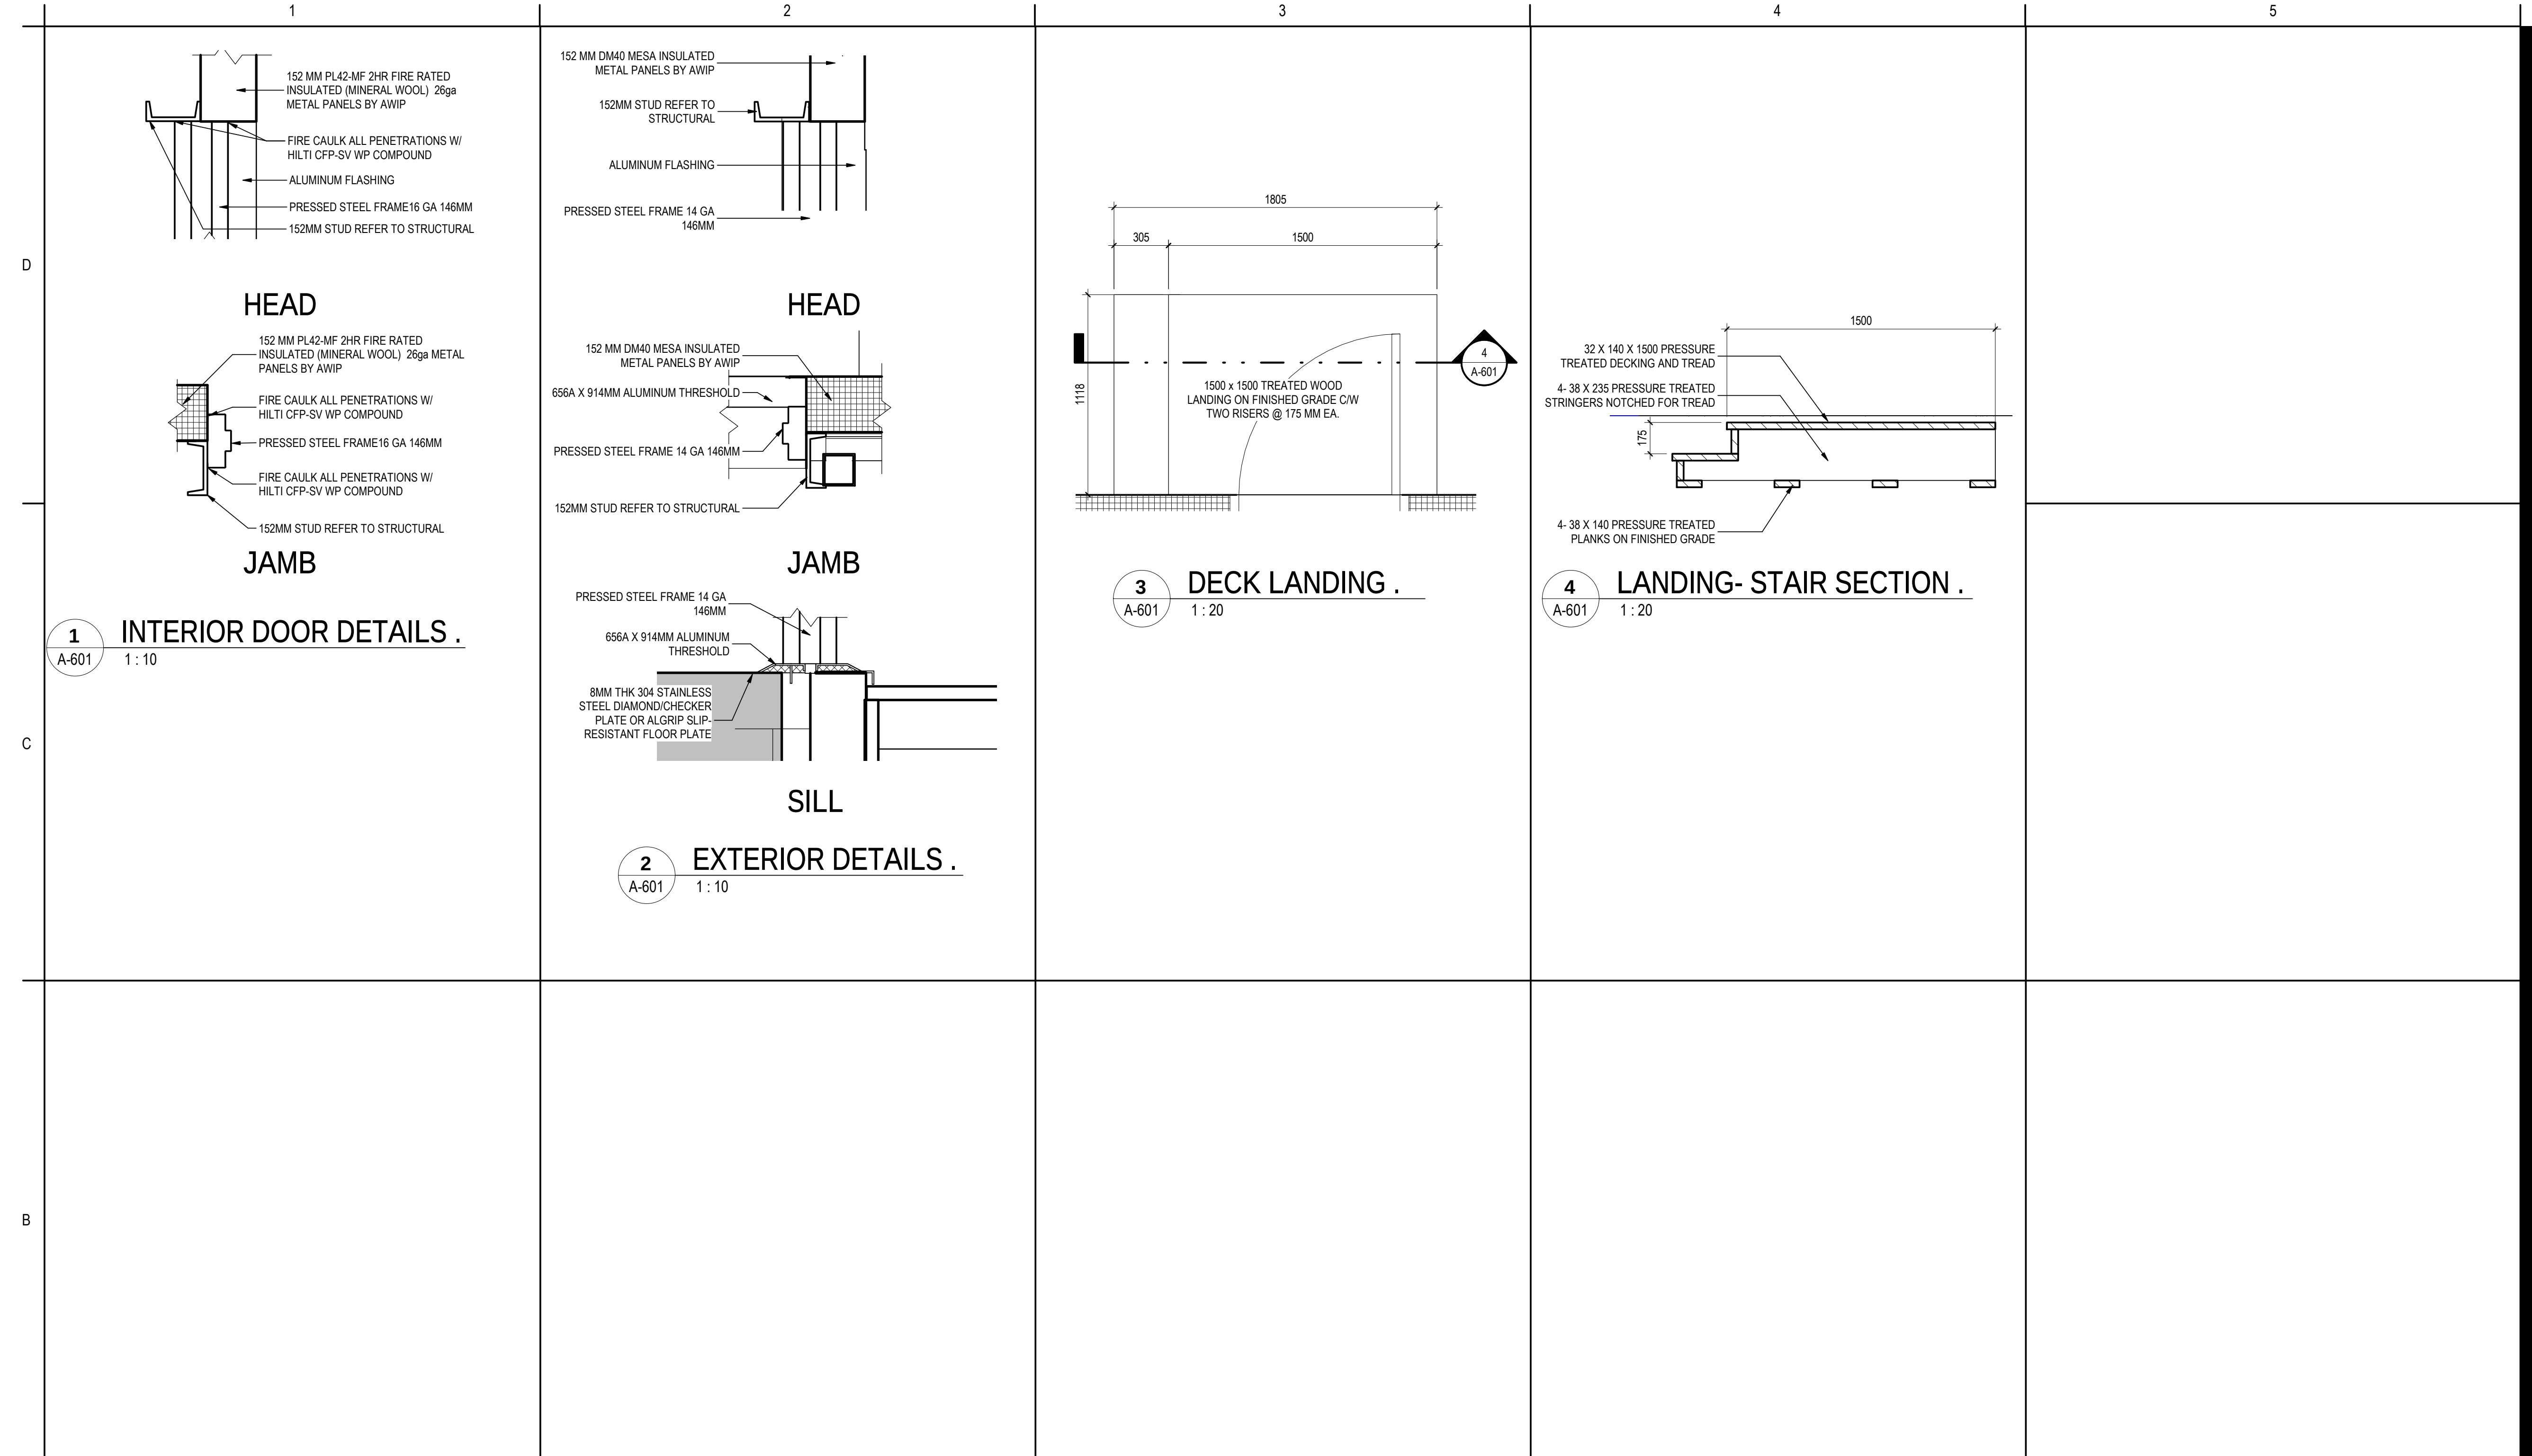

Copyright Reserved



The Contractor shall verify and be responsible for all dimensions. DO NOT scale the drawing - any errors or omissions shall be reported to Stantec without delay.

The Copyrights to all designs and drawings are the property of Stantec. Reproduction or use for any purpose other than that authorized by Stantec is forbidden.

Consultant

- Notes
- DO NOT SCALE DRAWINGS.
 - ALL DIMENSIONS IN MILLIMETERS UNLESS OTHERWISE NOTED.
 - CONTRACTOR IS TO COORDINATE WITH STRUCTURAL, MECHANICAL, ELECTRICAL, CIVIL, PROCESS AND CONTROLS DRAWINGS BEFORE CONSTRUCTION.
 - CONTRACTOR IS TO REPORT IMMEDIATELY TO THE ARCHITECT IF ANY ERRORS OR DISCREPANCIES ARE FOUND ON THE DRAWING.
 - FLUID APPLIED MEMBRANE TO BE APPLIED TO LENGTHS OF STRUCTURAL BEAMS AND STEEL ANGLES TO ACT AS THERMAL BREAK.

Revision	By	Appd	YYYY.MM.DD
-			
-			
C ISSUED FOR CONSTRUCTION	S.M.	A.F.	18.08.11
B ISSUED FOR 100% REVIEW	C.E.	A.F.	18.07.13
A ISSUED FOR 70% REVIEW	C.E.	A.F.	18.03.13
Issued	By	Appd	YYYY.MM.DD
File Name: N/A	S.M./C.E.	C.E.	-
	Dwn.	Dsgn.	Chkd.
			2018.04.13
			YYYY.MM.DD

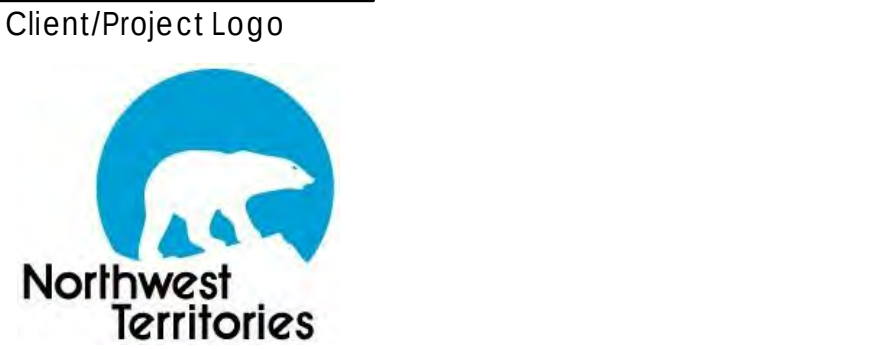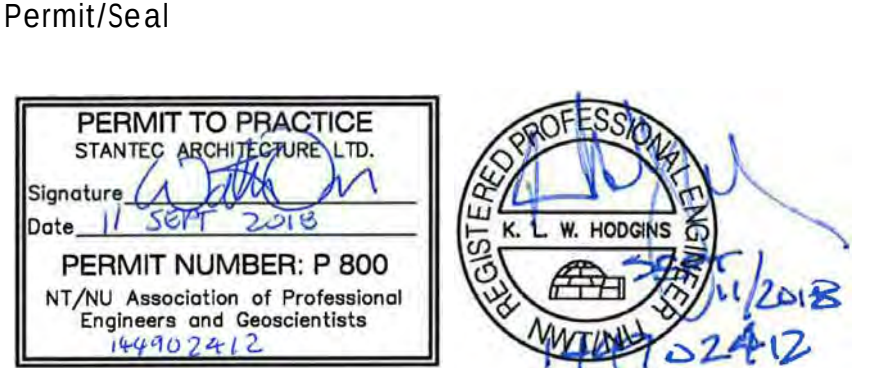

Client/Project

GOVERNMENT OF NORTHWEST TERRITORIES

BUNDLED WATER TREATMENT PLANT

Wekweeti, NT

Title

BUILDING ENVELOPE - DOOR, FRAME AND HARDWARE SCHEDULE, SECTIONS AND DEATILS

Project No. 144902412

Scale As indicated

Revision Sheet

Drawing No.

DESIGN NOTES

GENERAL

- ALL CODES REFERENCED ARE TO BE THE LATEST VERSION AT THE DATE OF ISSUE.
- DESIGN IS BASED ON THE NATIONAL BUILDING CODE 2015.
- READ THESE DESIGN NOTES IN CONJUNCTION WITH THE CONTRACT SPECIFICATIONS AND ALL OTHER CONTRACT DOCUMENTS.
- OBTAIN ENGINEER'S APPROVAL BEFORE CUTTING, BORING, OR SLEEVEING LOAD-BEARING MEMBERS UNLESS NOTED OTHERWISE.
- THE STRUCTURAL DRAWINGS ARE FOR THE COMPLETED PROJECT. STABILITY OF THE NEW STRUCTURE DURING CONSTRUCTION AND THE TRANSPORTATION REMAINS THE RESPONSIBILITY OF THE CONTRACTOR.
- REFER TO ARCHITECTURAL, MECHANICAL, AND ELECTRICAL DRAWINGS FOR SMALL OPENINGS, SLEEVES, RECESSES, DEPRESSIONS, SUMPS, TRENCHES, CURBS, HOUSEKEEPING PADS, EQUIPMENT BASES, AND SLOPES NOT INDICATED ON THE STRUCTURAL DRAWINGS.
- OPENINGS AND SLEEVES INDICATED ON THE STRUCTURAL DRAWINGS ARE FOR REFERENCE ONLY. COORDINATE ALL OPENING LOCATIONS AND DIMENSIONS WITH THE APPROPRIATE CONSULTANT AND THE SUB-CONTRACTOR PRIOR TO CONSTRUCTION.
- REVIEW ALL DRAWINGS AND CHECK DIMENSIONS PRIOR TO IMPLEMENTING THE WORK. REPORT ANY DISCREPANCIES TO THE CONSULTANT FOR CLARIFICATION BEFORE PROCEEDING.
- COORDINATE PLACEMENT AND LOCATION OF ITEMS BY SUBSEQUENT TRADES. RELEVANT TRADES SHALL REVIEW PRIOR TO ERECTION AND/OR INSTALLATION.
- NOTIFY THE ENGINEER A MINIMUM OF 96 HOURS PRIOR TO ANY REQUIRED SITE REVIEWS.

DESIGN LOADS

- UNLESS NOTED OTHERWISE, THE LOADS NOTED IN TABLES AND ON DRAWINGS ARE UNFACTORED.
- CLIMATIC INFORMATION, REFER TO CLIMATIC INFORMATION TABLE
- SITE INFORMATION, REFER TO SITE INFORMATION TABLE
- DESIGN LOADS, REFER TO DESIGN LOADS TABLE
- LATERAL LOADS
 - LATERAL LOADS FROM WIND AND SEISMIC LOADS ARE RESISTED BY LIMITED DUCTILITY CONCENTRIC STEEL BRACED FRAMES.
 - SEE FORCE MODIFICATION FACTORS TABLE.
- CONSTRUCTION LOADS SHALL NOT EXCEED THE LOADS NOTED ON THE DRAWINGS.

FOUNDATION AND GEOTECHNICAL NOTES

- FOUNDATION DESIGN SHOWN ON THESE DRAWINGS ARE FOR LATERAL RESTRAINT PURPOSES ONLY. SITE CLASSIFICATIONS WERE PROVIDED TO STANTEC IN REPORT NUMBER YAR03182-01 PREPARED BY TETRATECH, TITLED "SEISMIC CLASSIFICATIONS FOR SITES IN WEKWEETI, GAMETI AND PAULATUK, NT", AND DATED MARCH, 2018.
- BEARING CAPACITY AND BEARING PRESSURES WERE NOT CONSIDERED AS THIS BUILDING HAS BEEN DESIGN WITH A SURFACE BEARING FOUNDATION. SUCH FOUNDATIONS ARE SUBJECT TO SETTLEMENT AND SEASONAL GROUND MOVEMENT WHICH MAY REQUIRE PERIODIC RELEVELING.
- REMOVE ALL ORGANIC MATERIAL FROM THE BUILDING AREA AS OUTLINED IN THE GEOTECHNICAL REPORT.
- GRANULAR BACKFILL MATERIAL UNDER BUILDING FOOTPRINT TO BE COMPACTED TO 100% SPD. REFER TO CIVIL DRAWINGS/SPECIFICATION.

STRUCTURAL STEEL

- DESIGN, FABRICATION, ERECTION, AND OTHER CONSTRUCTION PRACTICES TO CONFORM TO CSA-S16 AND THE CISC CODE OF STANDARD PRACTICE FOR STRUCTURAL STEEL.
- STEEL TO BE FABRICATED AND ERECTED BY A SHOP CERTIFIED BY THE CANADIAN WELDING BUREAU TO THE REQUIREMENTS OF CSA-W47.1, DIVISION 1 OR 2.1 ONLY.
- SUPPLY STEEL WITH PROPERTIES NOTED IN STEEL GRADES TABLE.
- SUBMIT SHOP DRAWINGS SHOWING ALL STRUCTURAL STEEL MEMBERS FOR REVIEW PRIOR TO FABRICATION IF REQUESTED BY THE ENGINEER OR OWNER. WELDING TO CONFORM TO CSA-W59.
- CONNECTIONS NOT DETAILED ON THE STRUCTURAL DRAWINGS SHALL BE DESIGNED AND DETAILED BY A PROFESSIONAL STRUCTURAL ENGINEER REGISTERED IN NT AT THE STEEL FABRICATOR'S EXPENSE.
- UNLESS NOTED OTHERWISE, DESIGN CONNECTIONS FOR NON-COMPOSITE BEAMS FOR A FACTORED SHEAR FORCE EQUAL TO 87% OF THE TOTAL BEAM LOAD TABULATED IN THE CISC HANDBOOK OF STEEL CONSTRUCTION.
- ALL STRUCTURAL BOLTS CONNECTING STEEL TO STEEL SHALL BE GALVANIZED GRADE A325, AND A MINIMUM OF M20 OR ¾" IN DIAMETER. MINIMUM OF 2 BOLTS PER CONNECTION UNLESS NOTED OTHERWISE.
- THE CONTRACTOR MAY SUBMIT ALTERNATE BOLTS GRADES FOR APPROVAL BY THE ENGINEER IF THAT WHICH IS SPECIFIED IS NOT READILY AVAILABLE.
- PROVIDED A MINIMUM OF 2 BOLTS IN BOLTED CONNECTIONS.
- ALWAYS INSTALL BEAM WEB STIFFENERS IN PAIRS, ONE ON EACH SIDE OF WEB. STIFFENER SHALL BE PLACED AT ALL SUPPORTS AND CONCENTRATED LOAD LOCATION. MIN. STIFFENER THICKNESS SHALL BE 10mm.
- DO NOT SPLICE MATERIAL WITHOUT THE WRITTEN APPROVAL OF THE ENGINEER.

- SQUARE CUT OR FULL STRENGTH WELD ALL COLUMNS AT BASE PLATES AND AT TOP WHERE BEARING UNDER CONTINUOUS BEAMS.
- ALL WELDS SHALL HAVE AN ULTIMATE STRENGTH OF NOT LESS THAN 490 MPa (E49XX ELECTRODES).
- ALL EXPOSED WELDS TO BE CONTINUOUS. GRIND ALL EXPOSED WELDS SMOOTH, INCLUDING PAINTED STEEL.
- CLEAN, PREPARE AND PRIME ALL STRUCTURAL STEEL AND ANCHOR PLATES. DO NOT PRIME ANCHOR BOLTS.
- TOUCH-UP FIELD WELDS, CONNECTIONS AND ABRASIONS TO MATCH THE SHOP PRIMER.
- SHOP AND FIELD INSPECTION OF STEEL FABRICATION AND ERECTION TO BE COMPLETED BY A THIRD PARTY TESTING AND INSPECTION AGENCY APPROVED BY AND RESPONSIBLE TO THE ENGINEER. TESTING AGENCY SHALL BE CERTIFIED TO CSA-W178. TESTING PAID FOR BY CONTRACTOR.
- SPECIAL CARE IS TO BE TAKEN WHILE TRANSPORTING OR HANDLING THE STRUCTURAL STEEL. USE OF DAMAGED STEEL SHAPED IN NOT PERMITTED UNLESS OTHERWISE SPECIFIED BY THE DESIGNER/STRUCTURAL ENGINEER.

CAST-IN-PLACE REINFORCED CONCRETE

- CONCRETE MATERIALS, QUALITY, MIXING, PLACING, FORMWORK AND OTHER CONSTRUCTION PRACTICES TO CONFORM TO CSA-A23.1.
- SUPPLY CONTROLLED CONCRETE IN ACCORDANCE WITH CSA-A23.1 WITH PROPERTIES NOTED IN CONTROLLED CONCRETE TABLE.
- NOTIFY CONSULTANT 7 DAYS PRIOR TO CONCRETE POURS TO ALLOW FOR REVIEW OF REINFORCEMENT.
- DO NOT USE ADMIXTURES CONTAINING CALCIUM CHLORIDE.
- FIELD AND LABORATORY TESTING OF CONCRETE TO BE COMPLETED BY A THIRD PARTY TESTING AND INSPECTION AGENCY APPROVED BY AND RESPONSIBLE TO THE ENGINEER. TESTING AGENCY SHALL BE CERTIFIED TO CSA-A283 AND TESTING TO BE COMPLETED IN ACCORDANCE WITH CSA-A23.2. TESTING PAID FOR BY CONTRACTOR.
- DO NOT PLACE LOAD ON NEW CONCRETE OR POUR NEW CONCRETE ON NEW CONCRETE UNTIL AT LEAST 75% OF ITS 28 DAY STRENGTH IS ATTAINED. CONCRETE QUALITY CONTROL TESTING SHALL BE COMPLETED BY QUALIFIED PERSONNEL AND REPORTS ARE TO BE SUBMITTED TO THE ENGINEER.
- UNLESS OTHERWISE SPECIFIED, ALL CONCRETE ANCHOR BOLTS SHALL BE GRADE ASTM GRADE F1554, GRADE 55.
- CONCRETE SHALL NOT BE POURED IN AN UNCONFINED MANNER FROM A HEIGHT OF MORE THAN 1220mm.
- ALL BENDS IN PRIMARY REINFORCEMENT TO HAVE A RADIUS OF NOT LESS THAN 3 TIMES THE BAR DIAMETER.
- QUALITY CONTROL TESTING OF THE CONCRETE AND GROUTS MUST BE COMPLETED BY QUALIFIED PERSONNEL AND REPORTS ARE TO BE SUBMITTED TO THE ENGINEER OF RECORD.

CONCRETE REINFORCEMENT

- REINFORCEMENT STEEL TO CONFORM TO CSA-G30.18 GRADE 400W.
- DO NOT WELD REINFORCEMENT UNLESS APPROVED IN WRITING BY THE ENGINEER. REINFORCEMENT TO BE WELDED TO CONFORM TO CSA-G30.18, GRADE 400W. WELDING ONLY PERMITTED BY AN ORGANIZATION CERTIFIED TO CSA-W188.
- NOTIFY THE ENGINEER PRIOR TO CONCRETE PLACEMENT TO ALLOW FOR REVIEW OF REINFORCING.
- SUBMIT SHOP DRAWINGS AND DETAILS FOR ALL REINFORCEMENT FOR REVIEW PRIOR TO FABRICATION.
- REINFORCEMENT NOTED WITH "c" AS C10M IS TO HAVE A STANDARD HOOK AT ONE END. LENGTH OF BAR INDICATED IS EXCLUSIVE OF HOOK LENGTH.
- CLEAR CONCRETE COVER TO REINFORCEMENT - REFER TO CLEAR CONCRETE COVER TO REINFORCEMENT TABLE.
- STANDARD END HOOK LENGTHS FOR REINFORCING - REFER TO STANDARD END HOOKS TABLE .
- ALL REINFORCEMENT TO BE SUPPORTED AT 900 mm MAXIMUM SPACING.

CLIMATIC INFORMATION	
TO BE READ IN CONJUNCTION WITH DESIGN LOADS DESIGN NOTES	
SNOW LOAD (1/50), S _s	2.50 kPa
SNOW LOAD (1/50), S _r	0.10 kPa
ONE DAY RAIN (1/50)	N/A
HOURLY WIND PRESSURE (1/10)	0.36 kPa
HOURLY WIND PRESSURE (1/50)	0.47 kPa
SEISMIC RESPONSE, S _s (0.2)	0.052
SEISMIC RESPONSE, S _s (0.5)	0.031
SEISMIC RESPONSE, S _s (1.0)	0.016
SEISMIC RESPONSE, S _s (2.0)	0.0085
SEISMIC RESPONSE, S _s (5.0)	0.0013
SEISMIC RESPONSE, S _s (10.0)	0.0007
SEISMIC RESPONSE, P _{GA}	0.030
SEISMIC RESPONSE, P _{GV}	0.021

SITE INFORMATION	
TO BE READ IN CONJUNCTION WITH DESIGN LOADS DESIGN NOTES	
IMPORTANCE CATEGORY	POST DISASTER
WIND EXPOSURE TYPE	OPEN TERRAIN
INTERNAL PRESSURE COEFFICIENTS	-0.45 TO +0.30
FOUNDATION SITE CLASS	D

TABLE 6.1							
TO BE READ IN CONJUNCTION WITH DESIGN NOTES SECTION 6 - CAST-IN-PLACE CONCRETE							
CONTROLLED CONCRETE							
CONCRETE ELEMENT	CLASS OF EXPOSURE	MINIMUM COMPRESSIVE STRENGTH AT 28 DAYS (MPa)	MINIMUM COMPRESSIVE STRENGTH AT 56 DAYS (MPa)	MAXIMUM AGGREGATE SIZE (mm)	AIR CONTENT CATEGORY	MAXIMUM W/C RATIO	CEMENT TYPE
BURIED CONCRETE	F-2	30	NA	20	2	0.55	GU
SLAB-ON-GRADE	F-2	30	NA	20	2	0.55	GU

TABLE 8.3					
TO BE READ IN CONJUNCTION WITH DESIGN NOTES SECTION 8 - CONCRETE REINFORCEMENT					
REINFORCEMENT SPLICES					
BAR SIZE	COMPRESSION SPLICE (mm)	TENSION SPLICE (mm)			
		FULL TENSION SPLICE		FULL TENSION SPLICE TOP BARS*	
		REGULAR BARS	EPOXY COATED BARS	REGULAR BARS	EPOXY COATED BARS
10M	300	400	600	500	650
15M	450	550	850	750	950
20M	600	700	1000	900	1150
25M	750	1100	1650	1400	1850
30M	900	1300	1950	1700	2200
35M	1025	1550	2300	2000	2600
NOTE 1:	THIS TABLE IS BASED ON NORMAL WEIGHT CONCRETE f' _c = 35 MPa AND ON REINFORCING STEEL f _y = 400 MPa.				
NOTE 2:	*TOP BARS ARE DEFINED AS HORIZONTAL REINFORCEMENT PLACED SUCH THAT MORE THAN 300mm OF CONCRETE IS CAST IN THE MEMBER BELOW THE REINFORCEMENT.				
NOTE 3:	FOR STANDARD EMBEDMENT DEPTH INTO CONCRETE, DIVIDE BASIC TENSION LAP SPLICE NUMBERS BY 1.3.				

STEEL GRADES	
TO BE READ IN CONJUNCTION WITH STRUCTURAL STEEL DESIGN NOTES	
MEMBER TYPE	GRADE
ROLLED W-SHAPES, EXCEPT SKIDS	CSA G40.21 350W OR ASTM A992 GRADE 50
ROUND HSS/PILING	A252/A500
RECTANGULAR HSS STRUCTURAL SECTIONS	CSA G40.21 350W CLASS C
MAIN BUILDING SKIDS	CSA G40.21, 350WT
FLOOR CHECKER PLATE	316
FLOOR EXTERIOR ANGLE	316
OTHER STRUCTURAL SHAPES AND PLATES	CSA G40.21 300W
BOLTS	ASTM A325
ANCHOR RODS	ASTM F1554 GRADE 55
HEADED STUD ANCHORS	ASTM A108
THREADED ROD	ASTM A307

DESIGN LOADS	
TO BE READ IN CONJUNCTION WITH DESIGN LOADS DESIGN NOTES	
FLOOR	
LIVE LOAD (UNDER WATER TANK)	28 kPa
LIVE LOAD (ELSEWHERE)	6.0 kPa
SUPERIMPOSED DEAD LOAD	2.5 kPa
ROOFS	
BASIC SNOW LOAD	2.6 KPa
SUPERIMPOSED DEAD LOAD	1.5 kPa

FORCE MODIFICATION FACTORS	
TO BE READ IN CONJUNCTION WITH DESIGN LOADS DESIGN NOTES	
LATERAL LOAD RESISTANCE SYSTEM	MODIFICATION FACTOR
	COMBINED DUCTILITY RELATED, RS
LIMITED DUCTILITY CONCENTRICALLY BRACED FRAMES	1.5



Stantec Architecture Ltd.
2nd Floor 4910 53 Street
PO Box 1777
Yellowknife, NT X1A 2P4
Tel: (867) 920-2882 • www.stantec.com

Copyright Reserved

The Contractor shall verify and be responsible for all dimensions. DO NOT scale the drawing - any errors or omissions shall be reported to Stantec without delay.
The Copyrights to all designs and drawings are the property of Stantec. Reproduction or use for any purpose other than that authorized by Stantec is forbidden.

Consultant


Notes

Revision

C - ISSUED FOR CONSTRUCTION	JP	MJW	2018.09.11
B - ISSUED FOR 100% REVIEW	JP	MJW	2018.07.13
A - ISSUED FOR 70% REVIEW	JP	MJW	2018.03.13
Issued	By	Appd	YYYY-MM-DD

File Name: N/A	Author Dwn.	Designer Dsgn.	Checker Chkd.	04/06/18
				YYYY-MM-DD

Permit/Seal

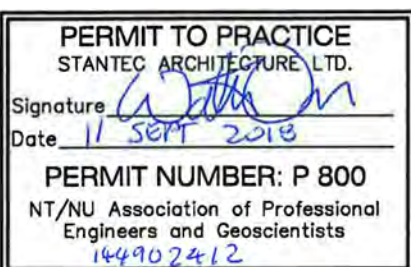

Client/Project Logo



Client/Project
GOVERNMENT OF NORTHWEST TERRITORIES

BUNDLED WATER TREATMENT PLANTS

WEKWEETI, NT

Title
NOTES AND TABLES

Project No. 144902412	Scale
Revision	Drawing No. S001


The Contractor shall verify and be responsible for all dimensions. DO NOT scale the drawing - any errors or omissions shall be reported to Stantec without delay. The Copyrights to all designs and drawings are the property of Stantec. Reproduction or use for any purpose other than that authorized by Stantec is forbidden.

Notes

[illegible]

File Name: N/A	Author	Designer	Checker	04/04/18
	Dwn.	Dsn.	Chkd.	YYYY MM



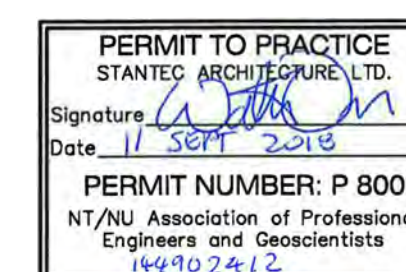

Northwest
Territories

BUNDLED WATER TREATMENT PLANTS

WEKWEETI, NT

Title
PLANS

Project No.
144902412

Revision

Scale
1 : 50
Drawing No.

S101



NOTES:

1. FLOOR DECK SHALL BE 4.8mm STEEL PLATE.
2. FLOOR DECK DECK TO SUPPORTING MEMBER USING 19mm PADDLE WELSD@400mm O/C
3. COAT STEEL FLOOR PLATE WITH PINNACLE Z-3 POLYUREA HYBRID COATING, 3mm THICK.
4. BEAR ALL EQUIPMENT SUPPORTS DIRECTLY OVER FLOOR JOIST. OTHERWISE, INSTALL C150x16BRIDGING BETWEEN JOISTS TO SUPPORT EQUIPMENT. DO NOT INSTALL EQUIPMENT SUPPORTS ON FLOOR PLATE ONLY.

Copyright Reserved

The Contractor shall verify and be responsible for all dimensions. DO NOT scale the drawing - any errors or omissions shall be reported to Stantec without delay. The Copyrights to all designs and drawings are the property of Stantec. Reproduction or use for any purpose other than that authorized by Stantec is forbidden.


Consultant

Notes

1
S301

2 SECTION
S301 1:50

Permit/Seal

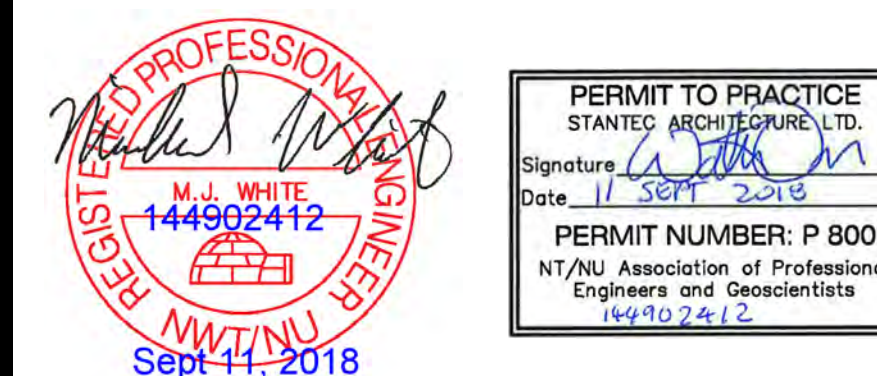

Client/Project Logo



Client/Project
GOVERNMENT OF NORTHWEST TERRITORIES

BUNDLED WATER TREATMENT PLANTS

WEKWEETI, NT

Title

Project No.
144902412

Revision

Scale
1 : 50

Drawing No. _____

S301



The Contractor shall verify and be responsible for all dimensions. DO NOT scale the drawing - any errors or omissions shall be reported to Stantec without delay. The Copyrights to all designs and drawings are the property of Stantec. Reproduction or use for any purpose other than that authorized by Stantec is forbidden.

Notes

[illegible]



PERMIT TO PRACTICE
STANTEC ARCHITECTURE LTD.
 Signature [Signature]
 Date 11 SEPT 2018
PERMIT NUMBER: P 800
 NT/NU Association of Profession
 Engineers and Geoscientists
184907412



Northwest Territories

Client/Project
GOVERNMENT OF NORTHWEST TERRITORIES

BUNDLED WATER TREATMENT PLANTS

WEKWEETI, NT


Title
DETAILS

Project No.
144902412
Revision


Scale
As indicated

Drawing No.


S501

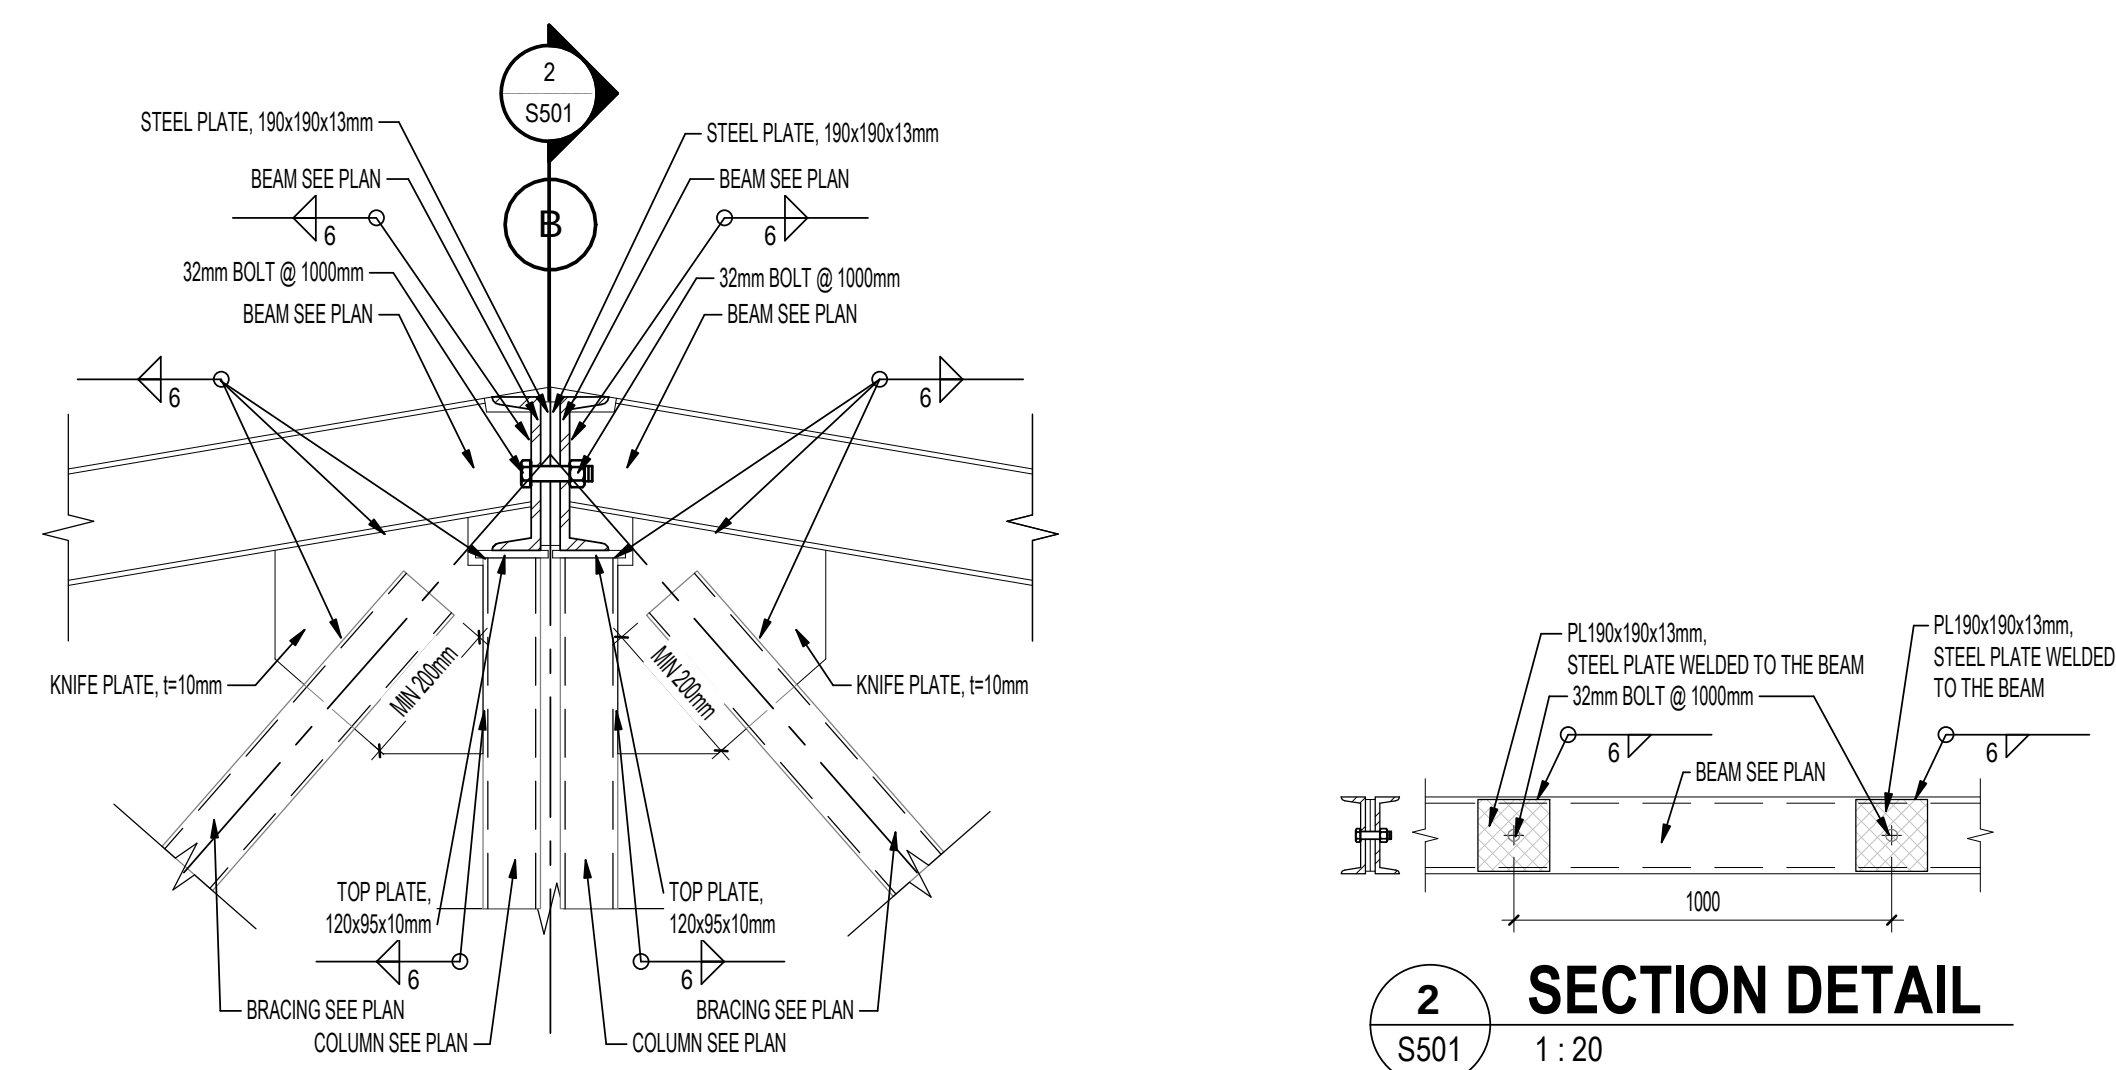


SECTION DETAIL

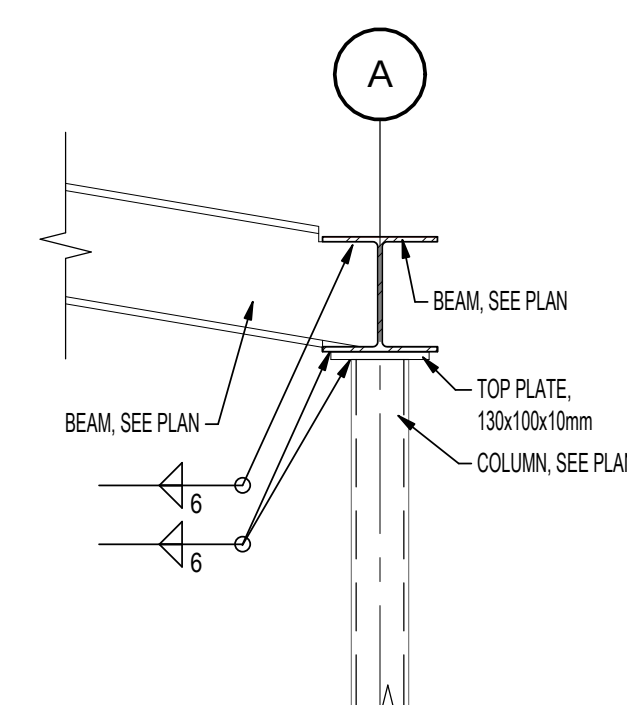

3 **DETAIL-CORNER**
S501 1:10

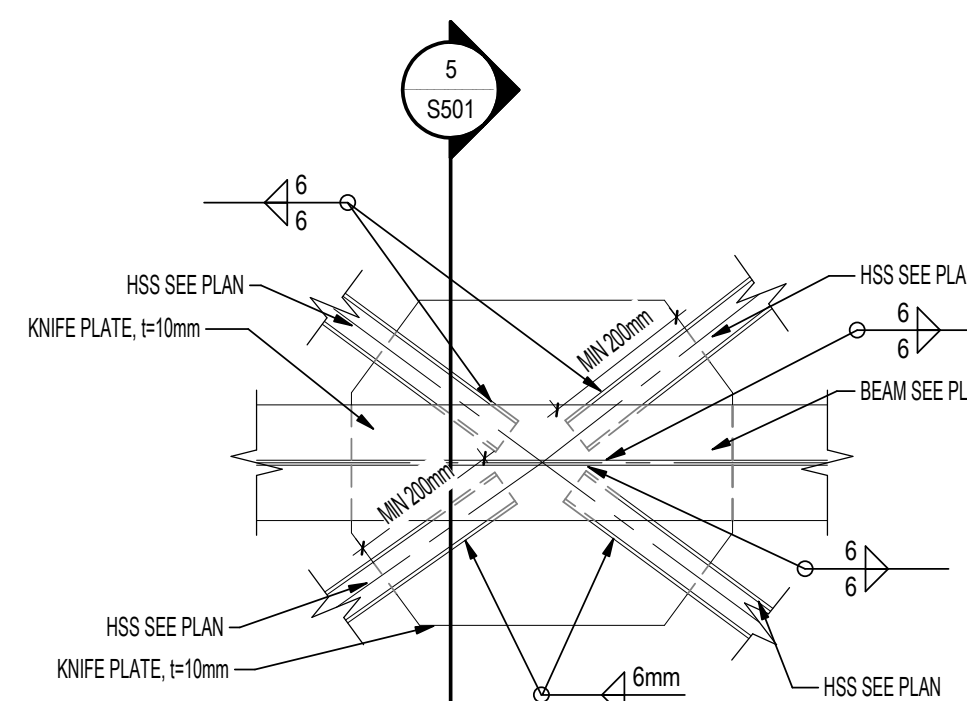


4 CONNECTION DETAIL

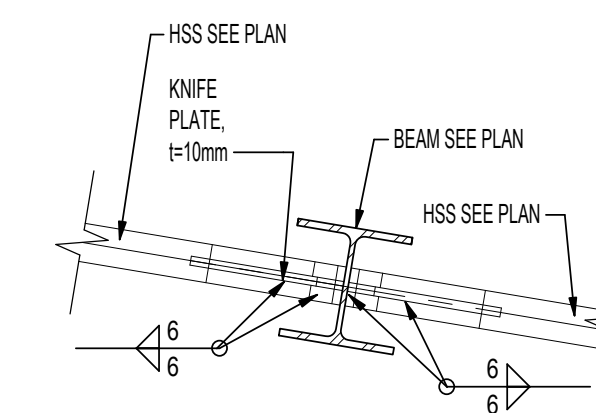


5 SECTION DETAIL
S501 1:10

1 CONNECTION DETAIL

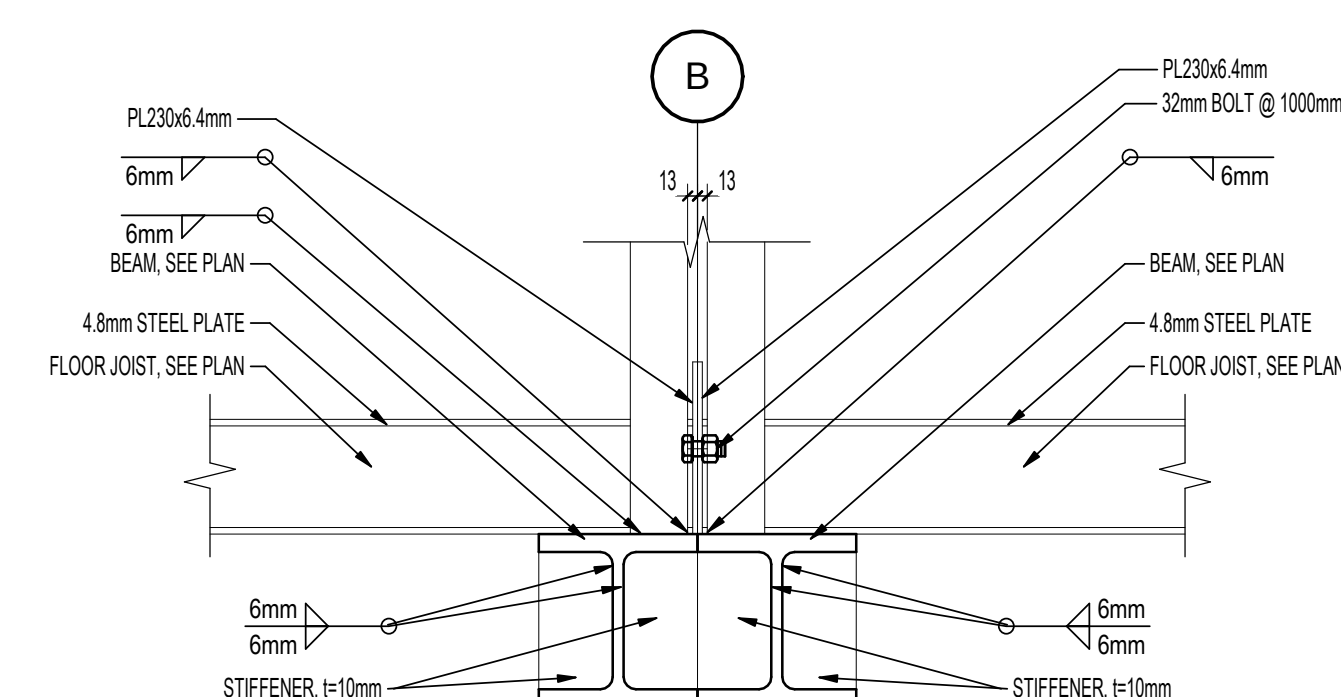


6 CONNECTION DETAIL

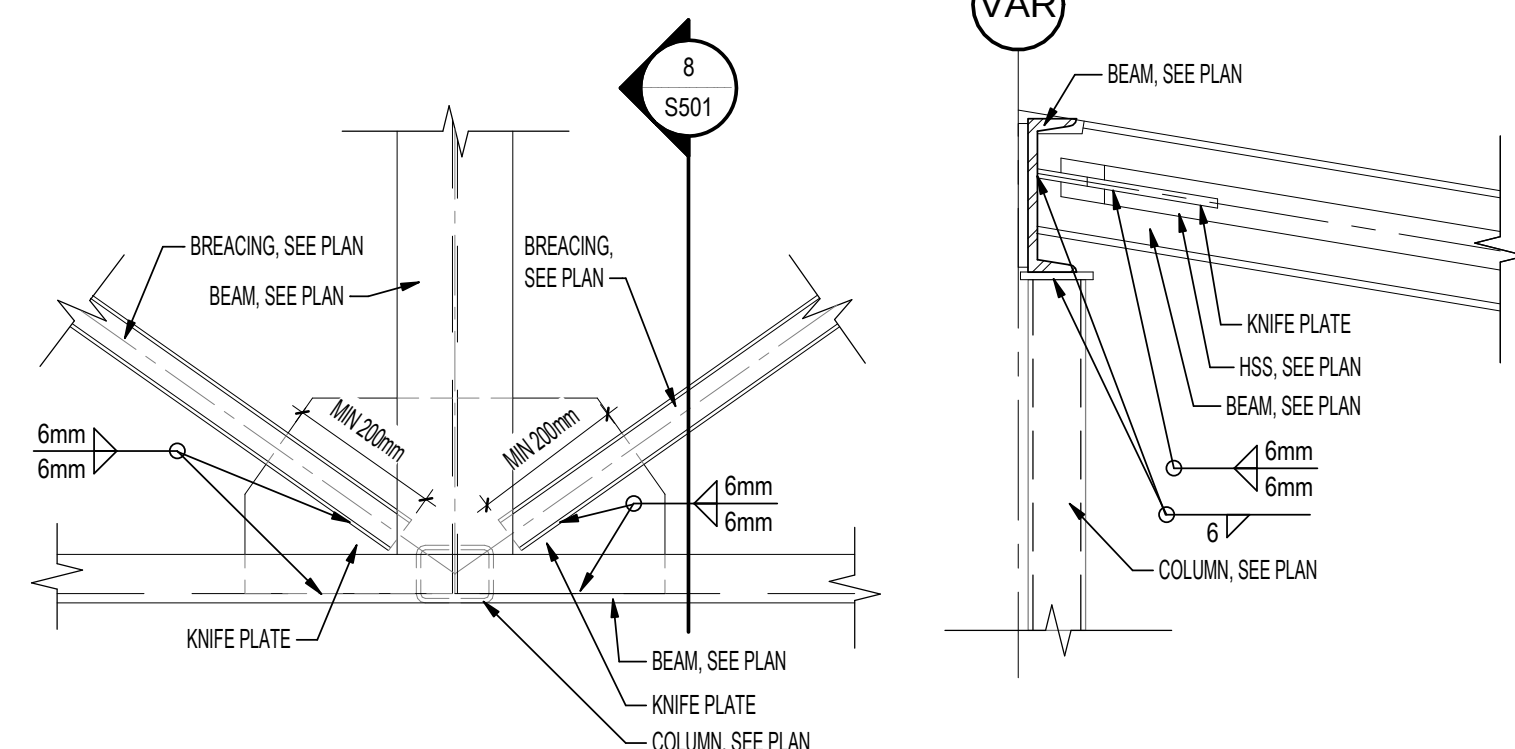


7 CONNECTION DETAIL


8 SECTION DETAIL
S501 1:10

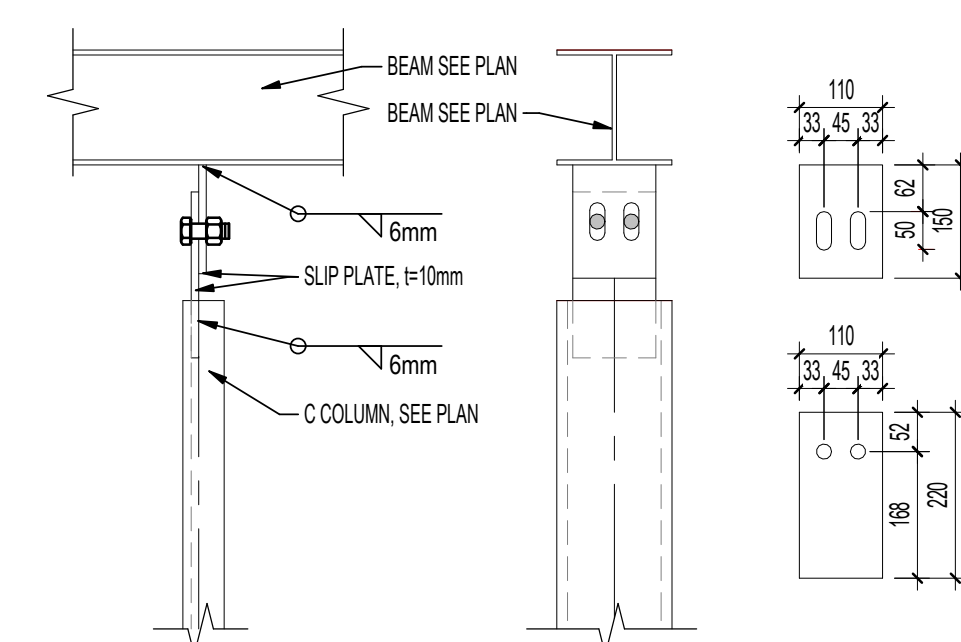

9 SLIP CONNECTION

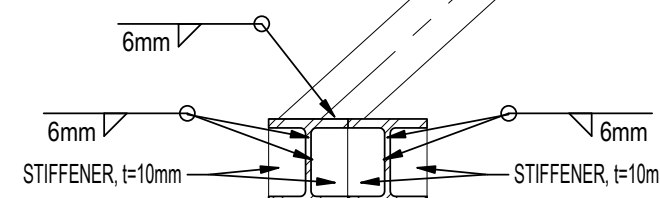

10 TRACK FILL LINE SUPPORT, DETAIL

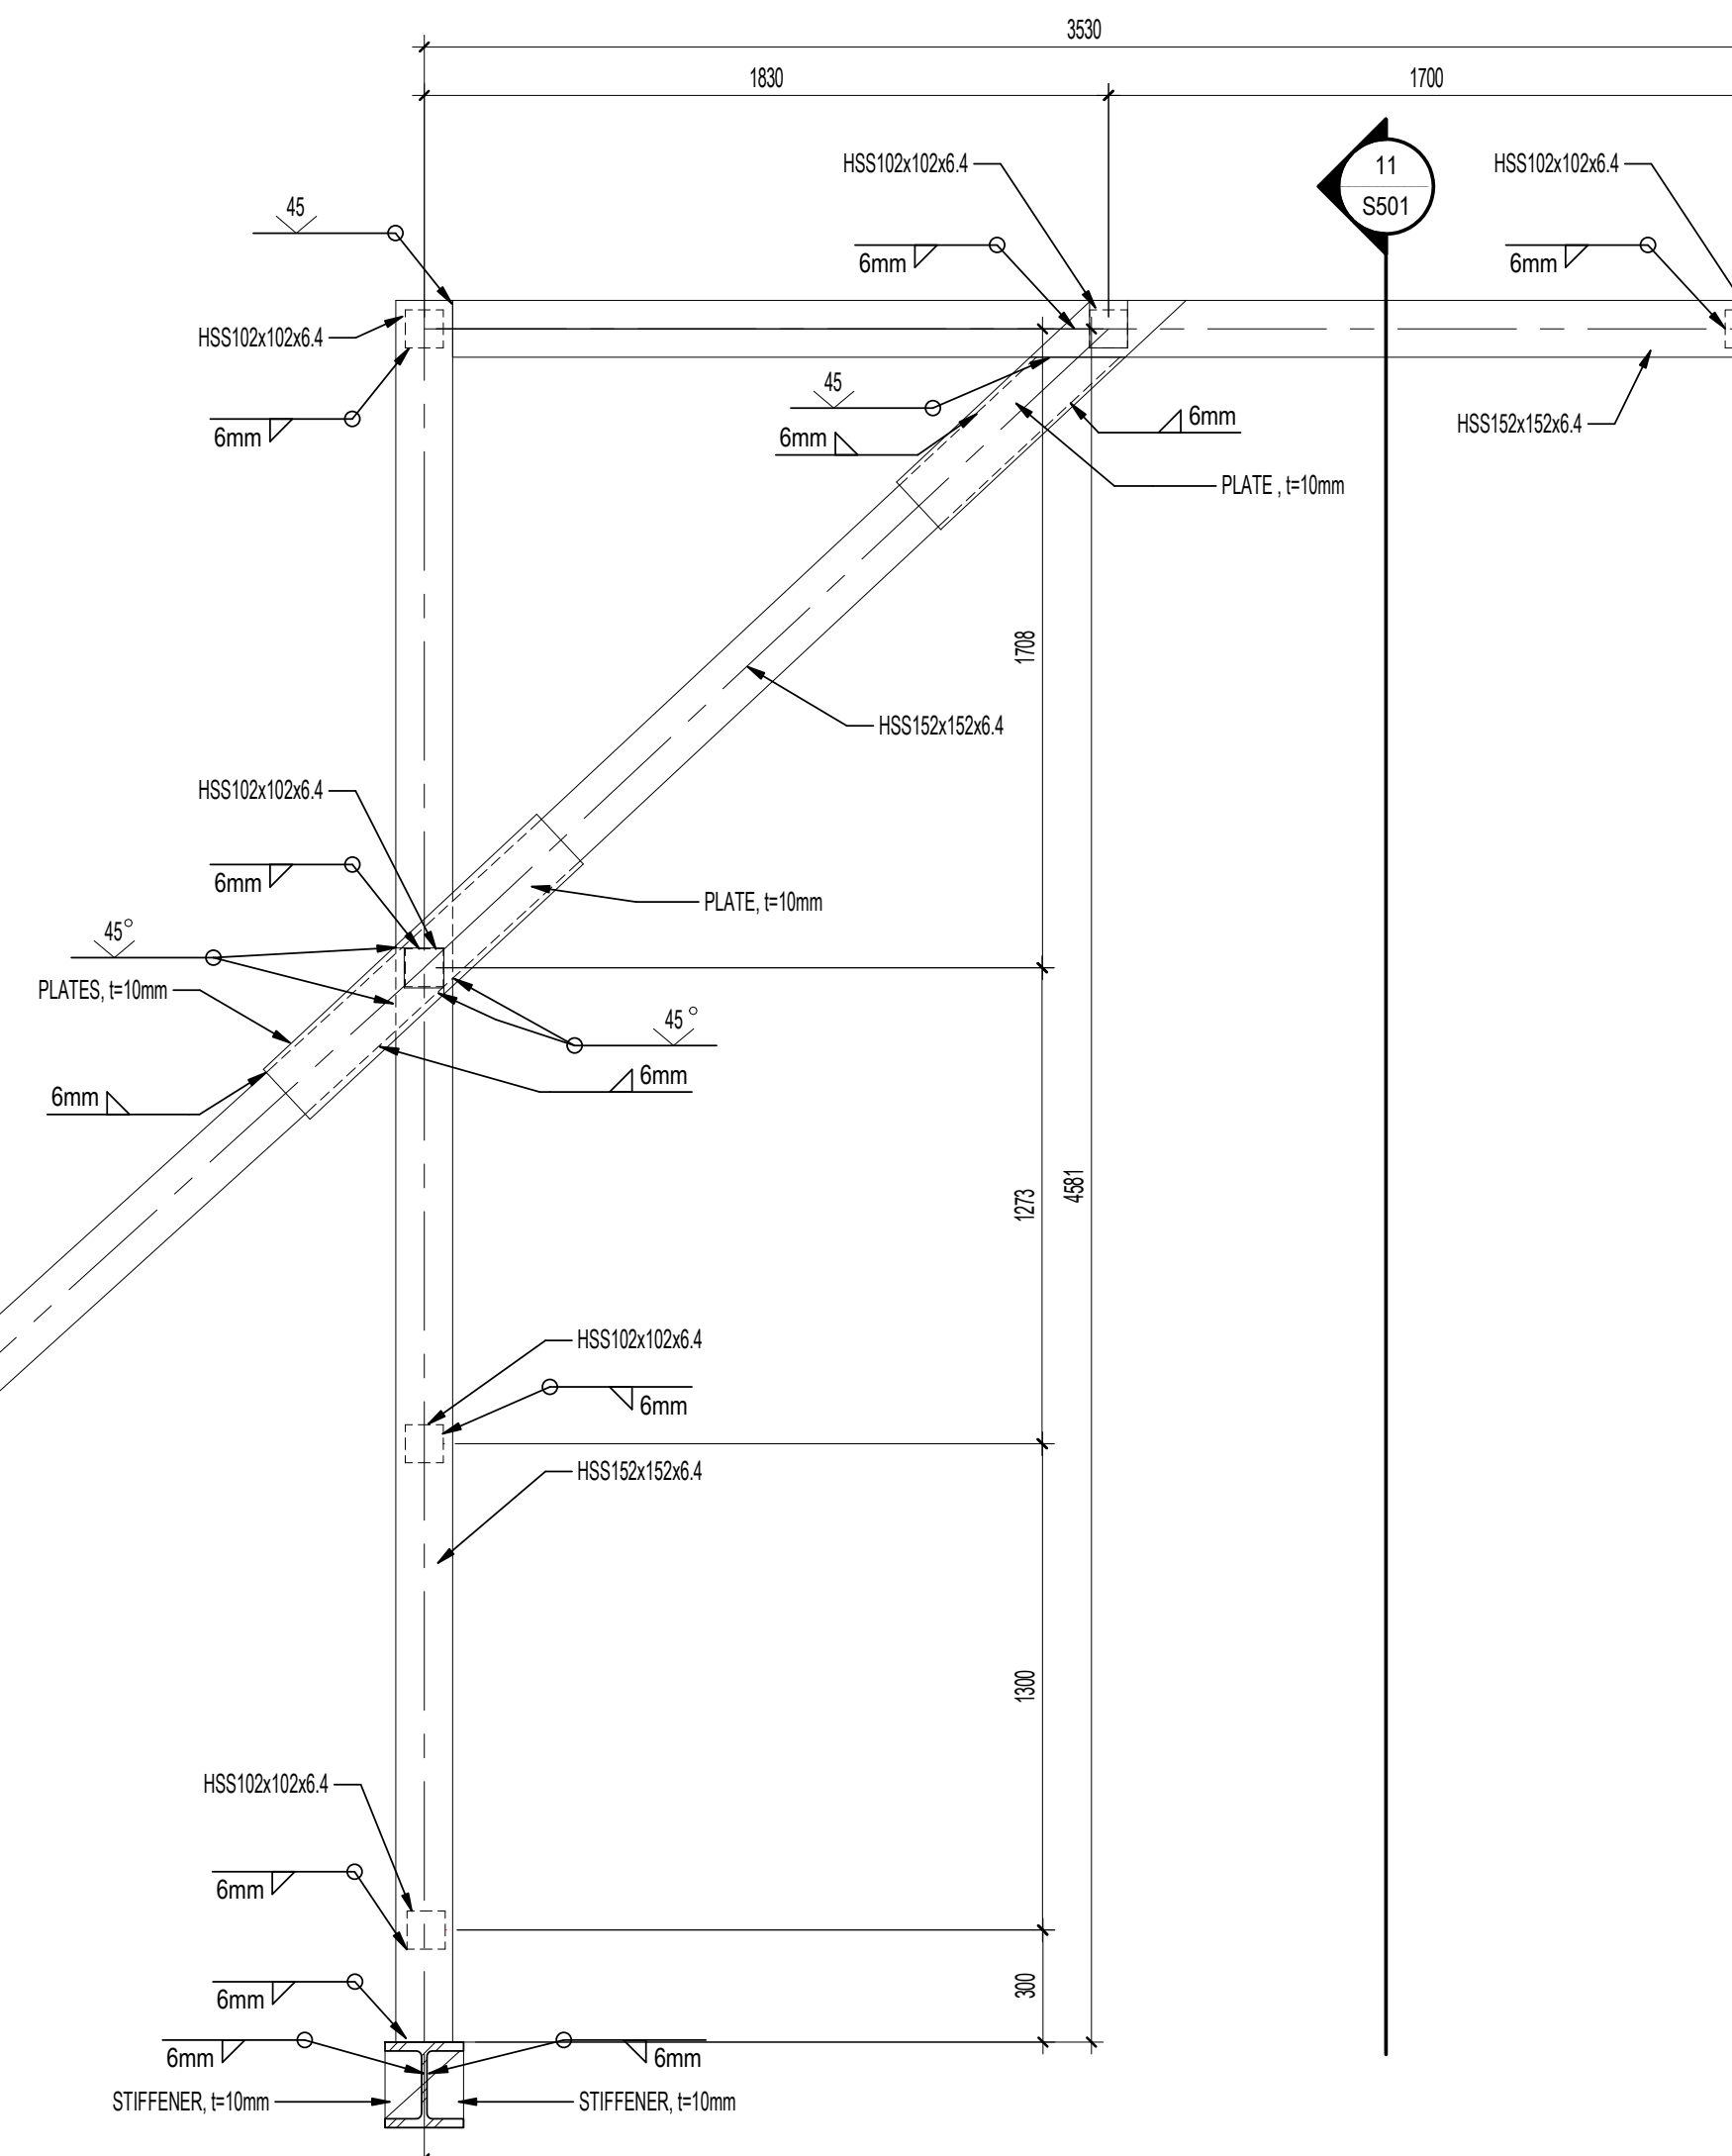

11 TRUCK FILL LINE SUPPORT, SECTION
S501 1:20

Copyright Reserved

The Contractor shall verify and be responsible for all dimensions. DO NOT scale the drawing - any errors or omissions shall be reported to Stantec without delay.
The Copyrights to all designs and drawings are the property of Stantec. Reproduction or use for any purpose other than that authorized by Stantec is forbidden.

Consultant


Notes

Revision

C	ISSUED FOR CONSTRUCTION	JP	MJW	2018.09.11
B	ISSUED FOR 100% REVIEW	JP	MJW	2018.07.13
A	ISSUED FOR 70% REVIEW	JP	MJW	2018.03.13
Issued		By	Appd	YYYY.MM.DD

File Name: N/A	Author Dwn.	Designer Dgn.	Checker Chkd.	05/01/18
				YYYY.MM.DD

Permit/Seal

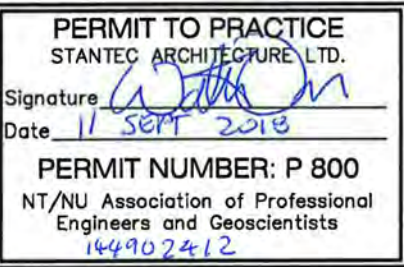

Client/Project Logo



Client/Project

GOVERNMENT OF NORTHWEST TERRITORIES

BUNDLED WATER TREATMENT PLANTS

WEKWEETI, NT

Title

DETAILS

Project No.

144902412


Revision

Scale


1 : 10

Drawing No.

S502

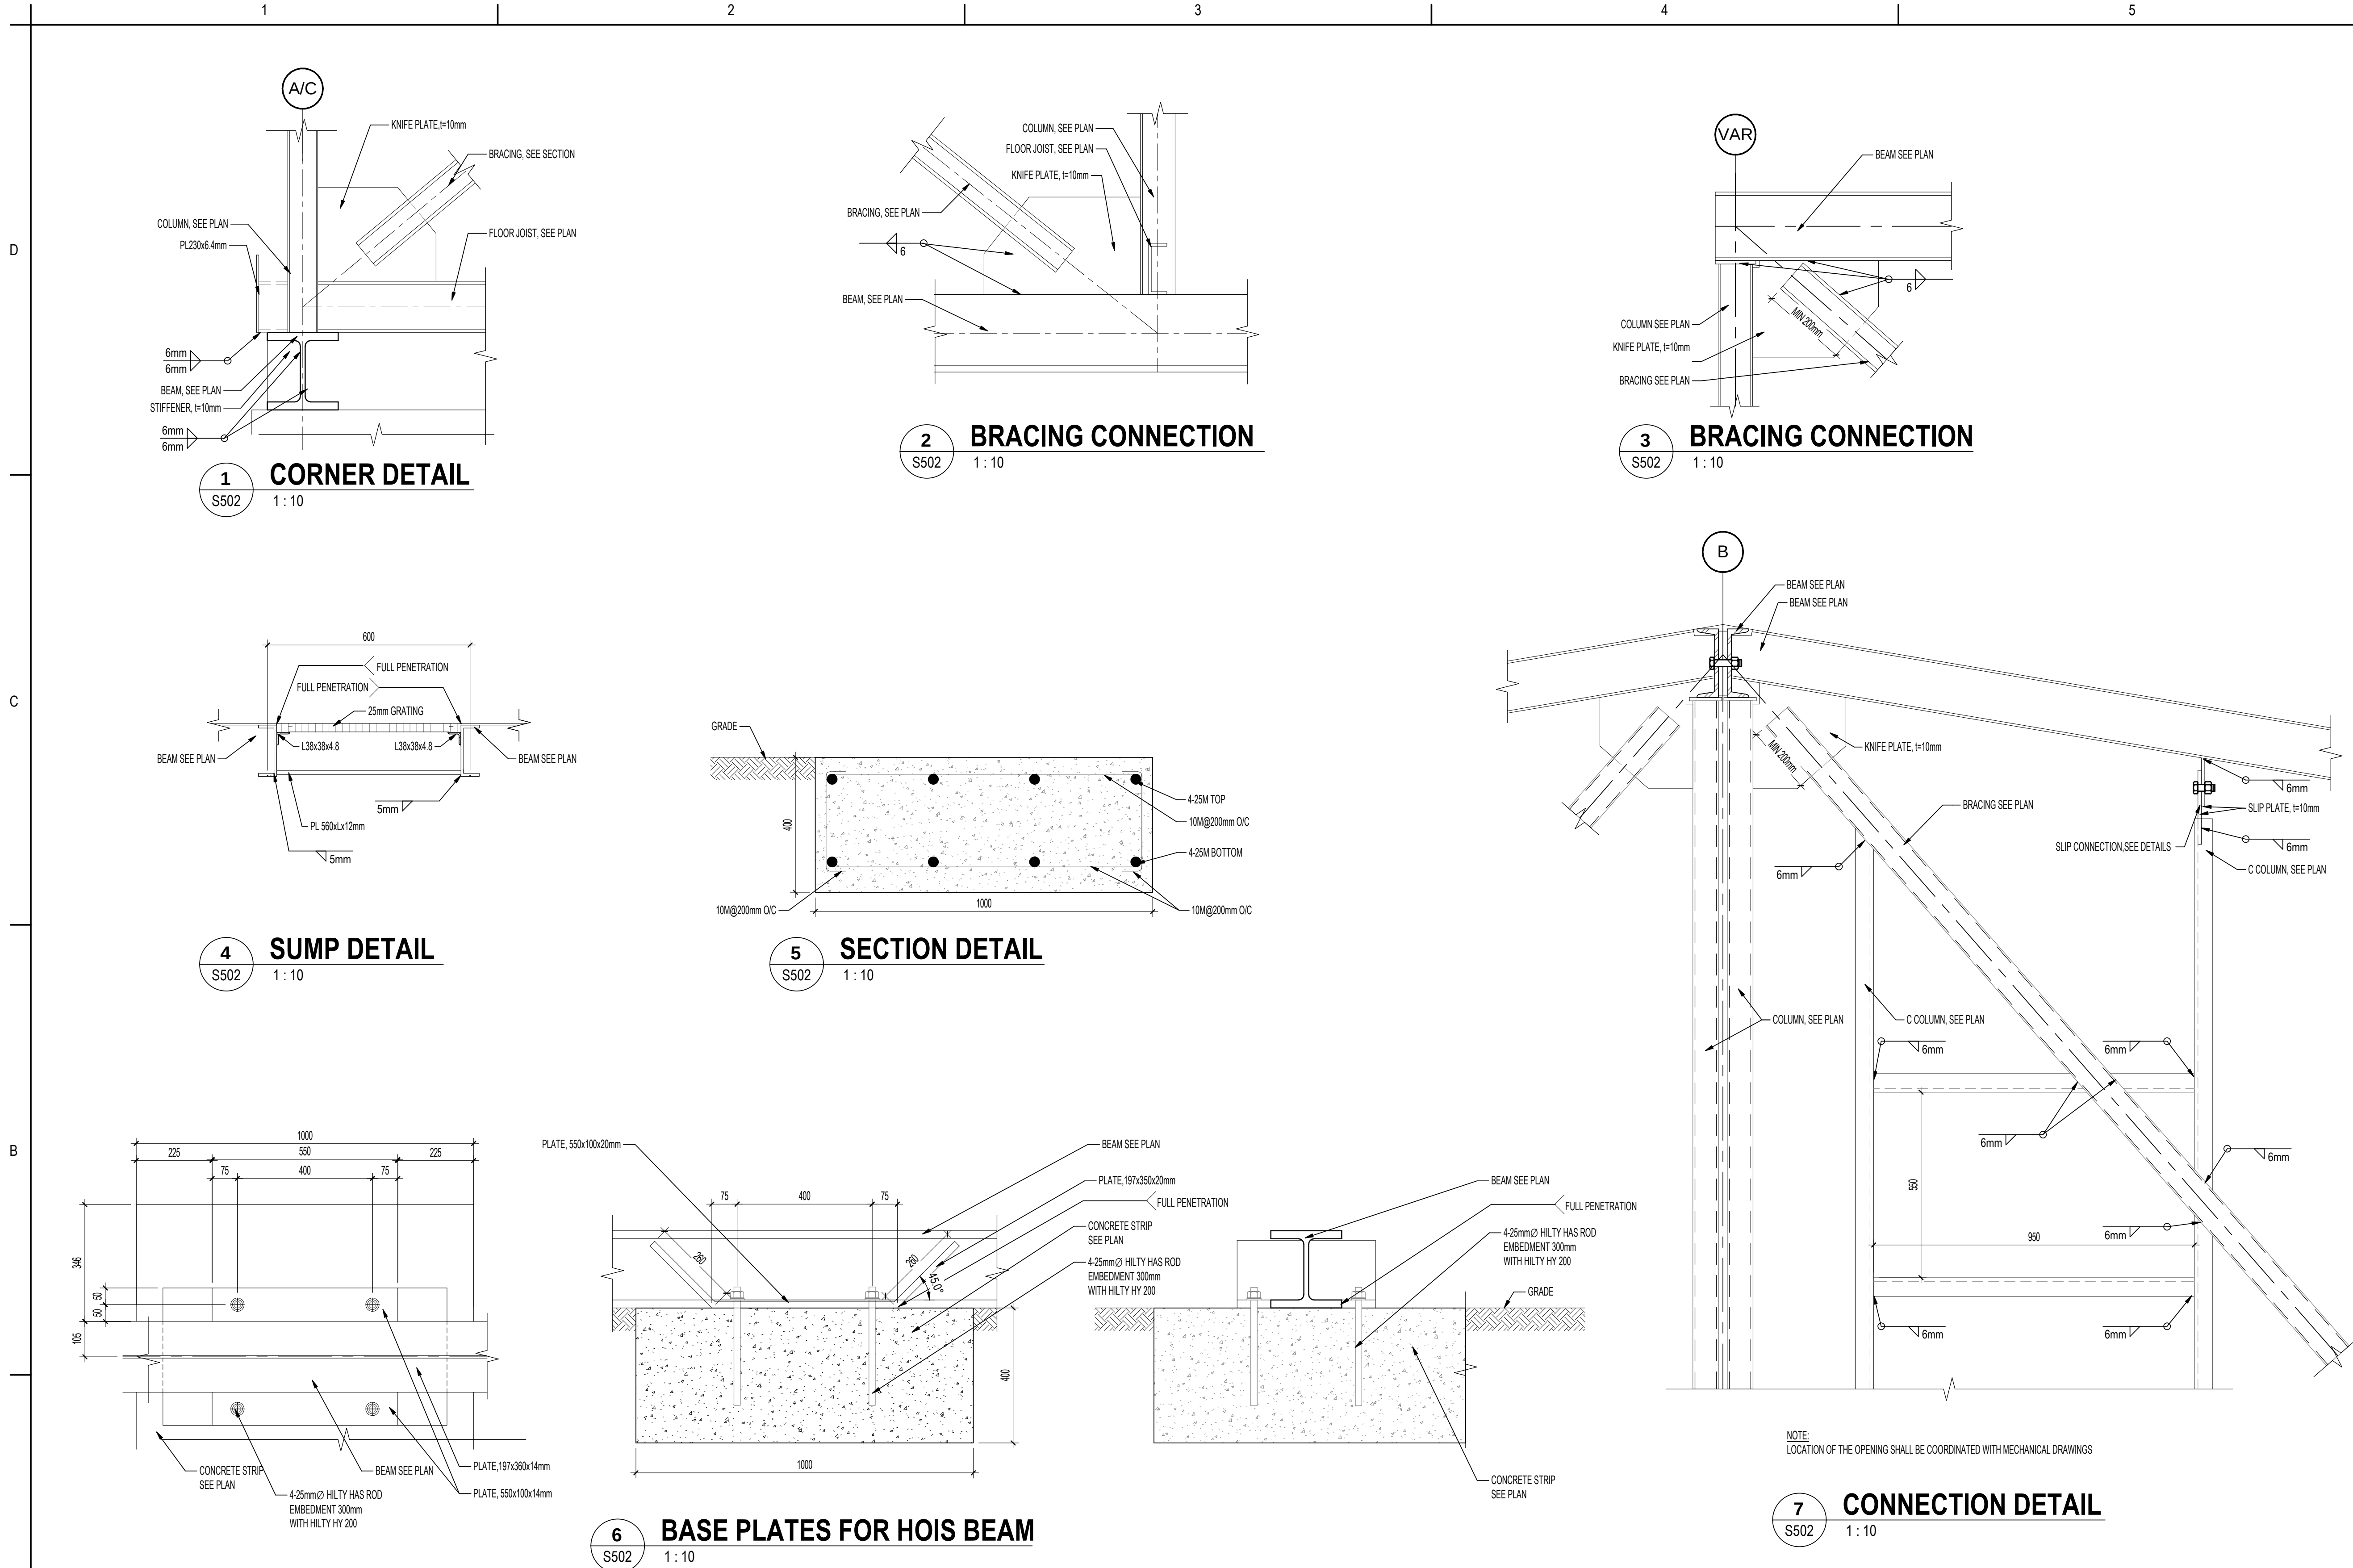


C:\Users\stanc\OneDrive\Documents\Drawings\Structural
9/11/2018 3:28:41 PM
ORIGINAL SHEET - ANSI D

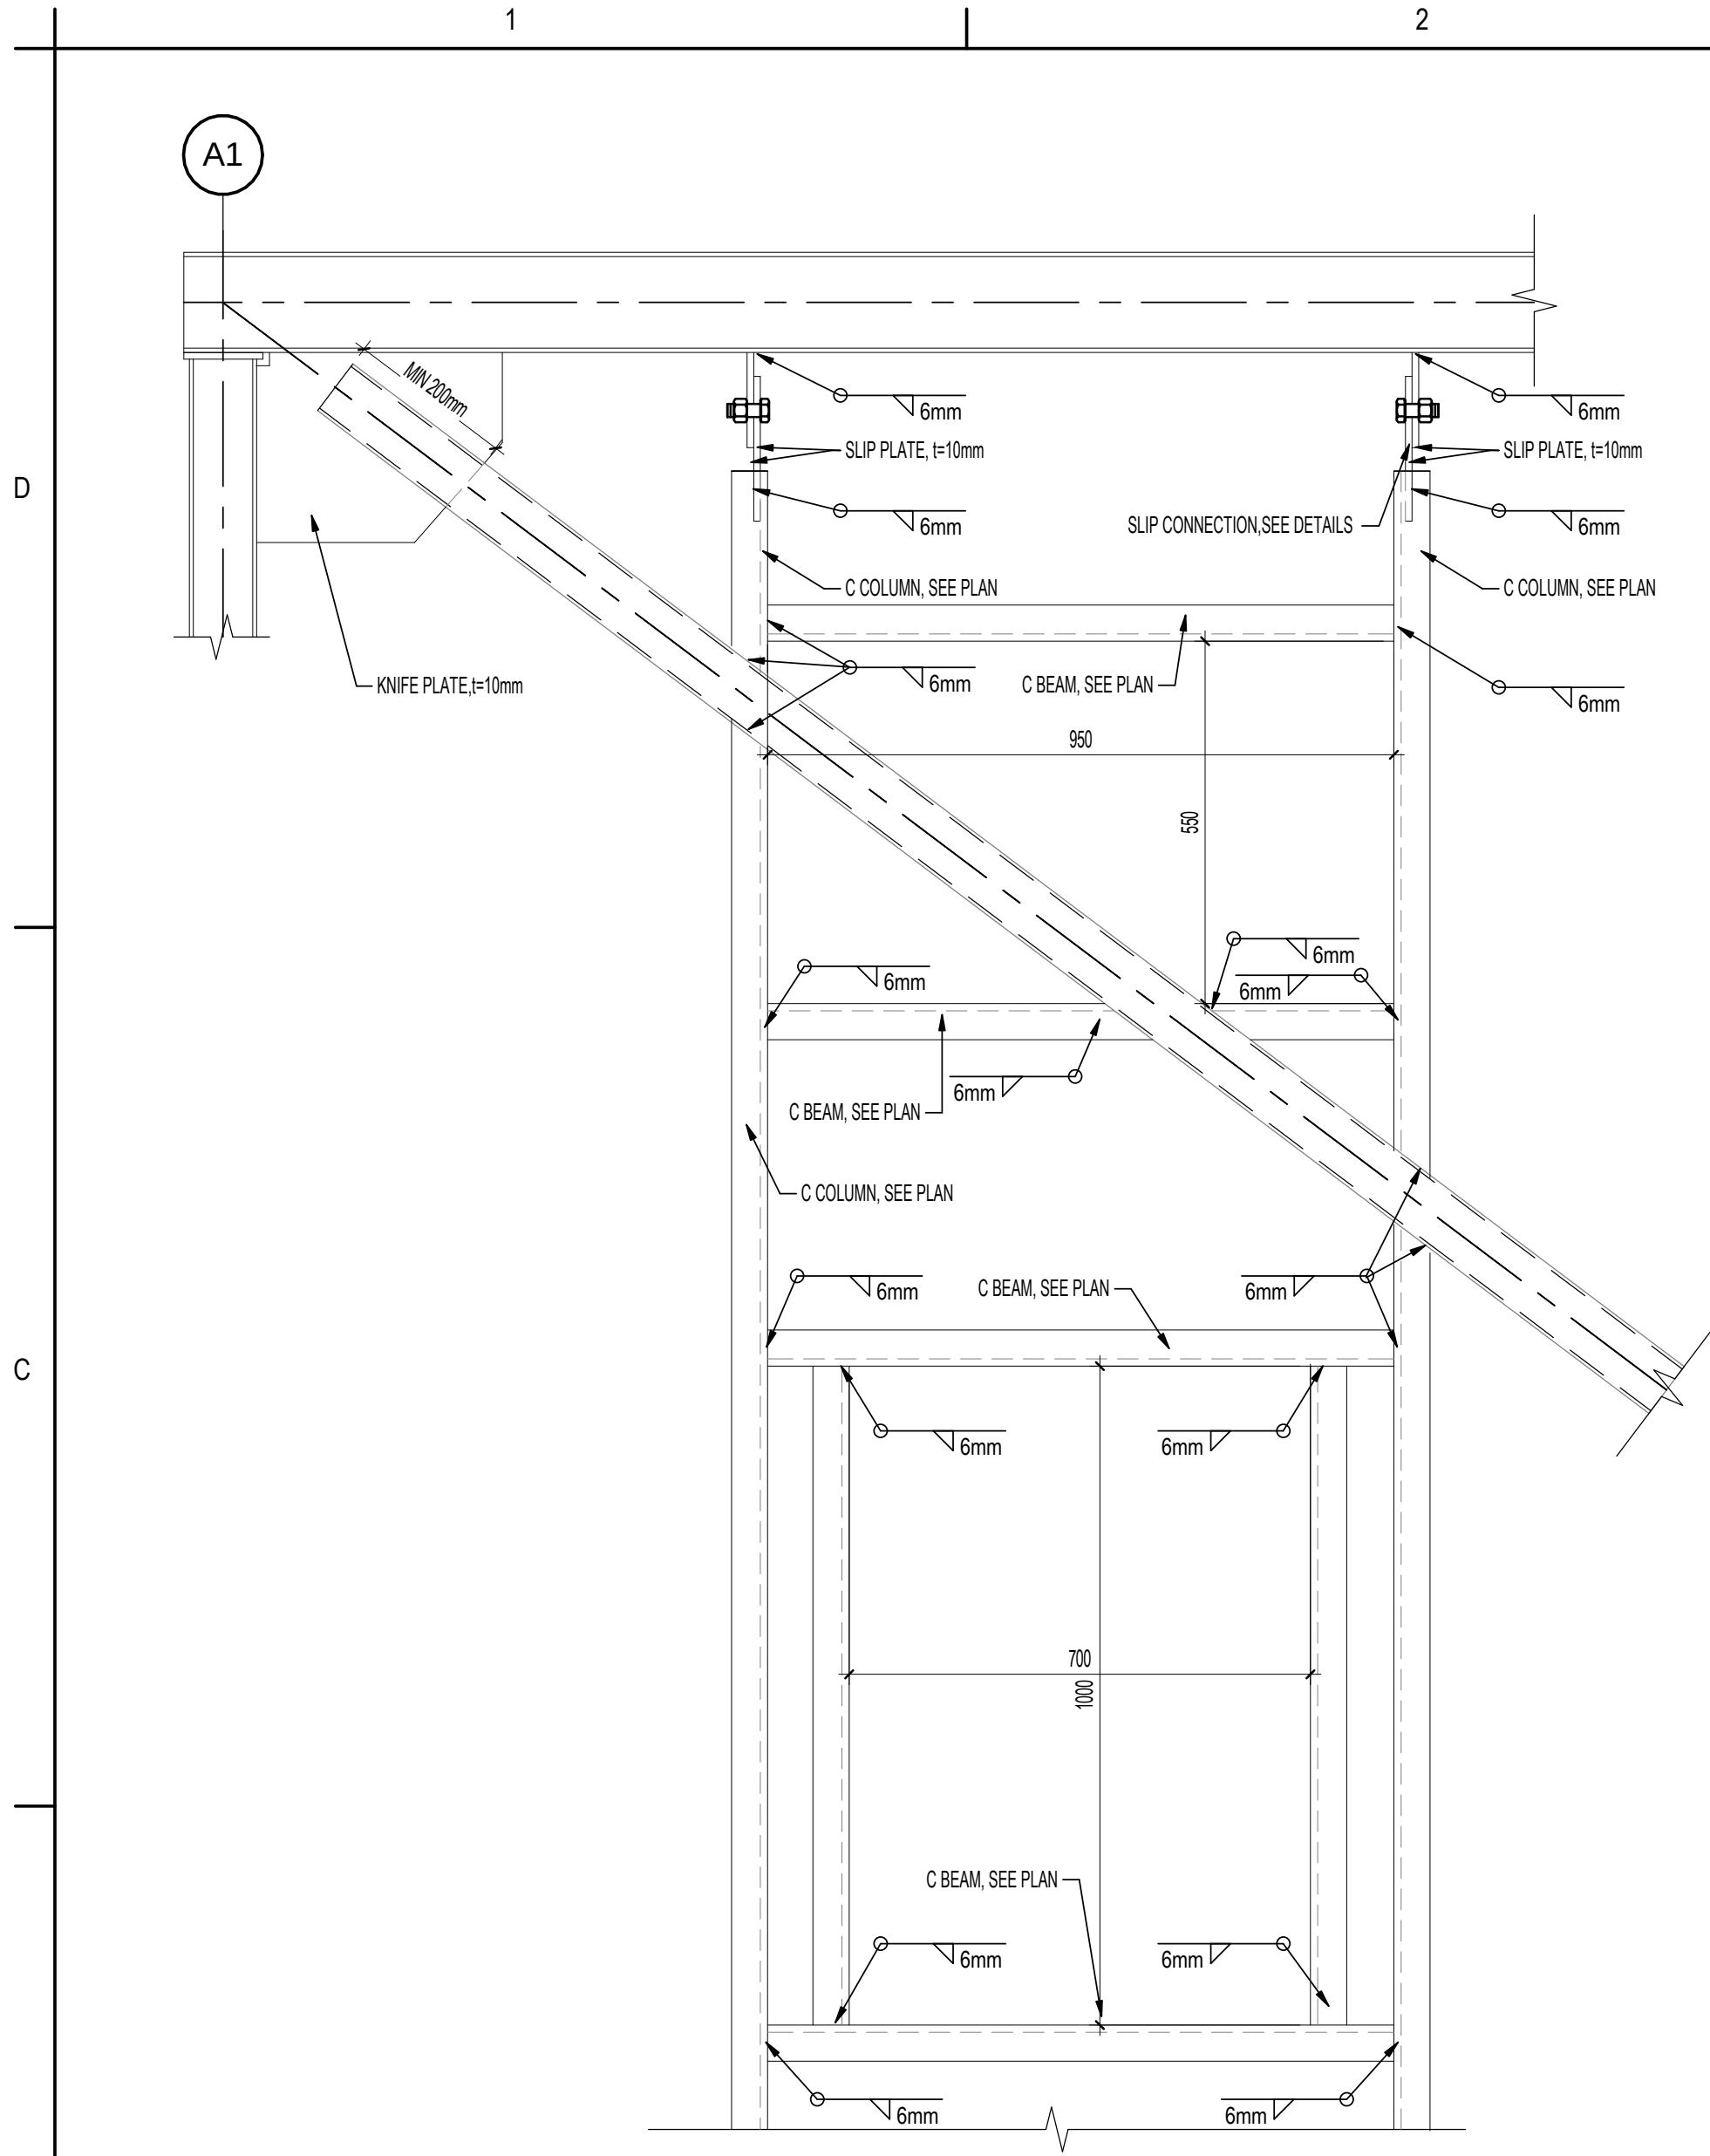


NOTE:
LOCATION OF THE OPENING SHALL BE COORDINATED WITH MECHANICAL DRAWINGS

1 SECTION DETAIL
S503 1 : 10

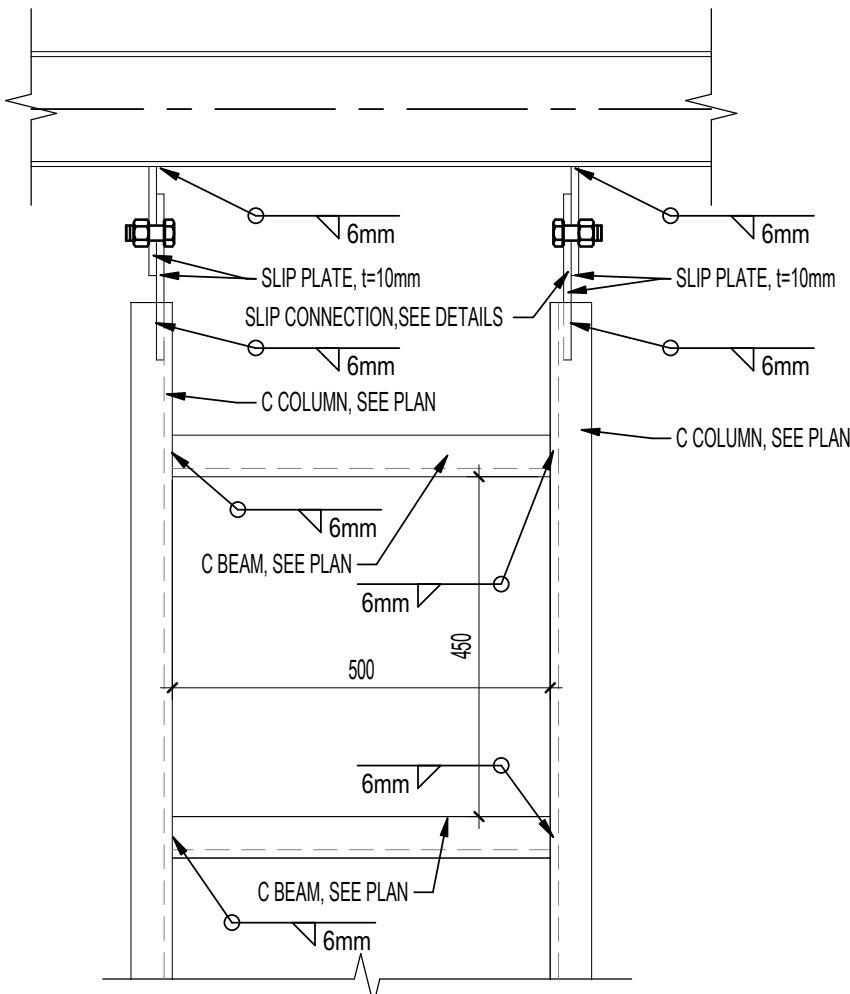


NOTE:
LOCATION OF THE OPENING SHALL BE COORDINATED WITH MECHANICAL DRAWINGS

2 SECTION DETAIL
S503 1 : 10

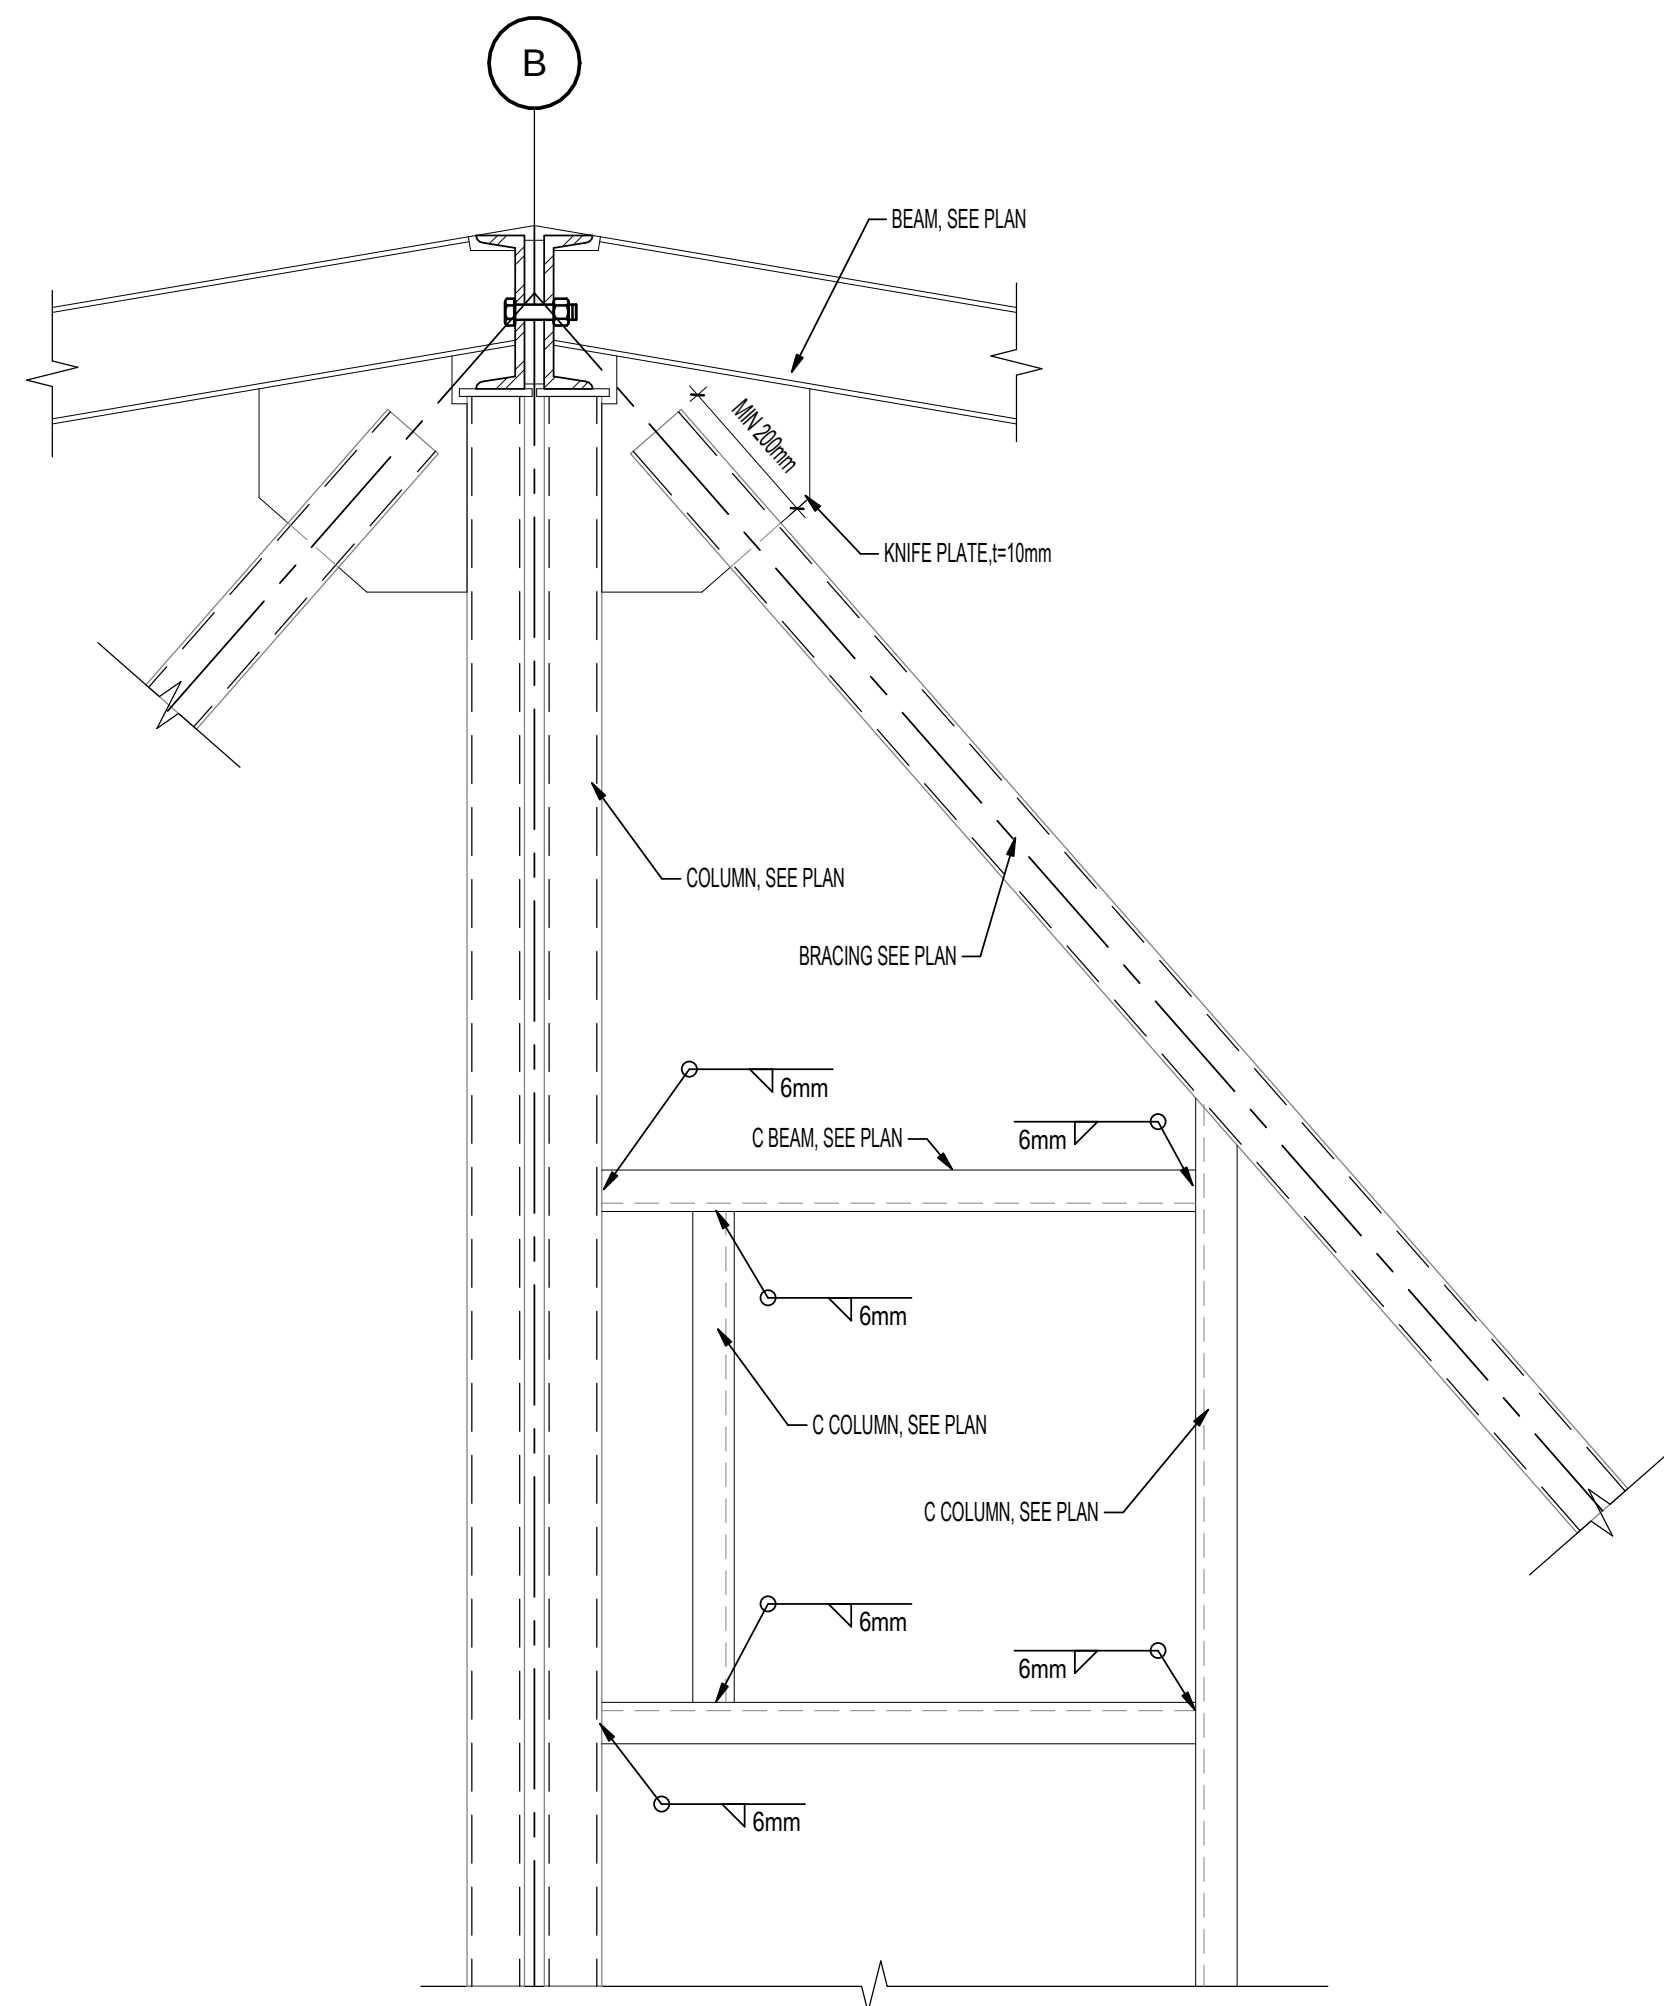

NOTE:
LOCATION OF THE OPENING SHALL BE COORDINATED WITH MECHANICAL DRAWINGS

3 SECTION DETAIL
S503 1 : 10

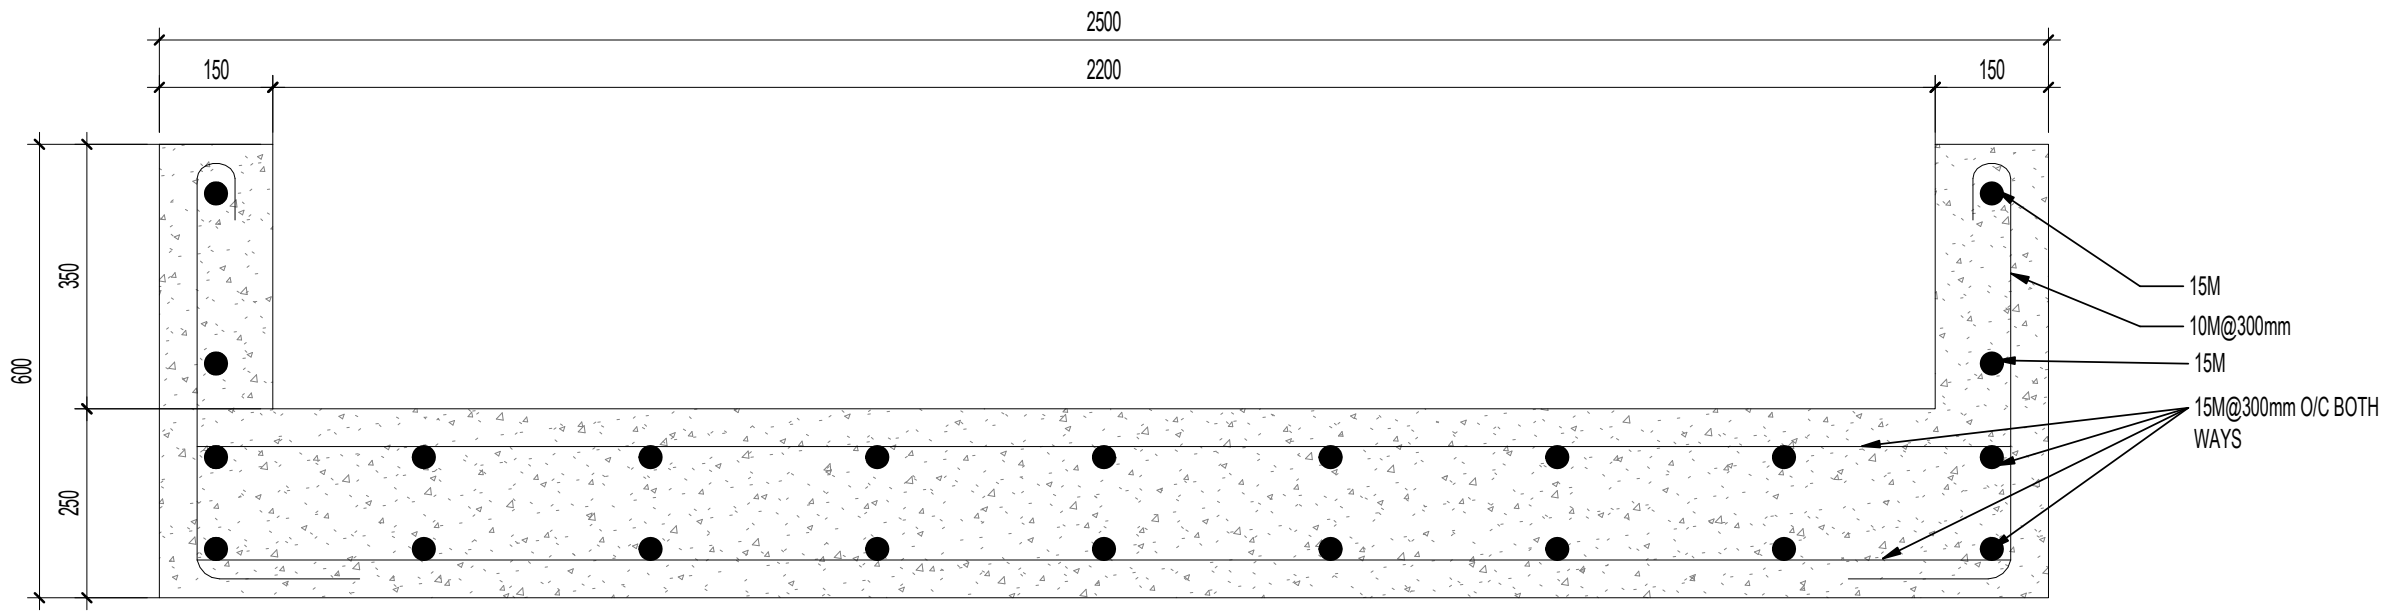

4 FUEL TANK FOUNDATION PAD SECTION
S503 1 : 10



Stantec Architecture Ltd.
2nd Floor 4910 53 Street
PO Box 1777
Yellowknife, NT X1A 2P4
Tel: (867) 920-2882 • www.stantec.com

Copyright Reserved

The Contractor shall verify and be responsible for all dimensions. DO NOT scale the drawing - any errors or omissions shall be reported to Stantec without delay.
The Copyrights to all designs and drawings are the property of Stantec. Reproduction or use for any purpose other than that authorized by Stantec is forbidden.

Consultant

Notes


Revision

C	ISSUED FOR CONSTRUCTION	JP	MJW	2018.09.11
B	ISSUED FOR 100%	JP	MJW	2018.07.13
A	ISSUED FOR 70%	JP	MJW	2018.03.13

Issued

File Name: N/A	Author: Dwn.	Designer: Dsgn.	Checker: Chkd.	06/22/18
				YYYY.MM.DD

Permit/Seal

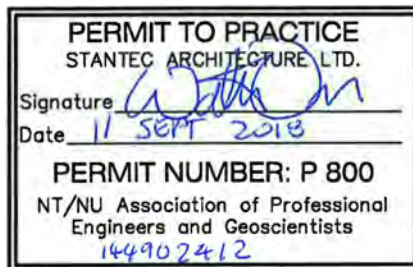

Client/Project Logo



Client/Project
GOVERNMENT OF NORTHWEST TERRITORIES

BUNDLED WATER TREATMENT PLANTS

WEKWEETI, NT

Title
DETAILS

Project No.

144902412


Revision

Scale

1 : 10

Drawing No.

S503

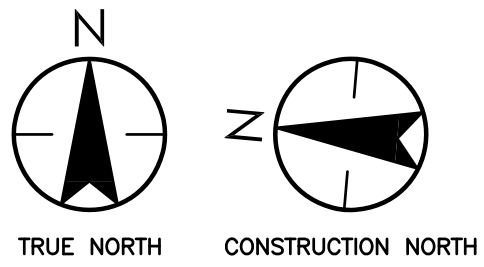

CONTROL EQUIPMENT LEGEND


UNIT #	EQUIPMENT
AI	ANALOG INPUT
AO	ANALOG OUTPUT
CS	CURRENT SENSOR, SIZED FOR SERVICE
DI	DIGITAL INPUT
DO	DIGITAL OUTPUT
LC	LEVEL CONTROLLER
PS	PRESSURE SWITCH
TX	TRANSFORMER

CONTROLS LEGEND

DAMPER	
HUMIDIFIER	
FILTER	
FILTER	
COIL (HEATING AND/OR COOLING)	
PRESSURE SENSOR	
AIR FLOW SWITCH	
PROBE SENSOR	
AVERAGING SENSOR	
DIFFERENTIAL PRESURE SENSOR	
DEVICE TAG	
POINT TAG	
MOTOR STARTER	
THERMAL OVERLOAD	
TRANSFORMER	
PUMP	
2-WAY CONTROL VALVE	
3-WAY CONTROL VALVE	
VARIABLE FREQUENCY DRIVE	
THREE WIRE	
TWO WIRE	
LIGHT	
FAN	

HVAC SYMBOLS

###x###	RECTANGULAR DUCT
###	ROUND DUCT
	SQUARE ELBOW TURN (EXHAUST UP/DOWN)
	SQUARE ELBOW TURN (INTAKE UP/DOWN)
	ELBOW, ROUND, SMOOTH RADIUS (1.5 R/W DEFAULT)
	TRANSITION, RECTANGULAR, PYRAMIDAL (30° CONTRACTUAL ANGLE DEFAULT)
	THERMOSTAT
	LINEAR DIFFUSER
	AIR FLOW ARROWS
	ELECTRIC UNIT HEATER TAG (REFER TO SCHEDULE)
	AIR OUTLET TAG (REFER TO SCHEDULE)

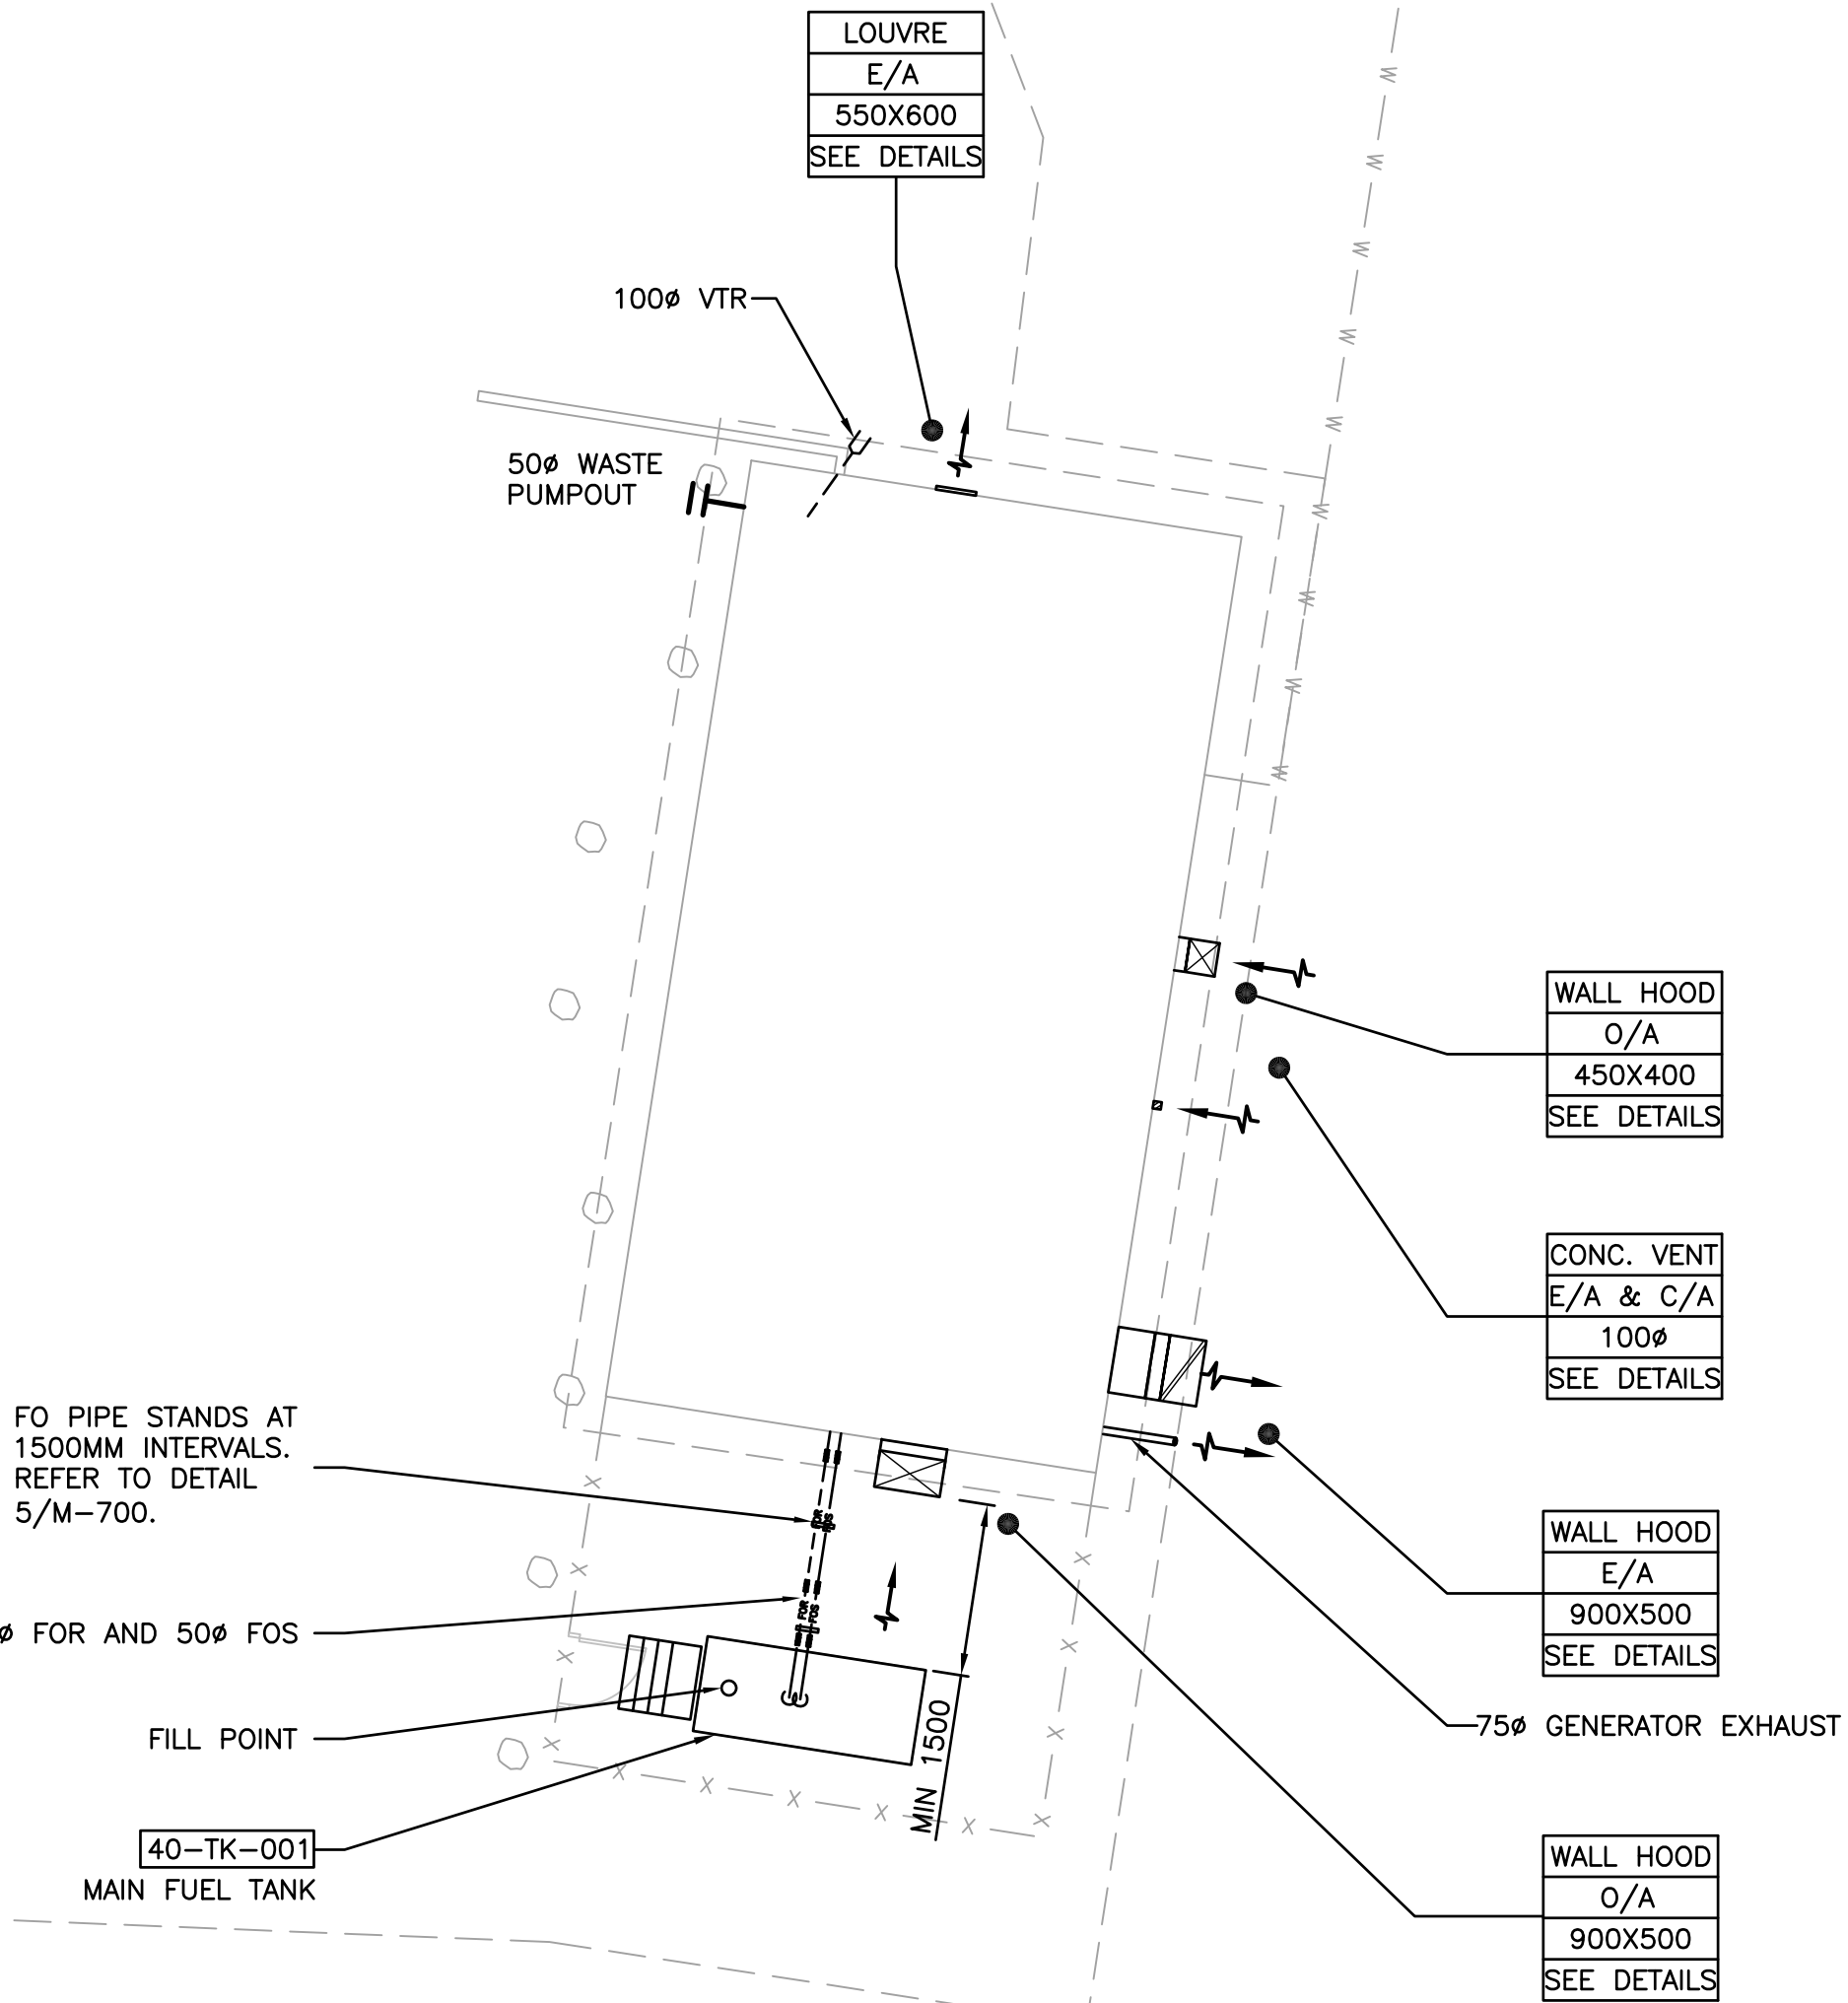

1 WEKWEETI WTP SITE PLAN
M-010 1:100

PIPING IDENTIFICATION AND SYMBOLS

	FUEL OIL SUCTION
	FUEL OIL RETURN
	SANITARY DRAIN (ABOVE GRADE OR FLOOR)
	SANITARY DRAIN (BELOW GRADE OR FLOOR)
	VENT
	DOMESTIC COLD WATER
	DOMESTIC HOT WATER
	RAW WATER
	FLOW SWITCH
	PUMP (REFER TO SCHEDULE)
	PLUMBING FIXTURES
	PRESSURE GAUGE AND COCK
	SHOCK ABSORBER WITH HAMMER
	UNION CONNECTION
	FLANGED CONNECTION
	SIGHT FLOW GLASS
	FLEXIBLE CONNECTOR

	ELECTRIC SOLENOID OPERATED VALVE ACTUATOR
	PNEUMATIC MOTOR OPERATED VALVE ACTUATOR
	SANITARY VENT
	RELIEF (R) OR SAFETY (S) VALVE
	ANGLE GATE VALVE (WITHOUT ACTUATOR)
	THREE WAY VALVE (WITHOUT ACTUATOR)
	VACUUM BREAKER
	PLUMBING FIXTURE TAG (REFER TO SCHEDULE)
	MANUAL AIR VENT
	AUTOMATIC AIR VENT

	THERMOMETER
	BACKFLOW PREVENTER, REDUCED PRESSURE ZONE (RP2) TYPE
	GUIDE
	INTERMEDIATE ANCHOR
	HOSE BIBB
	PIPE CAP
	PIPE BREAK
	FLOW ARROW
	PIPING ELBOW DOWN
	PIPING ELBOW UP
	PIPING TEE UP
	PIPING TEE DOWN
	PIPING TEE
	SANITARY/STORM PIPING DOWN
	SANITARY/STORM PIPING UP
	SANITARY/STORM TEE UP
	SANITARY/STORM TEE DOWN

	SANITARY/STORM BRANCH
	STANDARD CLEAN-OUT IN LINE END OF RUN
	STANDARD CLEAN-OUT THROUGH FLOOR IN LINE
	PIPING SLOPE
	FIXTURE TRAP
	GATE VALVE
	GLOBE VALVE
	PRESSURE REDUCING VALVE
	SWING GATE CHECK VALVE
	BALL VALVE
	BALANCING VALVE
	PLUG VALVE
	BUTTERFLY VALVE
	Y STRAINER
	BLOW OFF Y STRAINER
	ANTI-VACUUM VALVE



STANTEC ARCHITECTURE LTD.
4910 53rd St
Yellowknife, NT, Canada X1A 2P4
Tel. 867.920.2882
www.stantec.com

Copyright Reserved

The Contractor shall verify and be responsible for all dimensions. DO NOT scale the drawing - any errors or omissions shall be reported to Stantec without delay.
The Copyrights to all designs and drawings are the property of Stantec. Reproduction or use for any purpose other than that authorized by Stantec is forbidden.

Consultants



Legend

Notes

Revision	By	Appd.	YY.MM.DD
C	ISSUED FOR CONSTRUCTION	JMH	BM 18.09.11
B	ISSUED FOR 100% REVIEW	JMH	BM 18.07.13
A	ISSUED FOR 70% REVIEW	JMH	BM 18.04.13
Issued		By	Appd. YY.MM.DD

File Name:	Dwn.	Chkd.	Dsgn.	YY.MM.DD
------------	------	-------	-------	----------

Permit-Seal

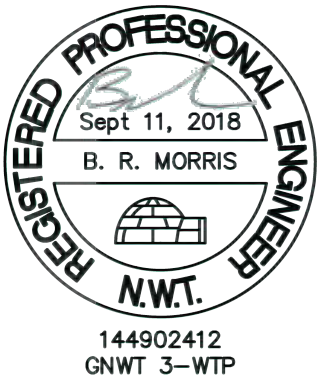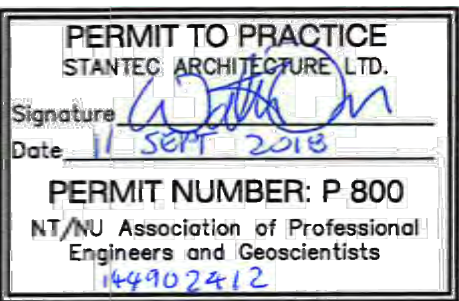

Client/Project

GOVERNMENT OF THE
NORTHWEST TERRITORIES

BUNDLED WATER TREATMENT PLANT

Wekweeti, NT

Title

WEKWEETI WTP
SITE PLAN

Project No. 144902412	Scale AS NOTED	Revision
Drawing No.	Sheet	Revision


M-010

1 of 6


C/



M-100 2 of 6 C/

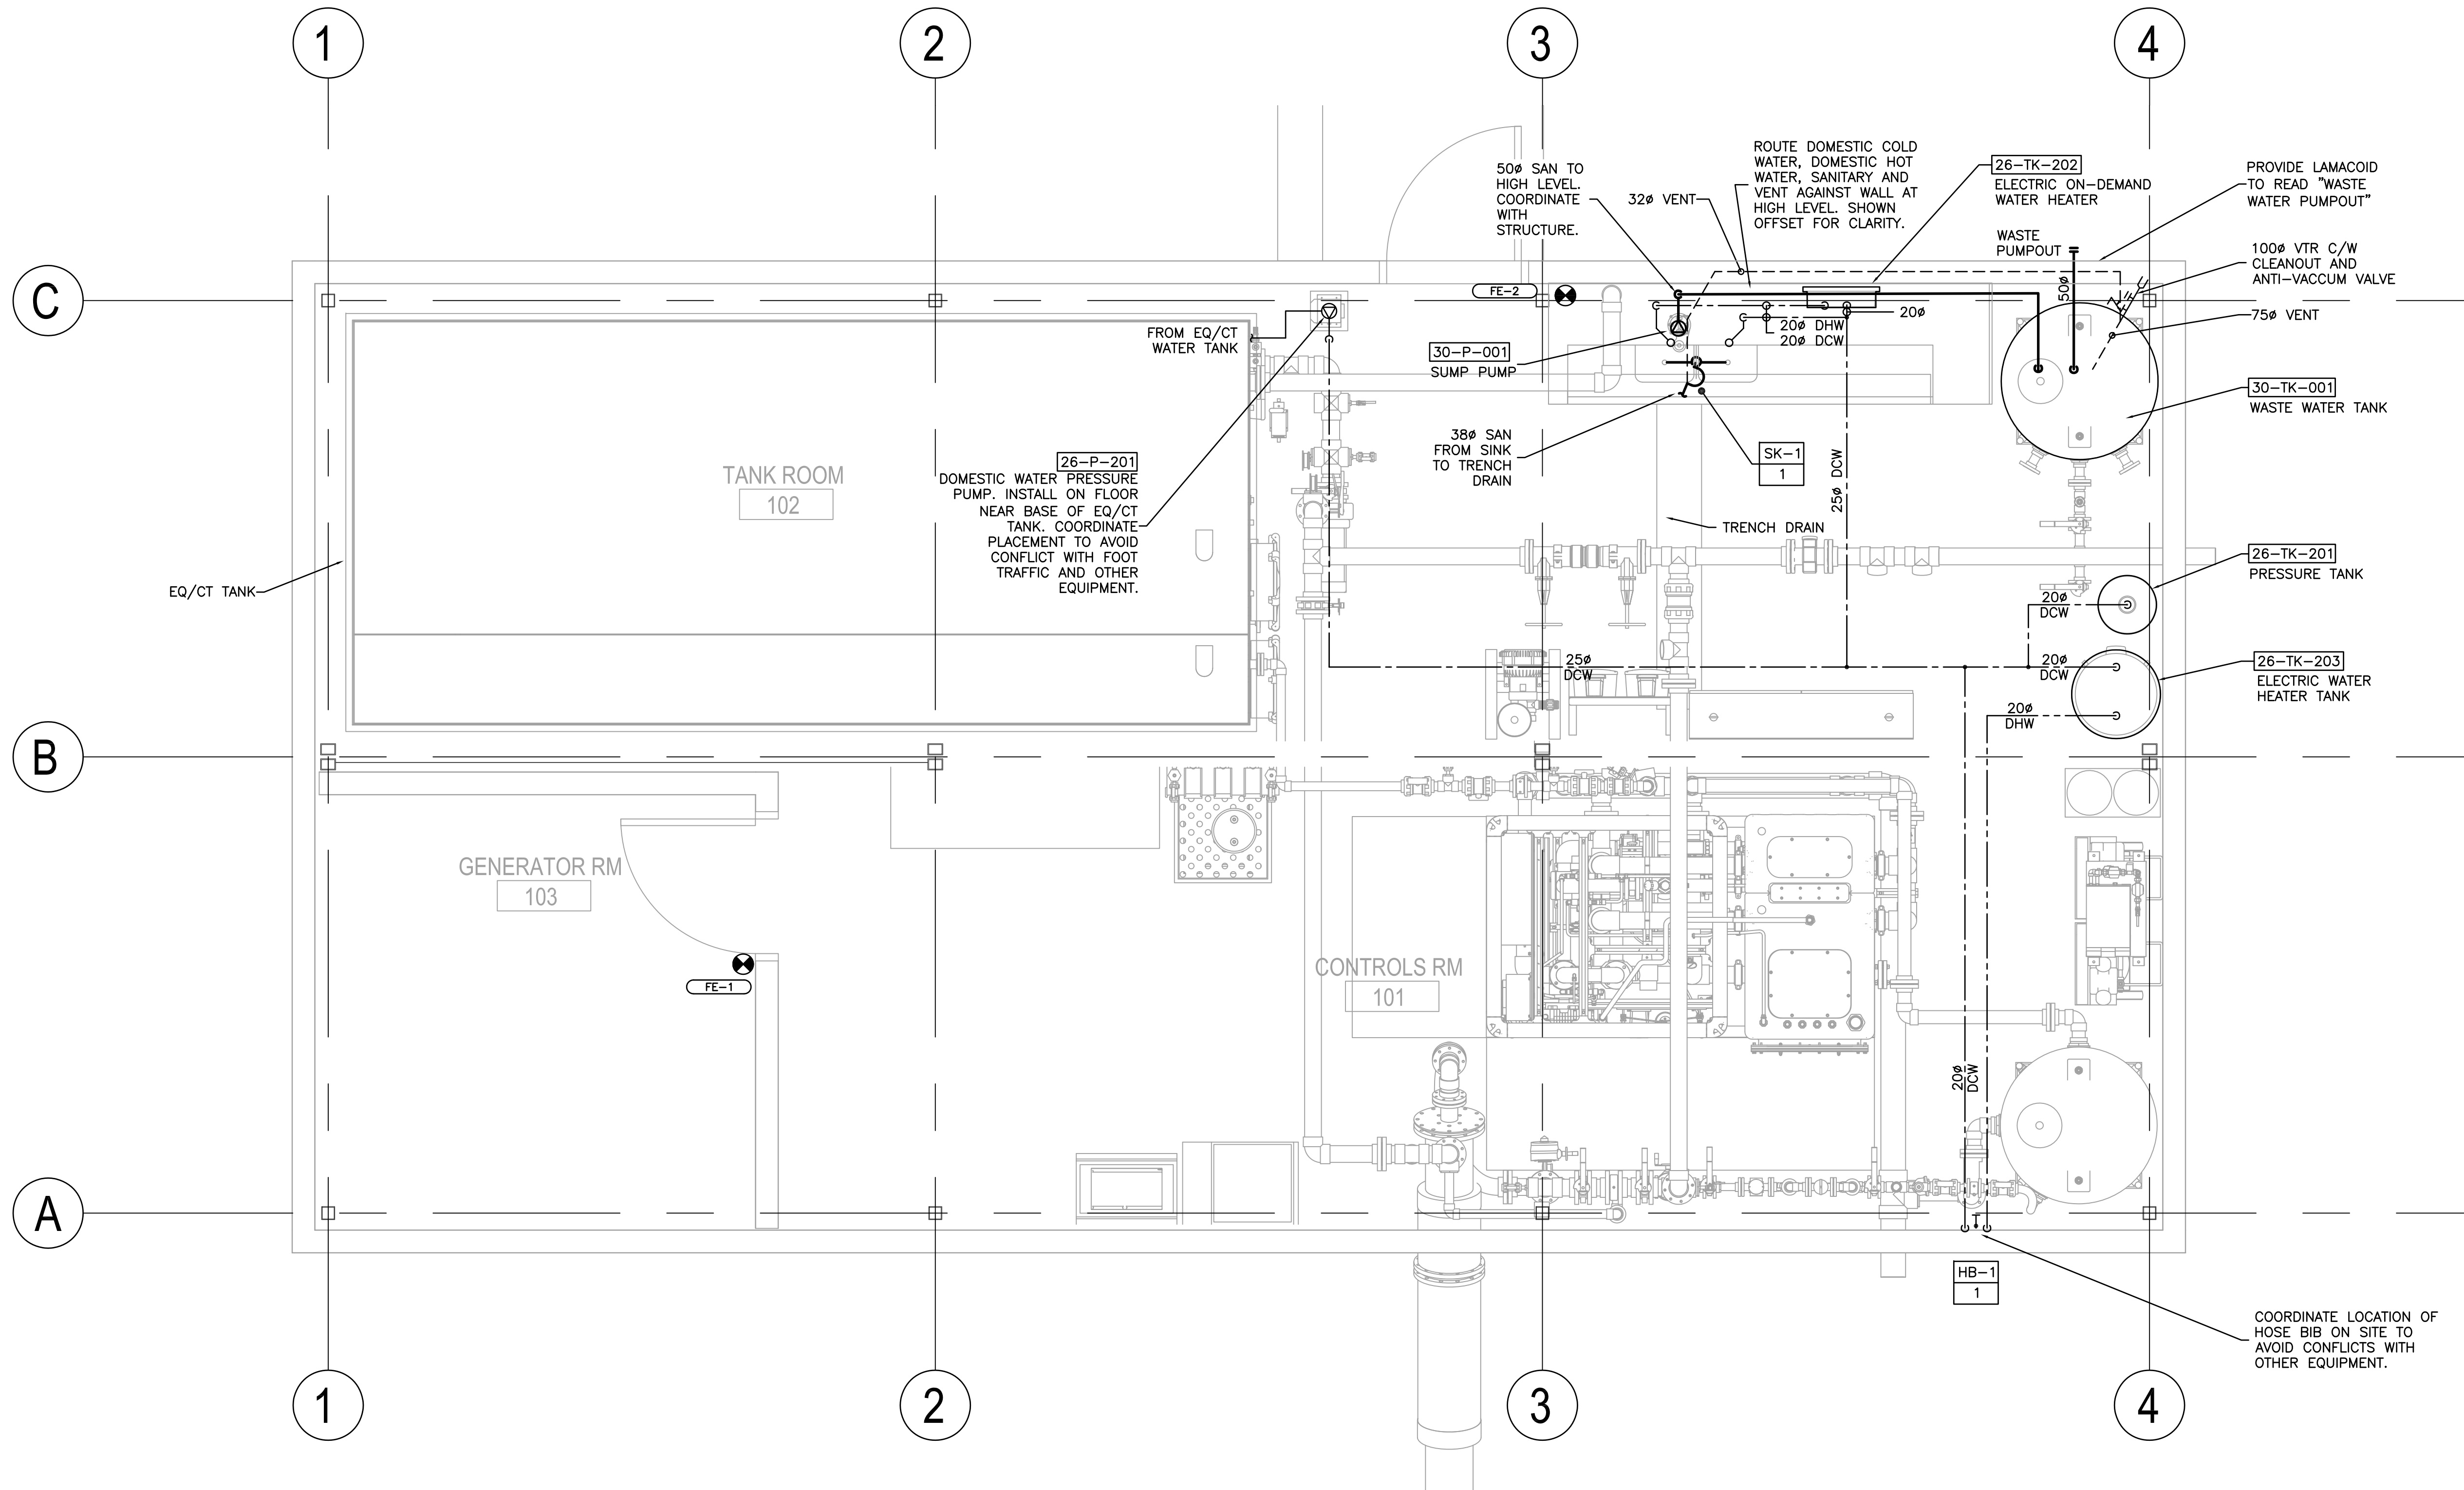



1 WEKWEETI WTP PLUMBING PLAN
M-100 1:25

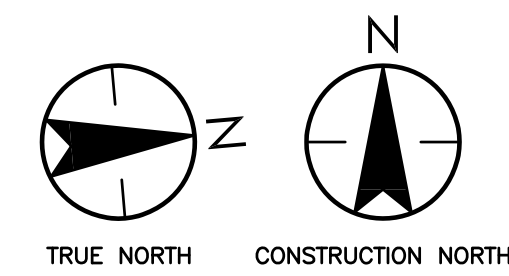

Revision	By	Appd.	YY.MM.DD
C	JMH	BM	18.09.11
B	JMH	BM	18.07.13
A	JMH	BM	18.04.13

File Name:	Dwn.	Chkd.	Dgn.	YY.MM.DD


Permit-Seal

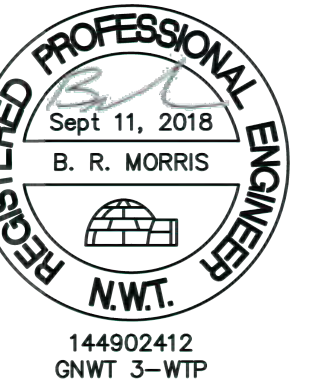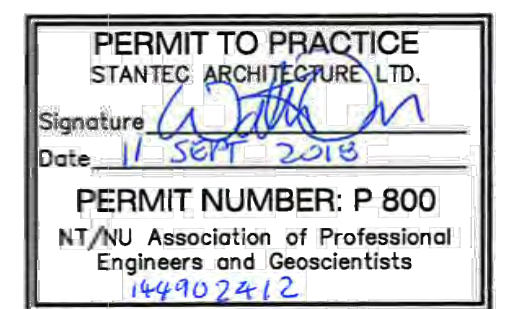

Client/Project
GOVERNMENT OF THE
NORTHWEST TERRITORIES
BUNDLED WATER TREATMENT PLANT
Wekweeti, NT

Title
WEKWEETI WTP
HVAC PLAN

Project No.	Scale	
144902412	AS NOTED	
Drawing No.	Sheet	Revision
M-200	3 of 6	C/

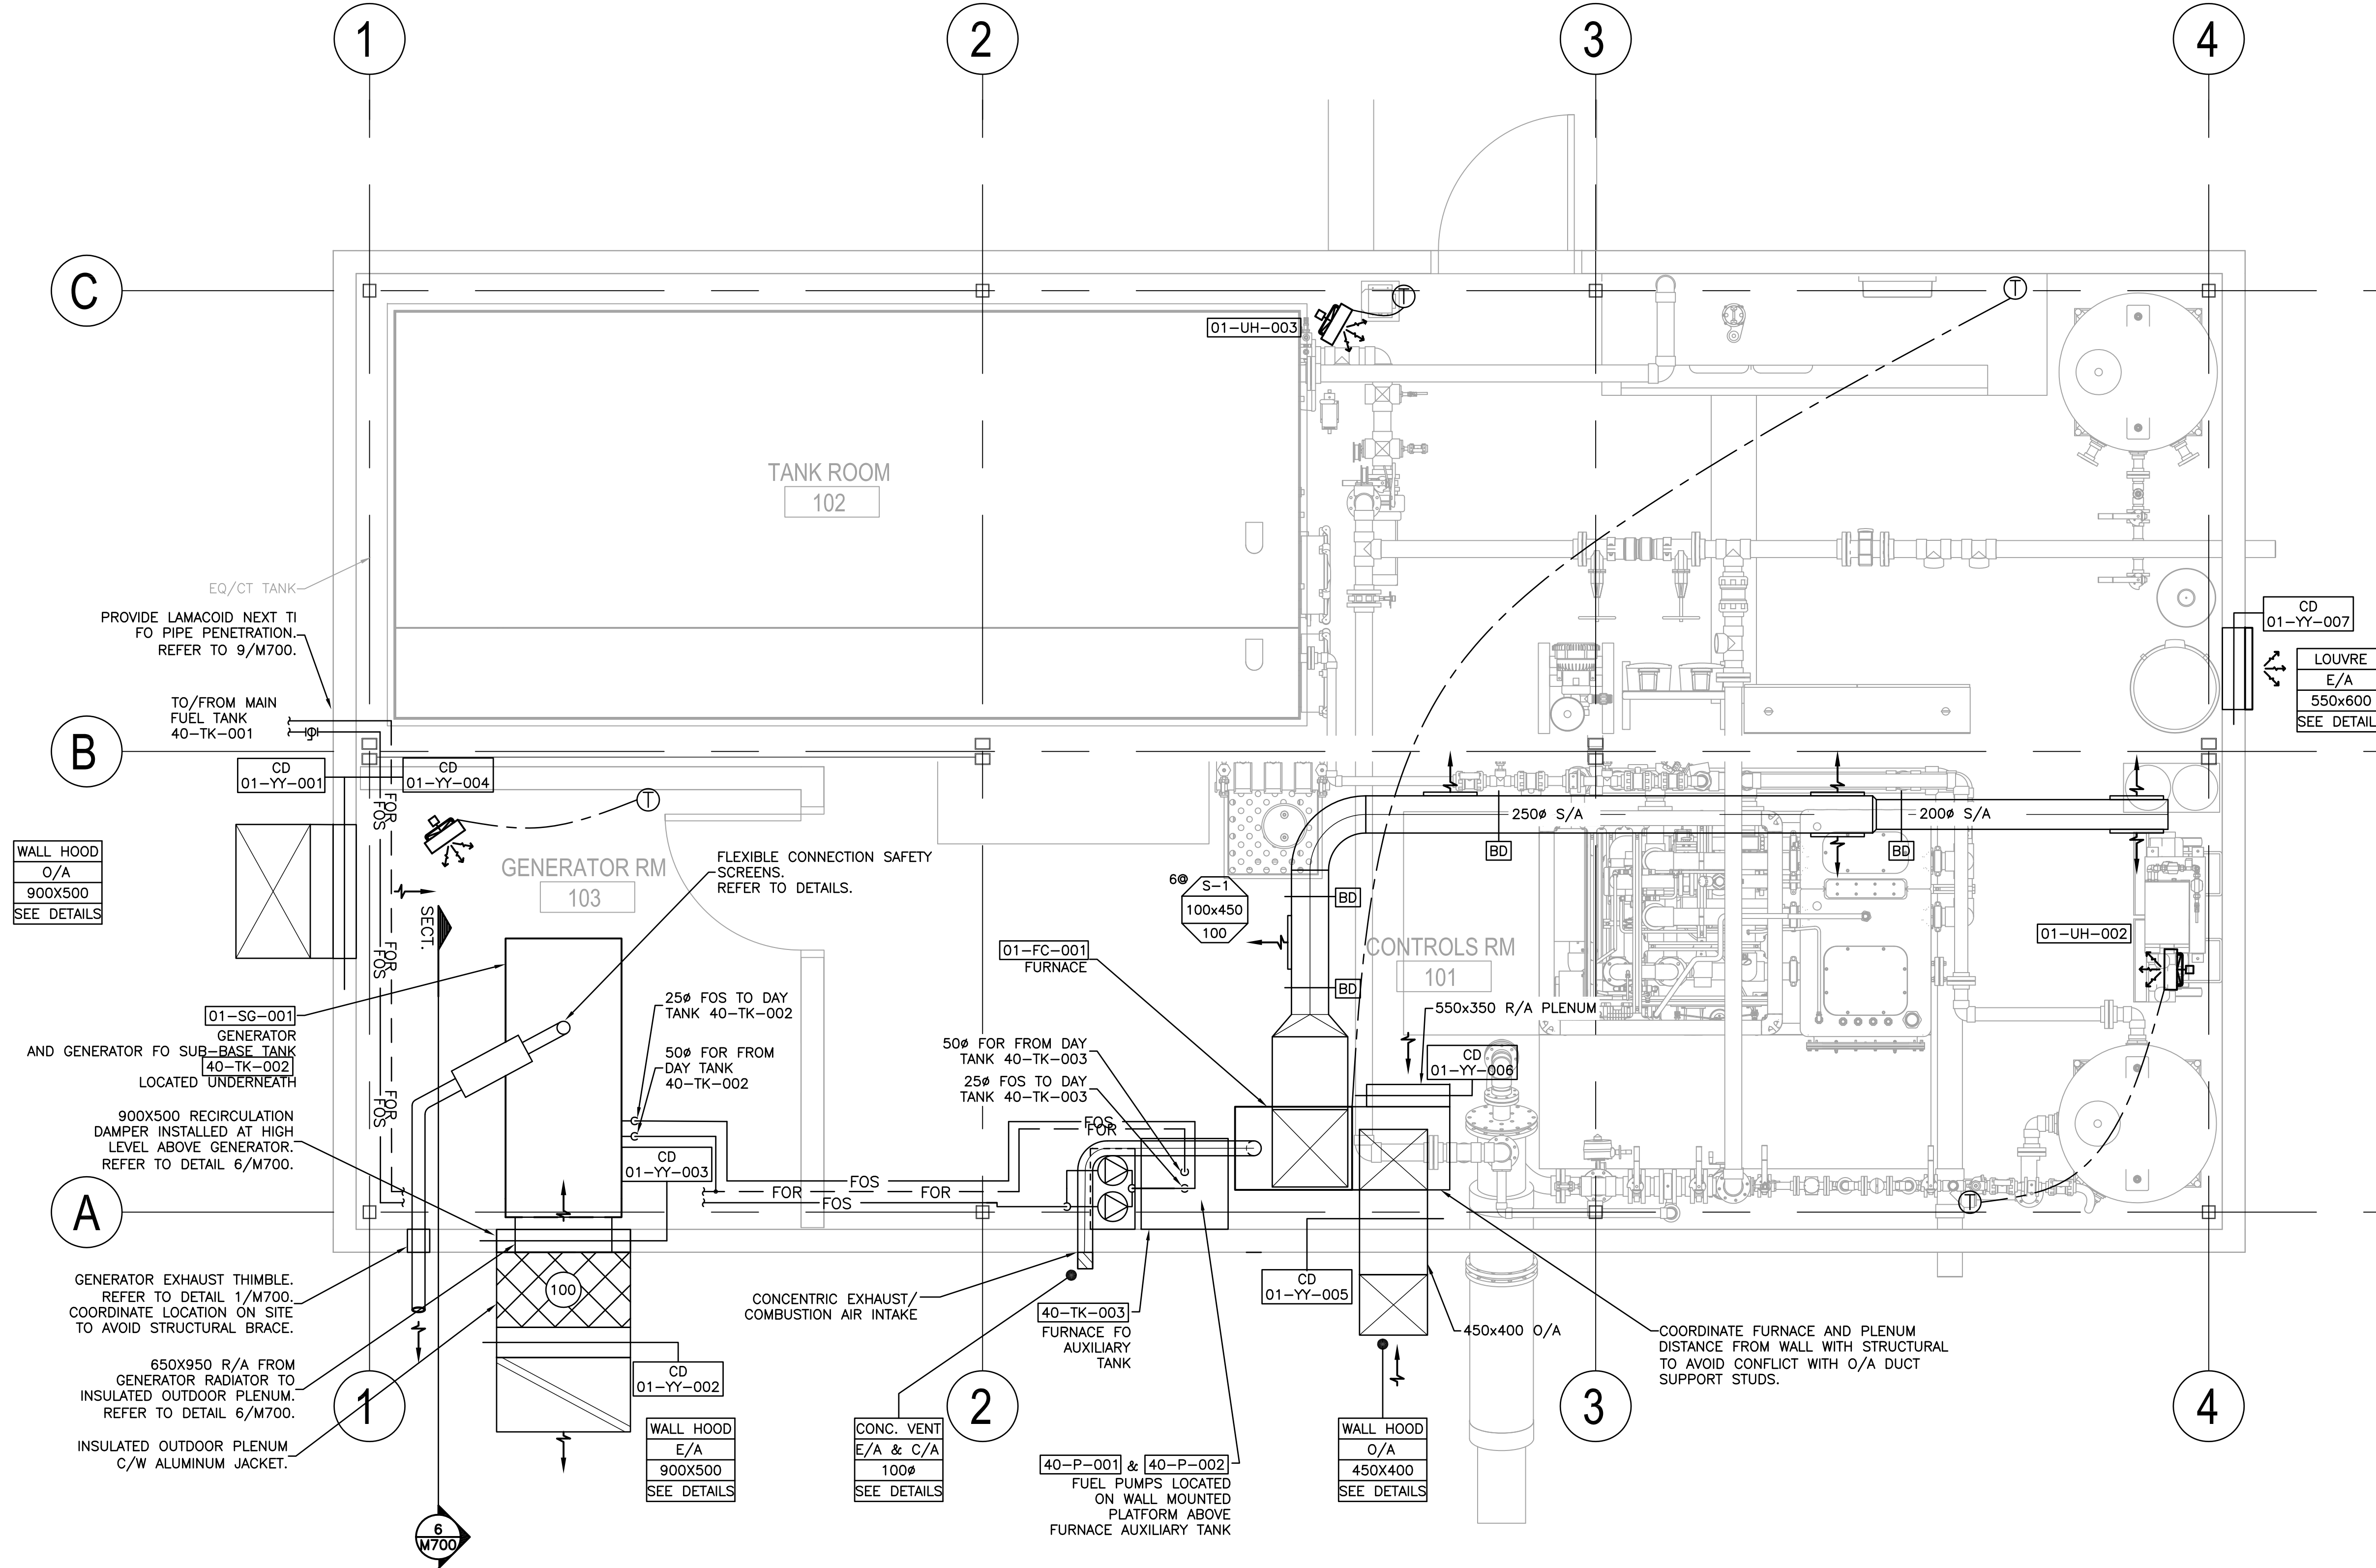



1 WEKWEETI WTP HVAC PLAN
M-200 1:25

Revision	By	Appd.	YY.MM.DD
C	JMH	BM	18.09.11
B	JMH	BM	18.07.13
A	JMH	BM	18.04.13

Issued

File Name: Dwn. Chkd. Dgn. YY.MM.DD

Permit-Seal

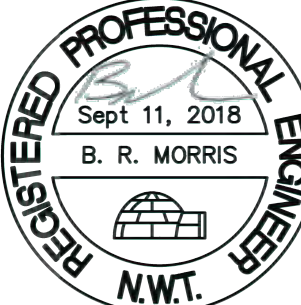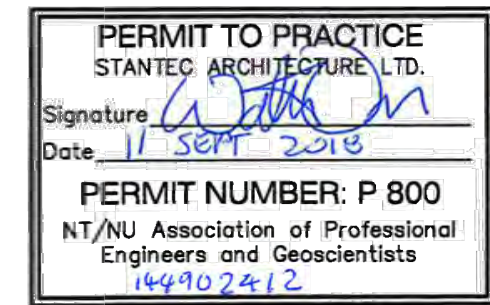

Client/Project

GOVERNMENT OF THE
NORTHWEST TERRITORIES

BUNDLED WATER TREATMENT PLANT

Wekweeti, NT

Title
SCHEMATIC







Project No. 144902412 Scale AS NOTED

Drawing No. Sheet Revision

M-600

4 of 6

C/

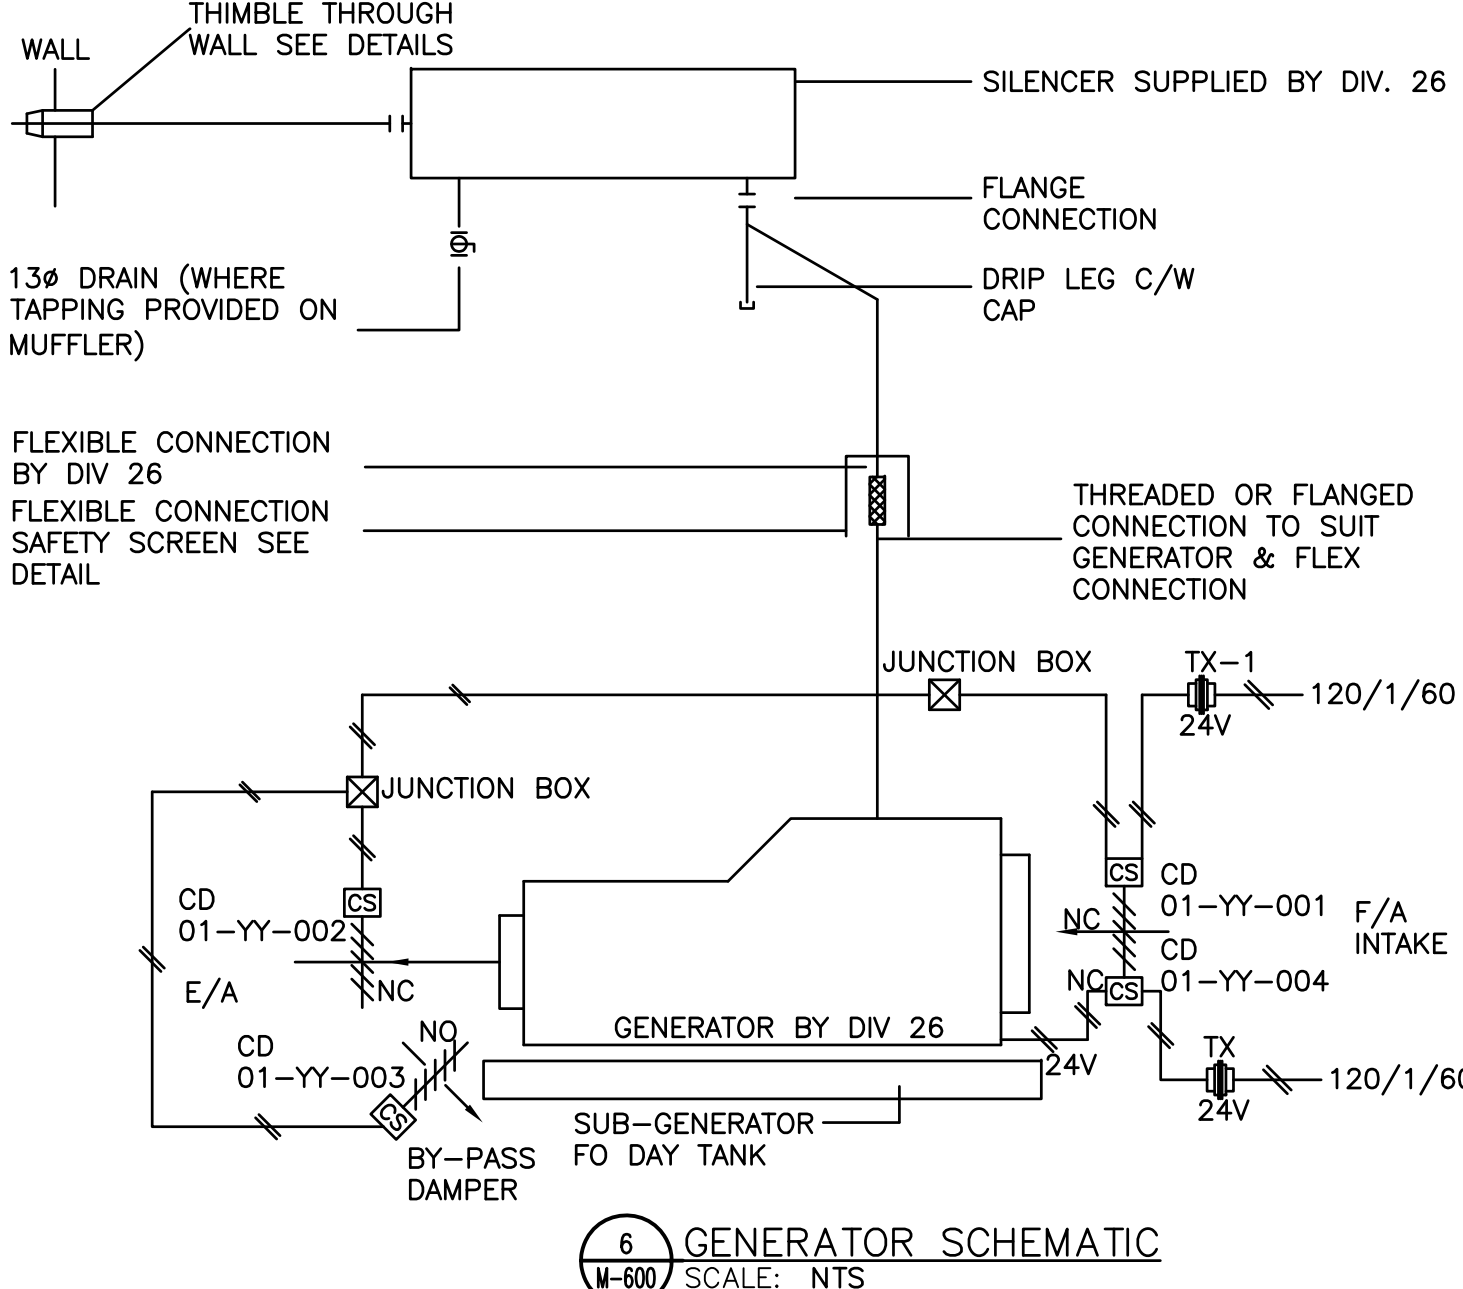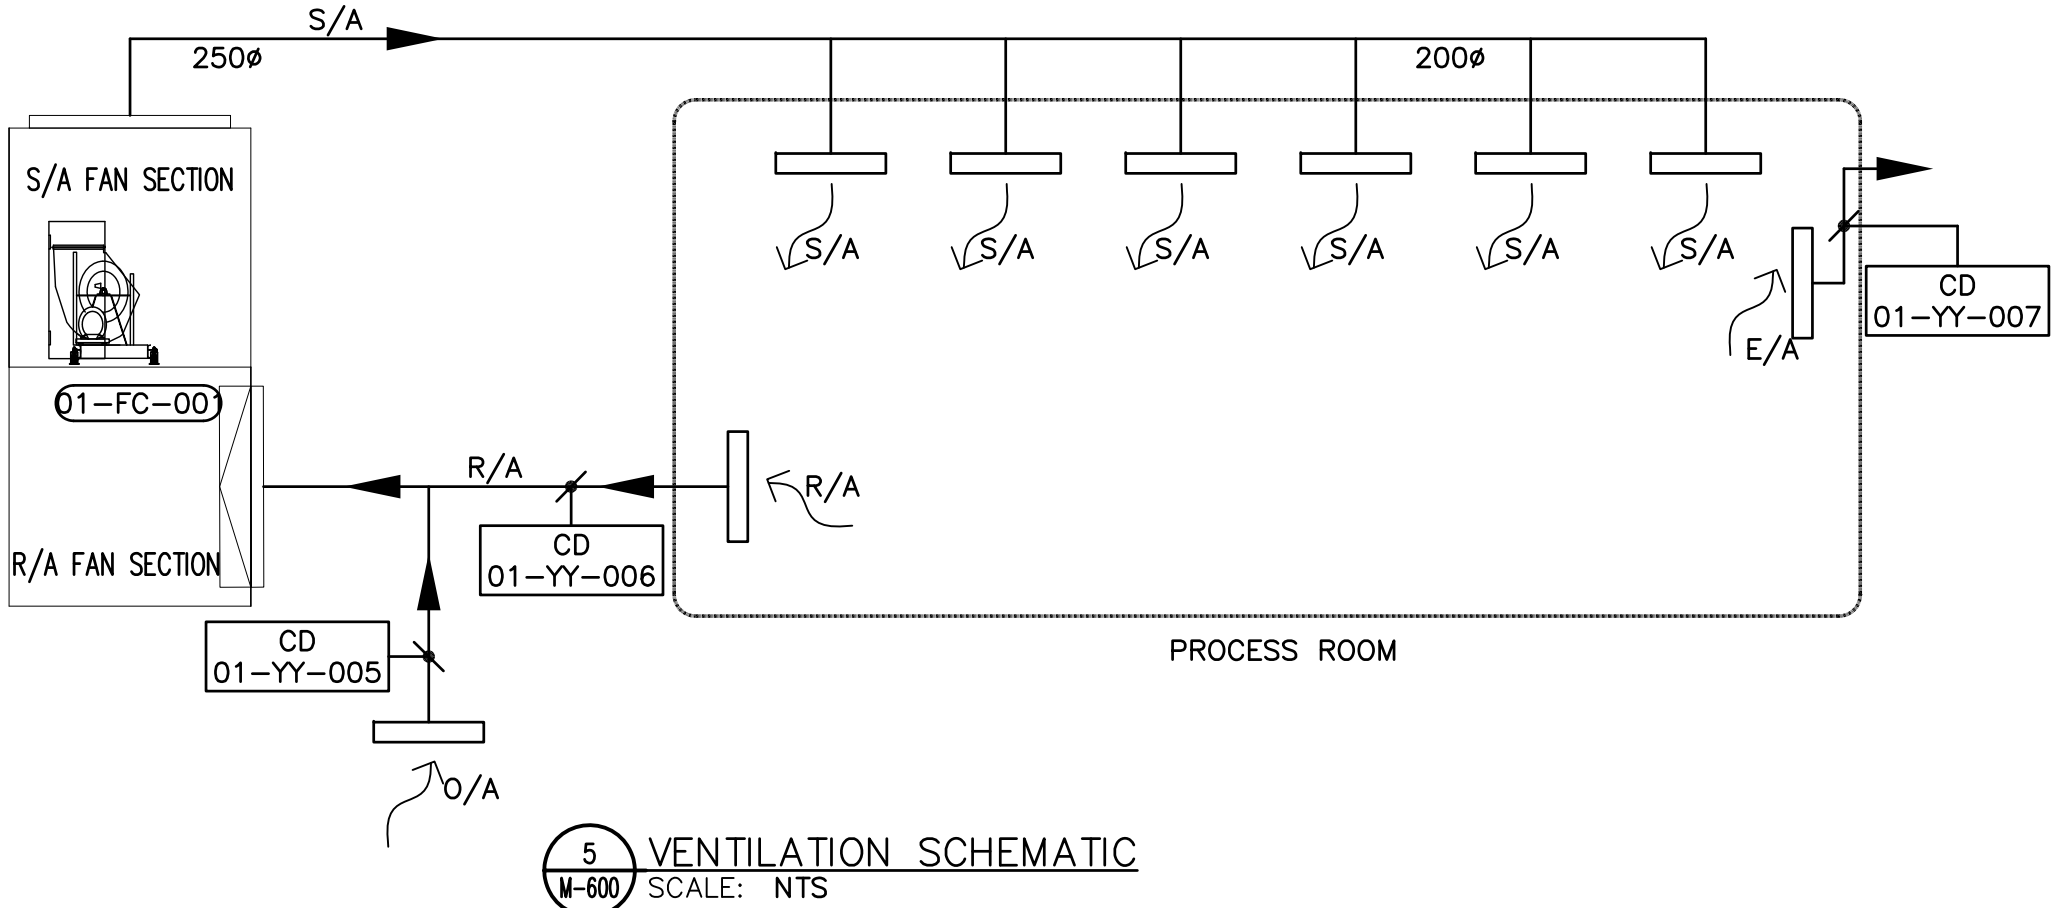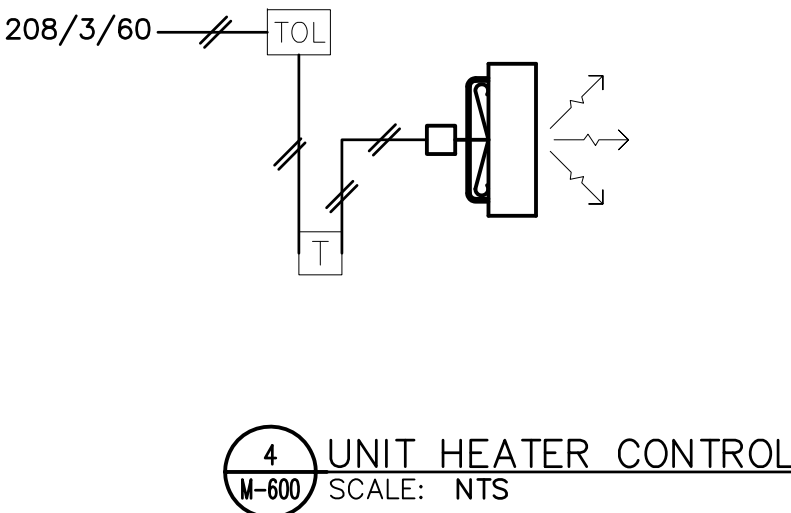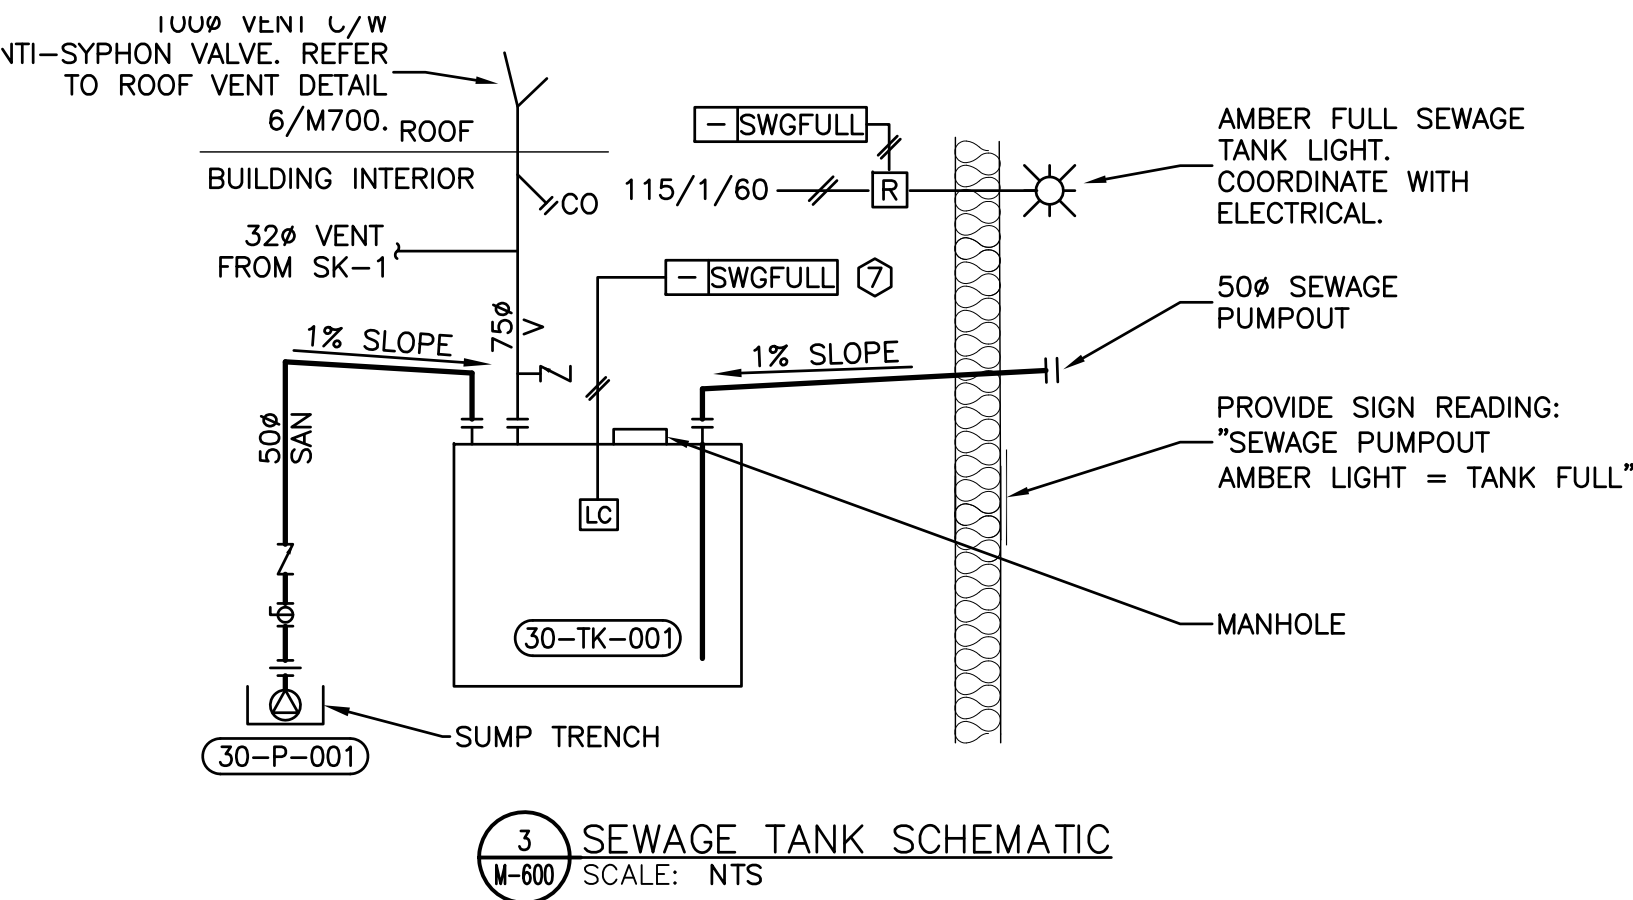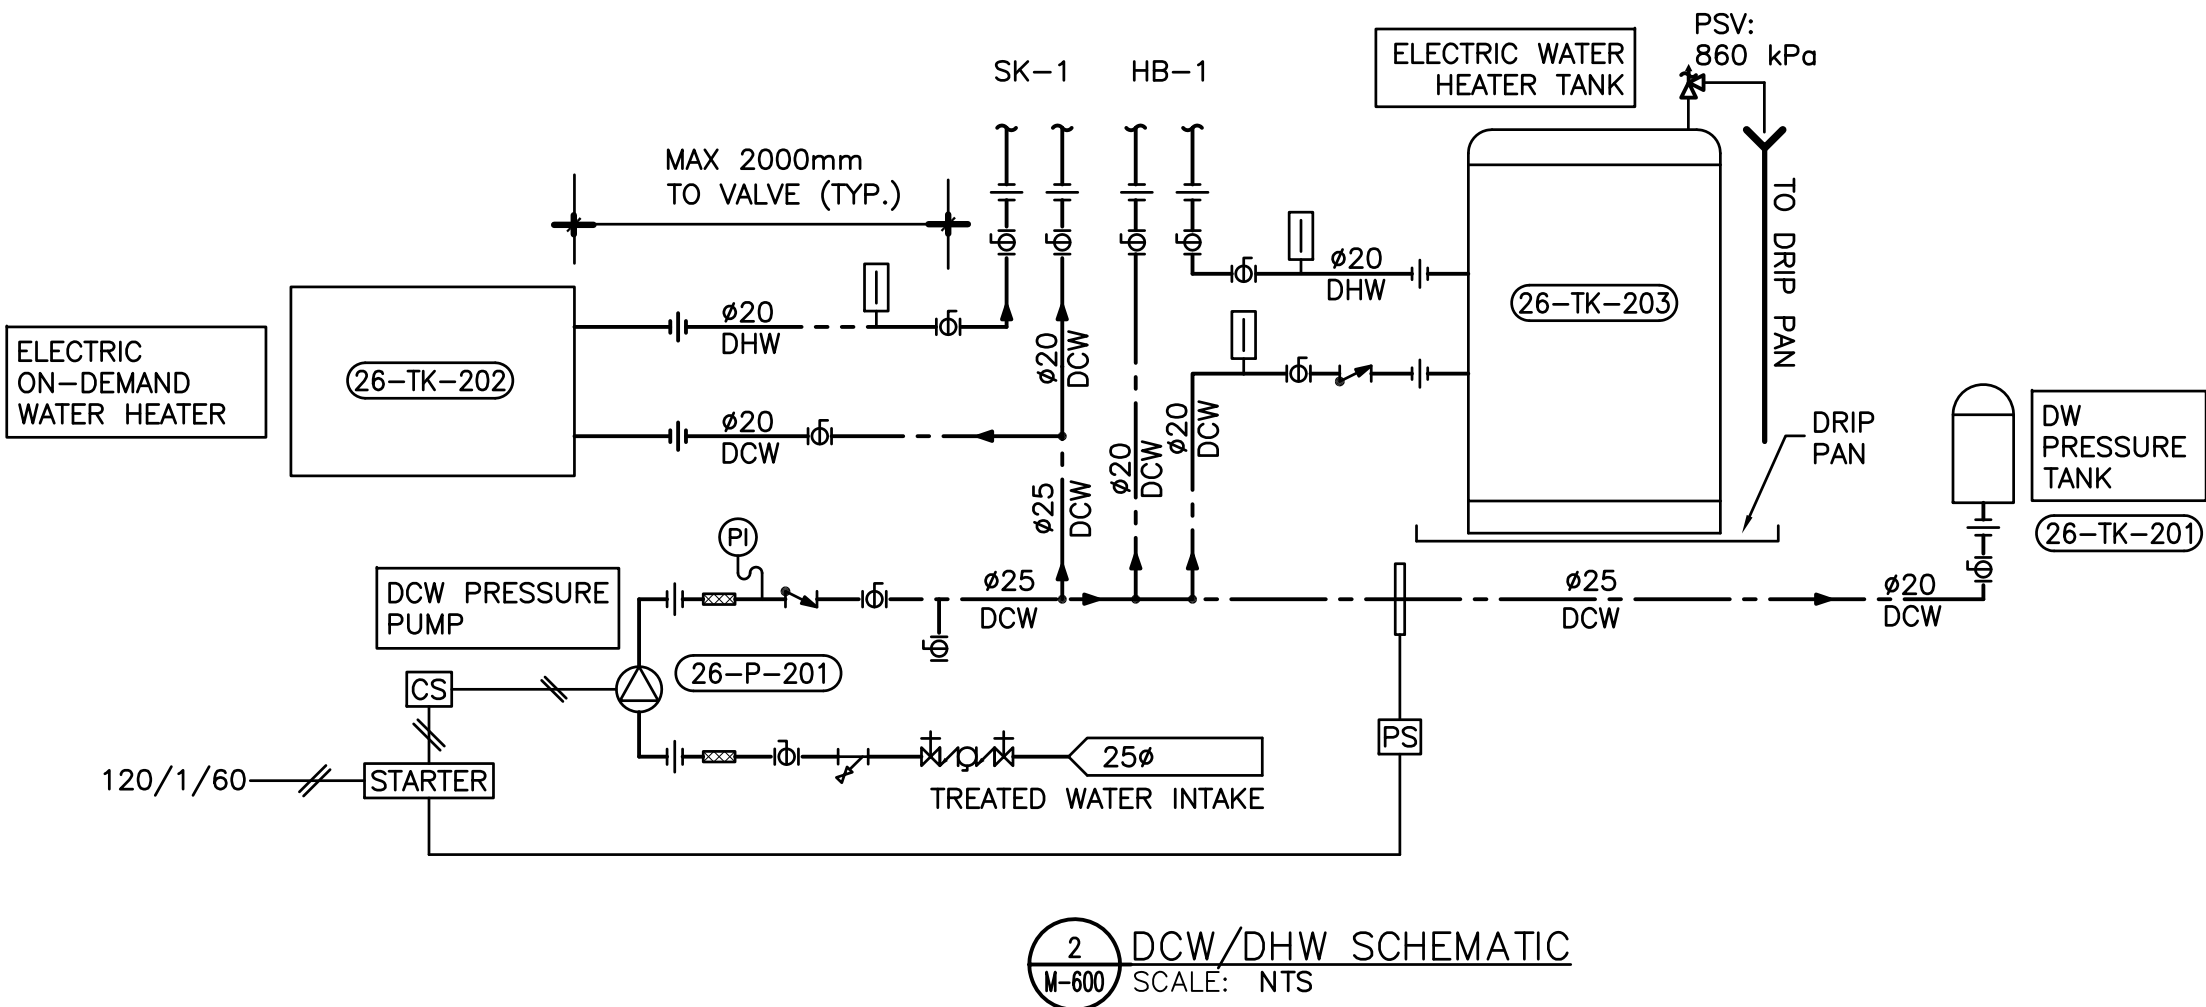
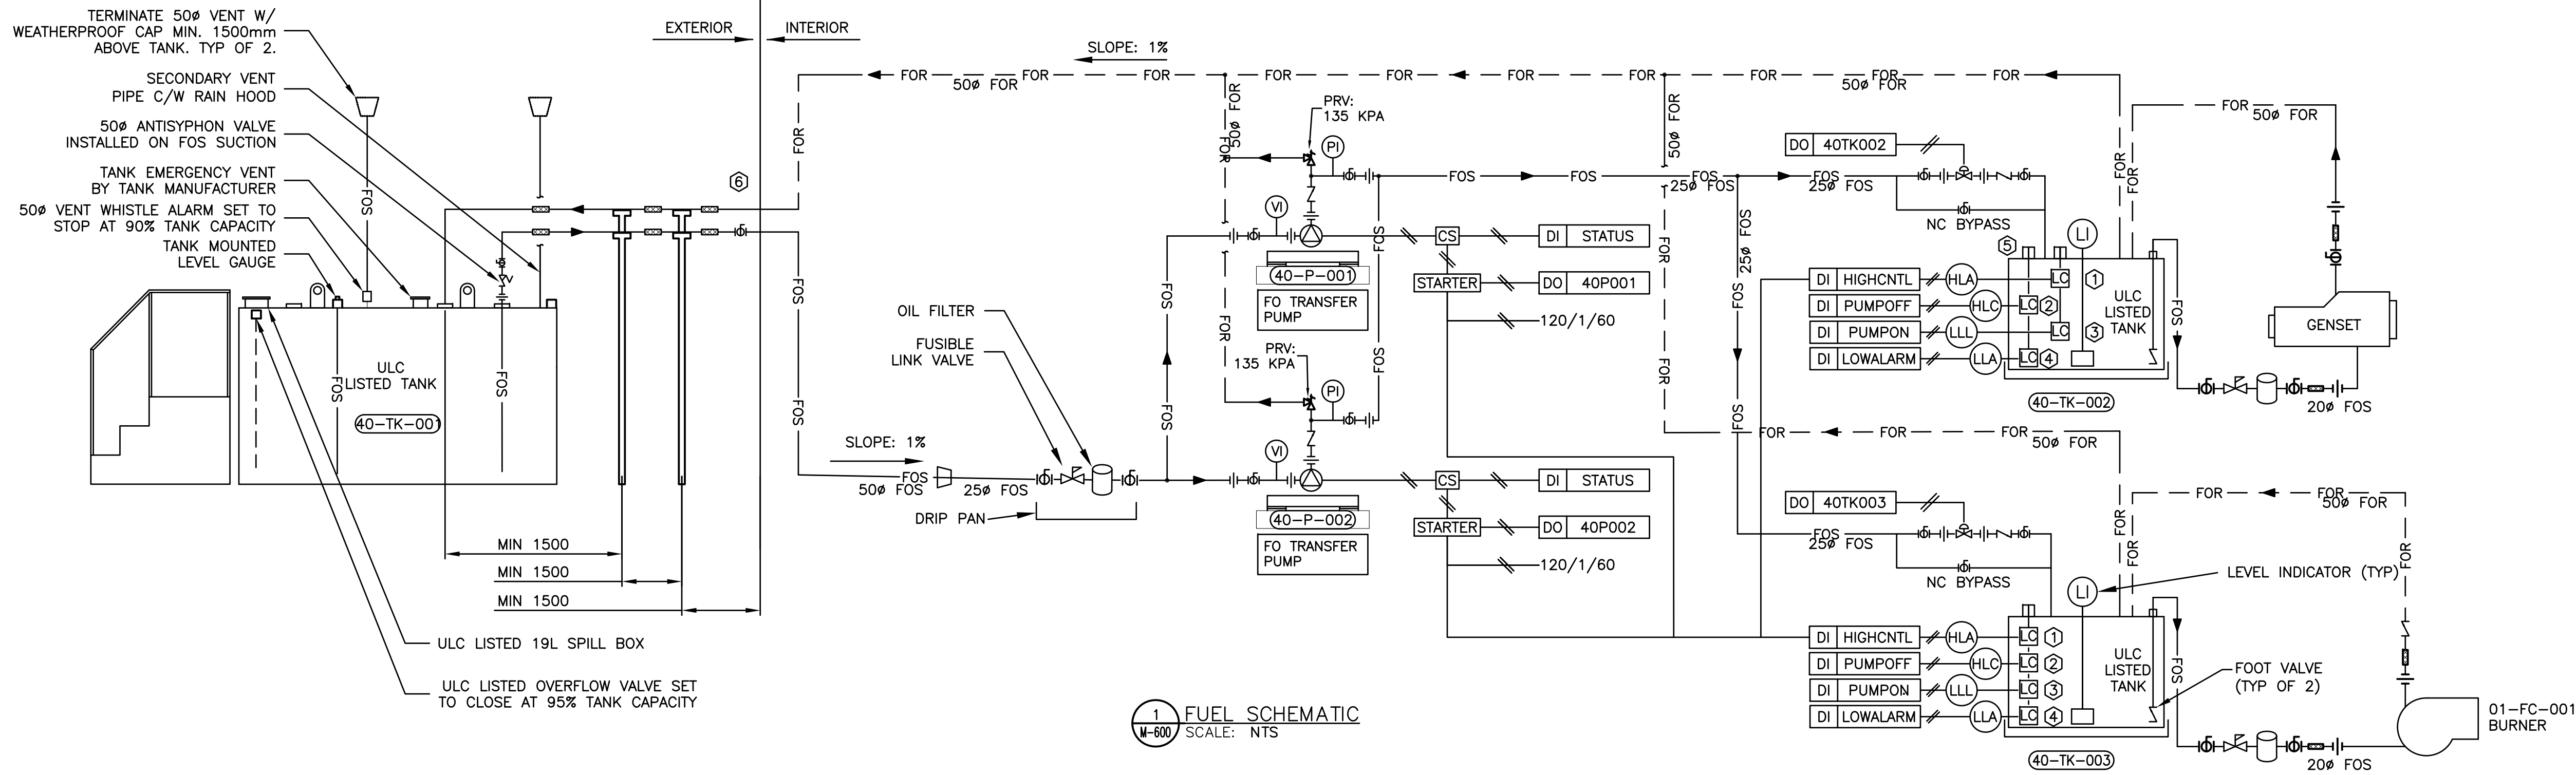


- KEYNOTES SCHEMATIC:**
- ① HLA TO BE SET AT 95% OF TANK VOLUME - HIGH LEVEL.
 - ② HLC TO BE SET AT 90% OF TANK VOLUME - PUMP OFF.
 - ③ LLL TO BE SET AT 50% OF TANK VOLUME - PUMP ON.
 - ④ LLA TO BE SET AT 30% OF TANK VOLUME - LOW LEVEL ALARM.
 - ⑤ PROVIDE 2 INDEPENDENT FLOAT SWITCH ASSEMBLIES WITH 2 FLOATS EACH TO ACCOMMODATE LOW VERTICAL DIMENSION OF SUBBASE TANK
 - ⑥ PROVIDE SIGNALS FOR ISOLATION VALVE AS PER DETAIL 9/M700.
 - ⑦ SANITARY TANK HIGH LEVEL ALARM TO ACTIVATE AMBER LIGHT WHEN TANK IS 80% FULL.

Revision	By	Appd.	YY.MM.DD
C ISSUED FOR CONSTRUCTION	JMH	BM	18.09.11
B ISSUED FOR 100% REVIEW	JMH	BM	18.07.13
A ISSUED FOR 70% REVIEW	JMH	BM	18.04.13
Issued	By	Appd.	YY.MM.DD

File Name: _____ Dwn. Chkd. Dgn. YY.MM.DD

Permit-Seal

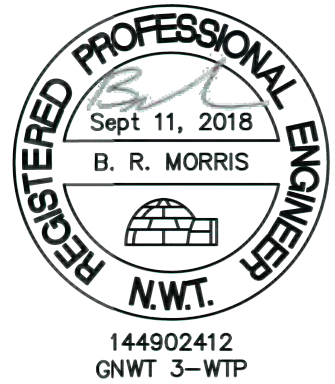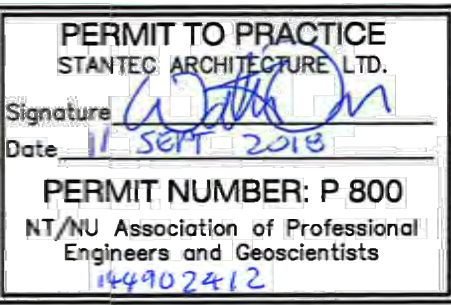








Client/Project
GOVERNMENT OF THE
NORTHWEST TERRITORIES
BUNDLED WATER TREATMENT PLANT

Wekweeti, NT


Title
DETAILS

Project No. 144902412 Scale AS NOTED

Drawing No. M-700 Sheet 5 of 6 Revision C/

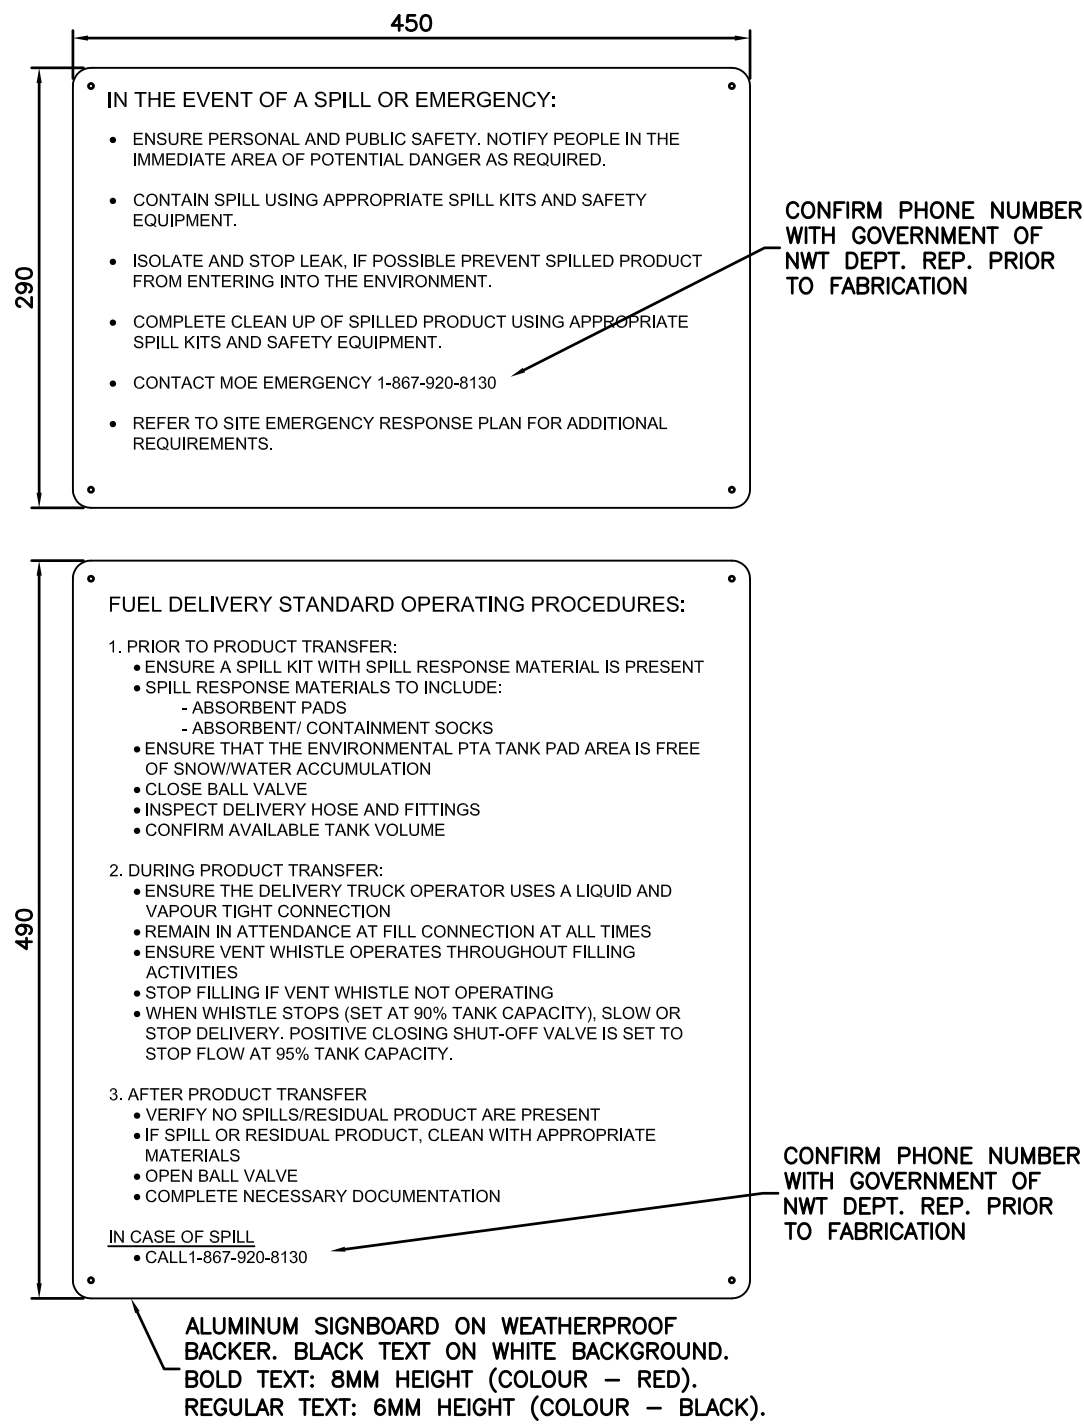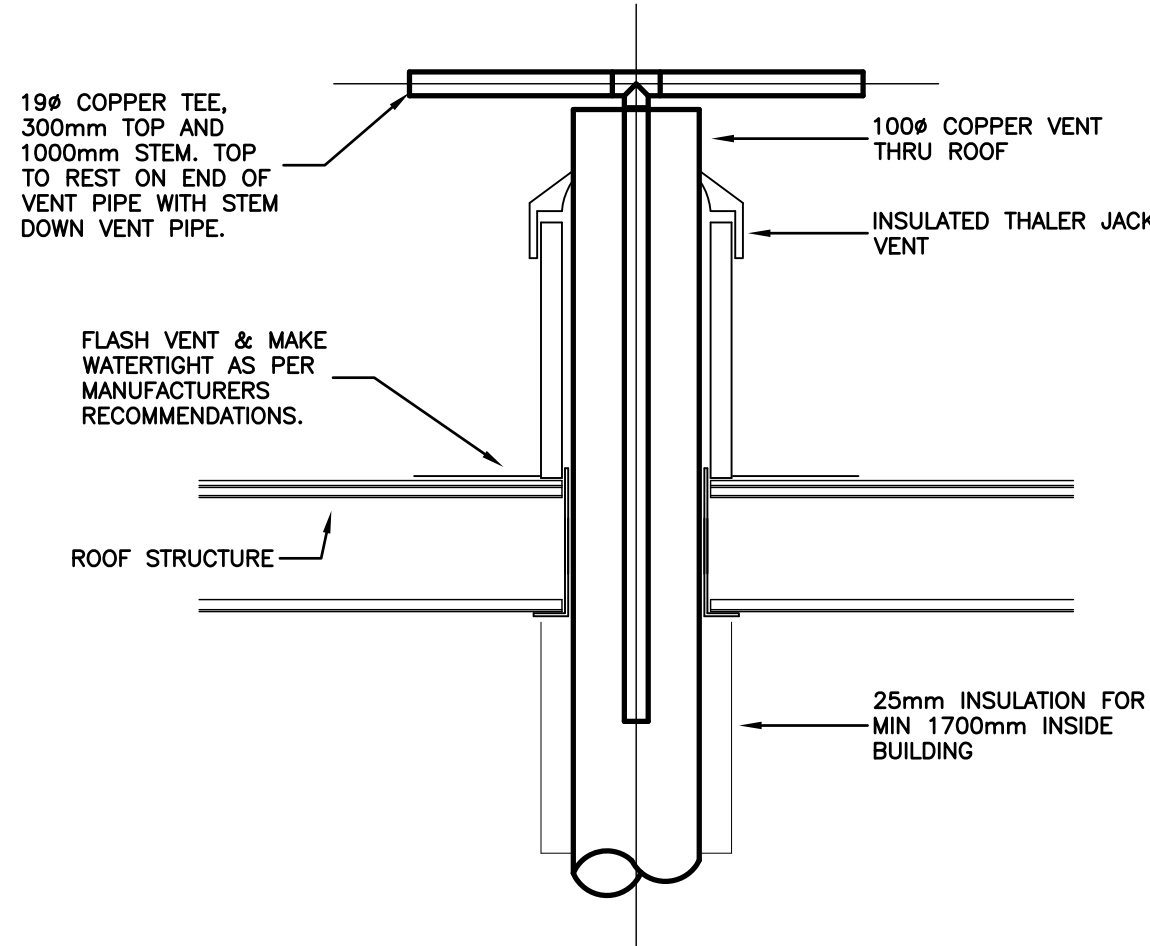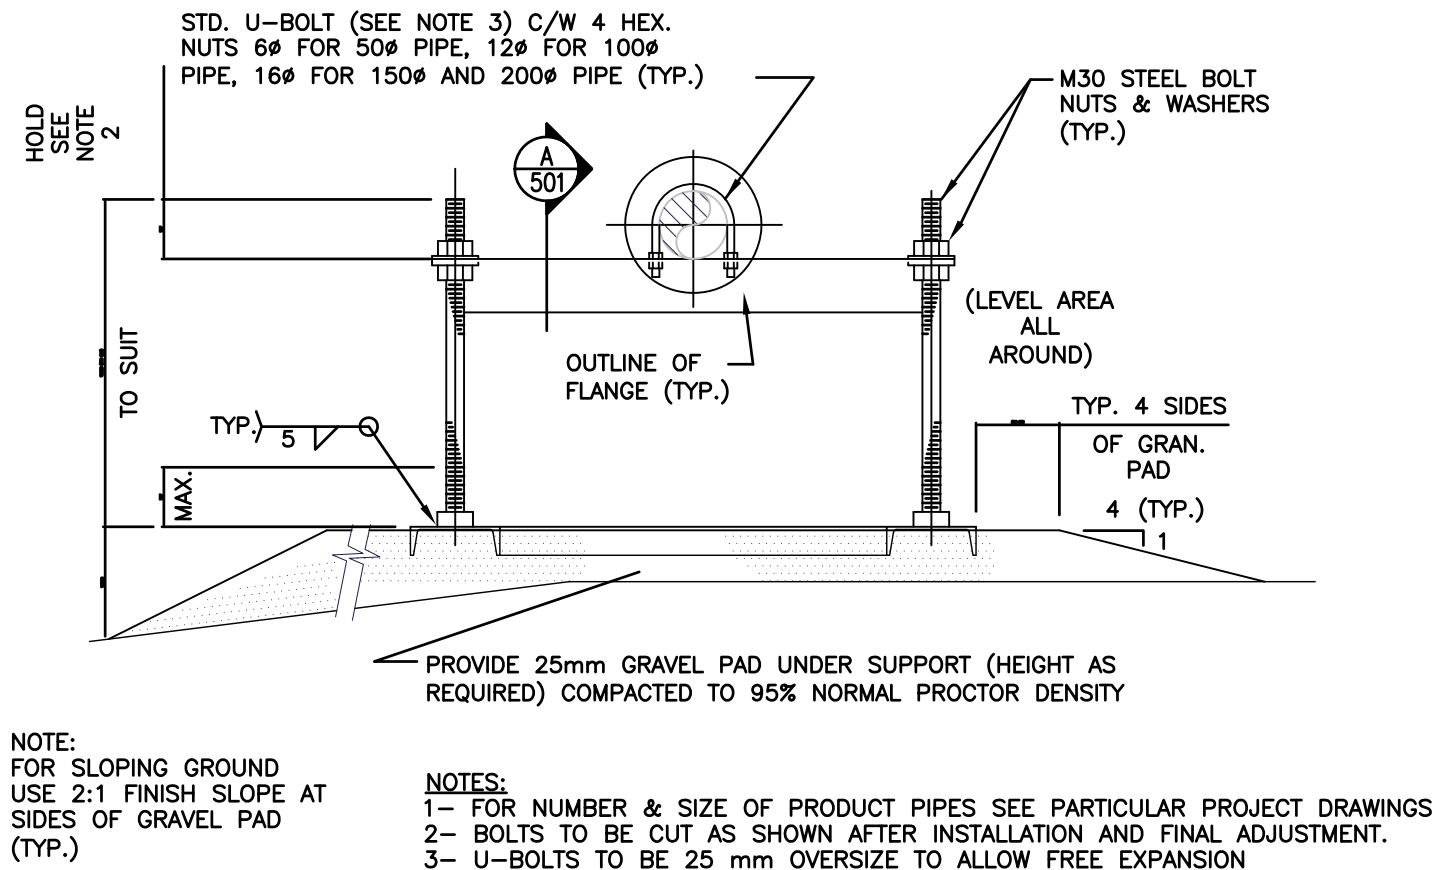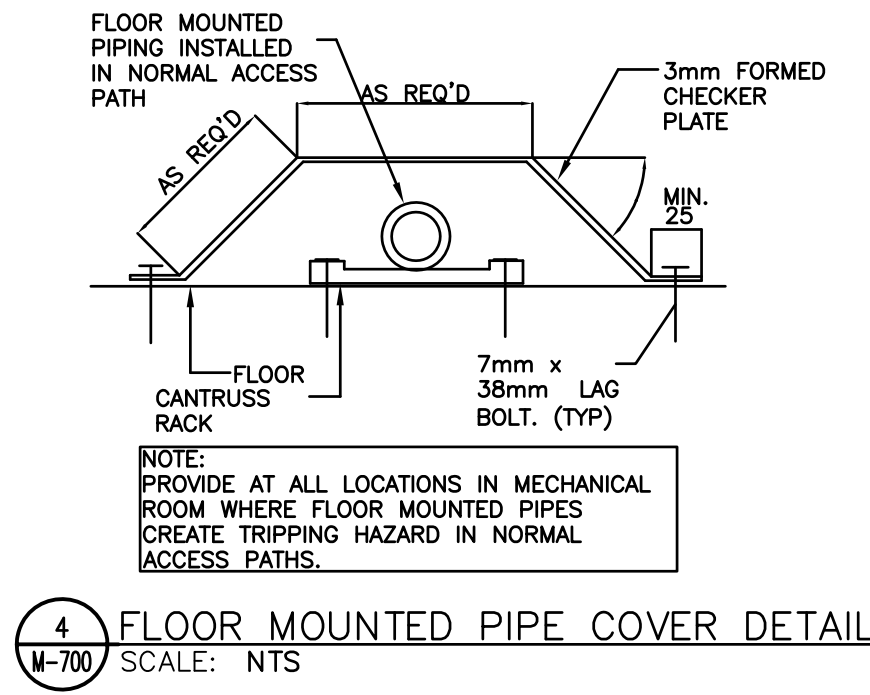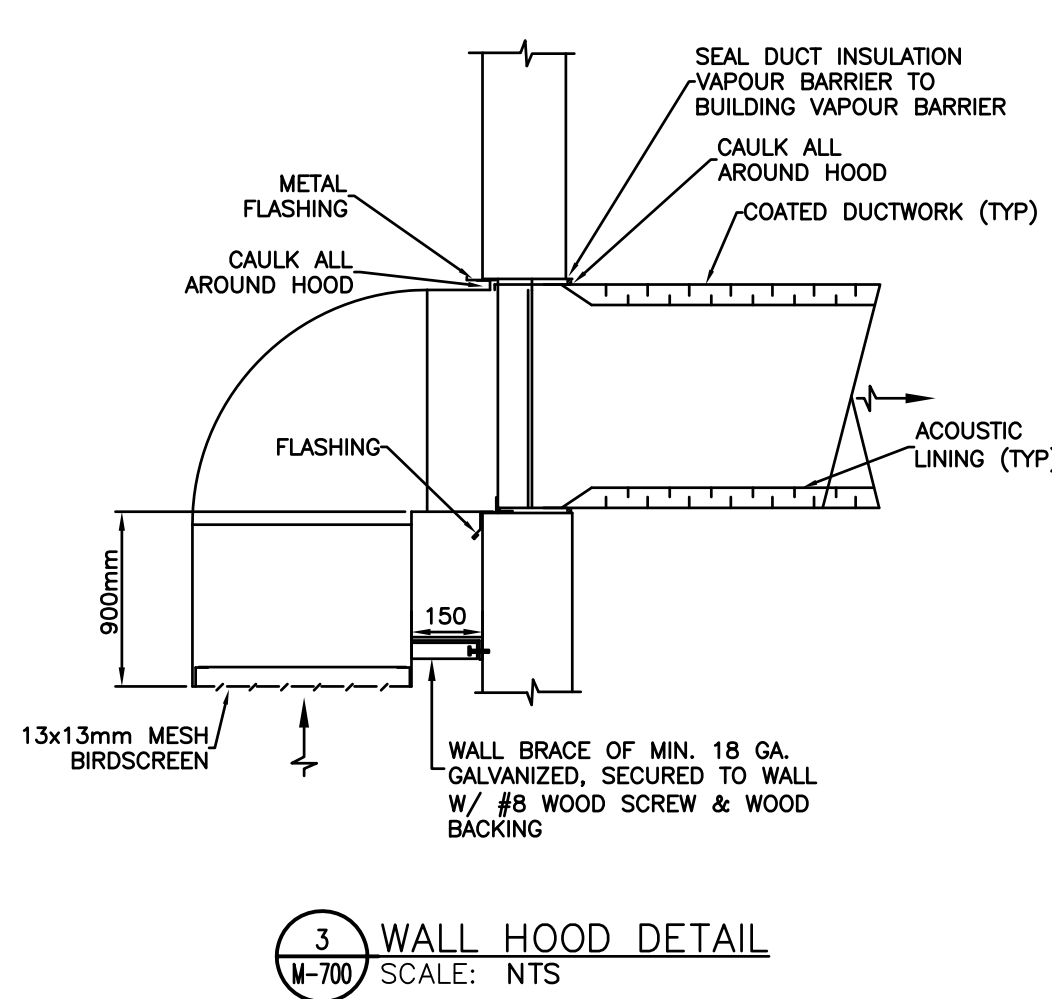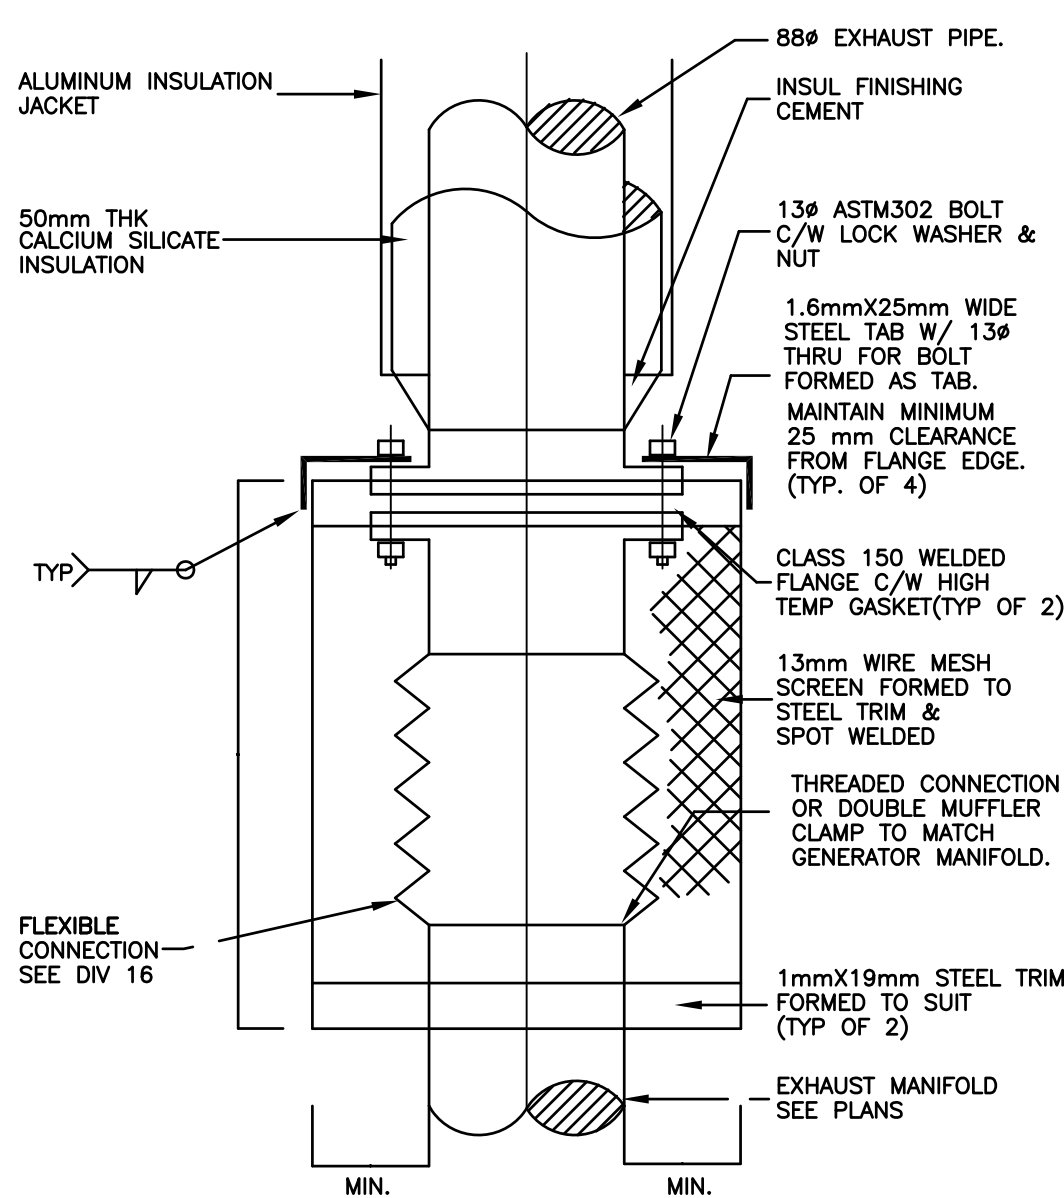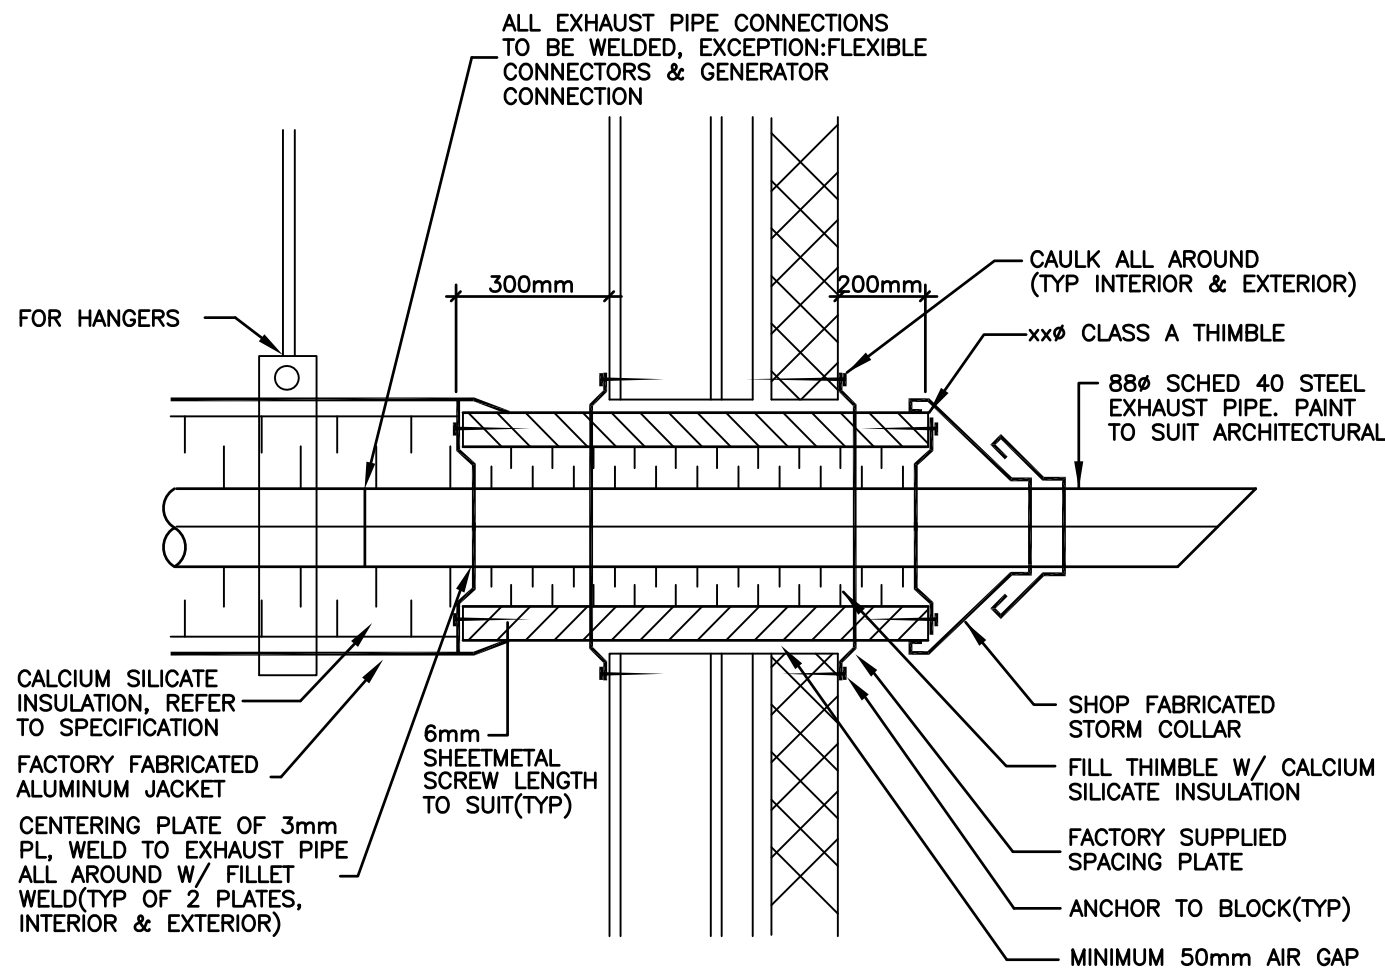


7 NEW PRODUCT TRANSFER AREA SIGNAGE DETAIL AT NEW TANK SCALE: NTS

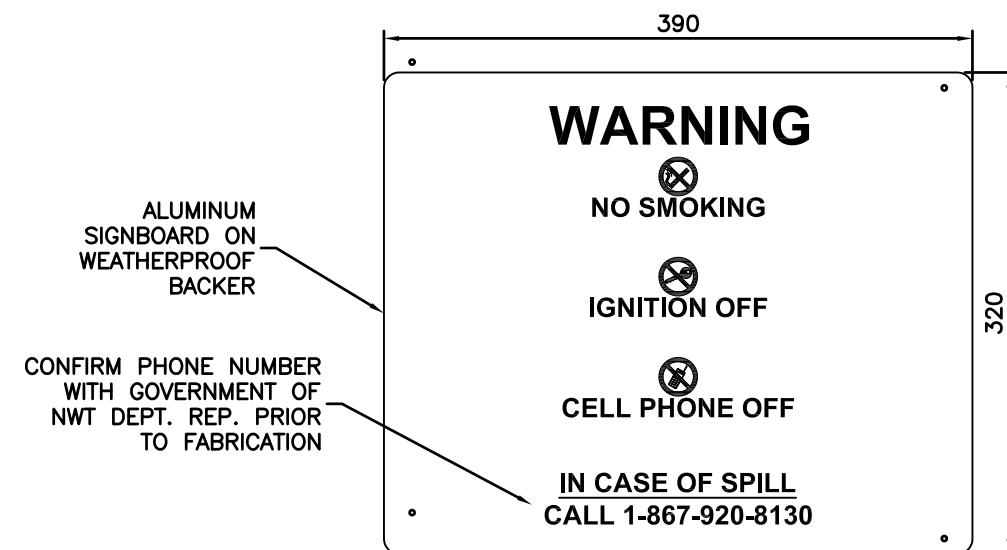

8 GENERATOR RECIRCULATION PLENUM SECTION VIEW SCALE: NTS

9 NEW SAFETY SIGNAGE DETAIL AT NEW TANK SCALE: NTS

10 EXAMPLE OF SIGNAGE FOR BUILDING ISOLATION VALVE SCALE: NTS

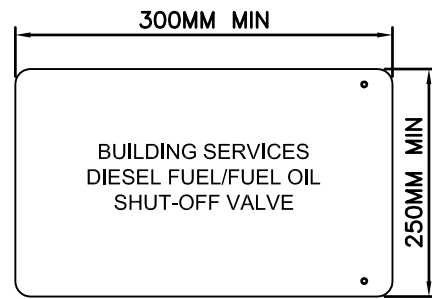

NOTE: COORDINATE WITH DEPT. REP. FOR LANGUAGE REQUIREMENTS FOR ALL SIGNS.

ELECTRIC UNIT HEATER SCHEDULE										
TAG	LOCATION	MANUFACTURER	MODEL	CAPACITY (kW)	AIRFLOW (L/S)	MOTOR (kW)	V/PH/Hz	WEIGHT (kg)	DIMENSIONS (HxWxD) (mm)	REMARKS
01-UH-001	GENERATOR ROOM	OUELLET	OASU3038AM	3.0	241	0.025	208/3/60	20	432x420x305	
01-UH-002	CONTROL ROOM	OUELLET	OASU3038AM	3.0	241	0.025	208/3/60	20	432x420x305	
01-UH-003	CONTROL ROOM	OUELLET	OASU3038AM	3.0	241	0.025	208/3/60	20	432x420x305	

ELECTRIC DOMESTIC HOT WATER HEATER SCHEDULE								
TAG No.	LOCATION	MANUFACTURER	MODEL No.	INPUT (kW)	STORAGE (L)	ELECTRICAL (V/Ph/Hz)	DIMENSIONS (ø x L x H) (mm)	REMARKS
26-TK-202	CONTROL ROOM	ECO SMART	POU 3.5	3.5	0	120/1/60	74 x 277 x 150	ON-DEMAND WATER HEATER
26-TK-203	CONTROL ROOM	GIANT	130SEO	1.5	114	120/1/60	56 X 78	

TANK SCHEDULE								
TAG No.	SERVICE	LOCATION	MANUFACTURER	MODEL No.	TANK VOLUME (L)	TANK ACCEPTANCE VOLUME (L)	DIMENSIONS (ø x L) (W x L x H) (mm)	REMARKS
26-TK-201	PRESSURE TANK	CONTROL ROOM	AY MCDONALD	16020MV4F	75.7	—	391x832	
30-TK-001	WASTE STORAGE TANK	CONTROL ROOM	—	—	4100	4100	4100x1500x2000	
40-TK-001	MAIN FUEL OIL TANK	EXTERIOR	AURORA MANUFACTURING	—	4328	4328	3778x1287x1532	TANK TO BE FROM NORTHERN MANUFACTURER AND EQUIVALENT TO WESTEEL AST FV4500HD C/W MORRISON BROS 516 19L SPILL CONTAINMENT BOX
40-TK-002	GENERATOR DAY TANK	GENERATOR ROOM	—	—	184	184	1875x780x200	GENERATOR SUB-BASE FUEL OIL AUXILIARY TANK BY GENERATOR SUPPLIER
40-TK-003	FURNACE DAY TANK	CONTROL ROOM	WESTEEL	FOSC280	283	283	585 x 610 x 1185	

GRILLE, DIFFUSER, AND LOUVER SCHEDULE							
TAG No.	MANUFACTURER	MODEL No.	SIZE (mm)	SERVICE	DESCRIPTION	FINISH	REMARKS
S-1	EH PRICE	SDG	SEE DRAWINGS	SUPPLY	SPIRAL DUCT GRILLE	B12	

FIRE EXTINGUISHER SCHEDULE						
TAG No.	MANUFACTURER	MODEL No.	DESCRIPTION	UL RATING	BRACKET	REMARKS
FE-1	-	-	TYPE ABC MULTIPURPOSE DRY CHEMICAL	4A-80B:C	STANDARD HANGER WITH QUICK RELEASE MECHANICAL RETENSION STRAP. BRACKET TO MATCH EXTINGUISHER MANUFACTURER.	ANSUL, AMEREX, PYROCHEM, STRIKE FIRST
FE-2	-	-	TYPE BC CARBON DIOXIDE	20B:C	STANDARD HANGER WITH QUICK RELEASE MECHANICAL RETENSION STRAP. BRACKET TO MATCH EXTINGUISHER MANUFACTURER.	ANSUL, AMEREX, STRIKE FIRST

1.1 CONTROL LOGIC – HEATING SYSTEMS

1. OIL-FIRED FURNACE:

- .1 OIL-FIRED FURNACE:
 - .1 SPACE TEMPERATURE SENSOR CYCLES HEATING ELEMENT TO SATISFY SETPOINT.
 - .2 INITIAL SETPOINT = 15 DEG C.
 - .3 DURING OCCUPIED TIMES, FURNACE O/A DAMPER IS TO OPEN TO 10%, RELIEF AIR DAMPER IS TO OPEN TO 10%, AND FURNACE R/A DAMPER TO CLOSE TO 90% TO SATISFY OUTDOOR AIR VENTILATION REQUIREMENTS. OCCUPANCY IS TO BE DETERMINED BY MONITORING THE STATUS OF THE CONTROL ROOM LIGHT SWITCH.
 - .4 FREE COOLING, PURGING MODE IS TO BE ACTIVATED MANUALLY AND CONTROL STATION. IN FREE COOLING, FURNACE IS TO OPERATE IN FAN ONLY MODE. O/A DAMPER IS TO OPEN 100%, RELIEF E/A DAMPER IS TO OPEN 100%, FURNACE R/A DAMPER IS TO FULLY CLOSE.
 - .5 DURING UNOCCUPIED TIMES, O/A AND E/A DAMPERS TO CLOSE FULLY. FURNACE TO OPERATE IN FULL RECIRCULATION MODE.
- .2 ELECTRIC UNIT HEATER:
 - .1 DURING NORMAL OPERATION, UNIT HEATERS ARE TO BE LOCKED OUT WHILE FURNACE IS IN OPERATION. DEACTIVATE UNIT HEATER LOCK OUT WHEN BUILDING TEMPERATURE IS 5°C BELOW SETPOINT FOR MINIMUM 30 MINUTES OR IF BUILDING TEMPERATURE DROPS BELOW 0°C FOR 5 MINUTES AS MEASURED FROM THE THERMOSTATS.. ALARM TO BEACON. REINSTATE LOCK OUT ONCE BUILDING TEMPERATURE RECOVERS TO SETPOINT FOR 30 MINUTES. DURING UNIT HEATER OPERATION:
 - .1 SPACE TEMPERATURE SENSOR CYCLES HEATING ELEMENT TO SATISFY SETPOINT.
 - .2 INITIAL SETPOINT = 10 DEG C.

1. FUEL FROM THE OUTDOOR TANK IS TRANSFERRED TO THE DAY TANK VIA TWO FUEL TRANSFER PUMPS. THE SYSTEM SHALL BE CYCLED BASED ON DAY TANK FUEL DEMAND. UPON SYSTEM DEMAND, THE TANK FUEL LINE SOLENOID VALVES SERVING THE DEMAND AUXILIARY TANKS SHALL BE OPEN. THE LEAD PUMP SHALL OPERATE CONTINUOUSLY WITH AUTO TRANSFER ON FAILURE AND WITH LEAD ROTATING. IF FUEL DEMAND CANNOT BE MET FOR MORE THAN 15MIN, ENABLE THE SECOND PUMP. ONCE THE FUEL LOAD IS SATISFIED, DEACTIVATE THE PUMPS, CLOSE TANK FUEL LINE SOLENOID VALVES.
2. ON HIGH-HIGH FUEL OIL LEVEL AS DETECTED AT EITHER GENERATOR OR FURNACE AUXILIARY TANKS A HARDWIRED OVERRIDE WILL SHUT THE TRANSFER PUMPS OFF. THE PUMPS WILL NOT RESTART UNTIL RESET.
3. ON LOW-LOW OR HIGH-HIGH FUEL OIL LEVEL AS DETECTED AT EITHER GENERATOR OR FURNACE AUXILIARY TANKS A CRITICAL ALARM WILL BE GENERATED. ALARM TO BEACON AND AUDIOTIDALARM. ALARM CONDITIONS SHALL BE MONITORED BY THE CONTROL SYSTEM.
4. ON LOW FUEL LEVEL AS DETECTED AT EITHER GENERATOR OR FURNACE AUXILIARY TANKS, ACTIVATE TRANSFER PUMPS AND OPEN CONTROL VALVE SERVING THE DEMAND TANK.
5. ON HIGH FUEL LEVEL AS DETECTED AT EITHER GENERATOR OR FURNACE AUXILIARY TANKS, DEACTIVATE TRANSFER PUMPS AND CLOSE CONTROL VALVE SERVING THE DEMAND TANK.
6. LEAD PUMP IS TO ROTATE ON WEEKLY SCHEDULE ON WEDNESDAY AT 10AM.

.1 ON-DEMAND DOMESTIC WATER HEATER

- .1 ON-DEMAND DOMESTIC WATER HEATER TO CYCLE ELECTRIC HEATING ELEMENT WHEN SINK HOT WATER FLOW IS MORE THAN 0.016 L/S.
- .2 DOMESTIC HOT WATER HEATER TANK
 - .1 DOMESTIC HOT WATER HEATER PACKAGED TEMPERATURE CONTROLLER TO CYCLE ELECTRIC HEATING ELEMENTS TO SATISFY SETPOINT.
INITIAL SETPOINT = 60 DEG C.
 - .2 DOMESTIC HOT WATER HEATER TANK TO BE CONTROLLED BY TOGGLE DISCONNECT SWITCH. OPERATOR TO POWER WATER HEATER TANK WHEN HOT WATER IS REQUIRED AT HOSE BIBB AND TURN OFF AFTERWARDS.
- 1.4 CONTROL LOGIC – LOW BUILDING TEMPERATURE ALARM
 - .1 IN EVENT OF LOW BUILDING TEMPERATURE AS SENSED BY TEMPERATURE SENSOR AND 15 MINUTE TIME DELAY.
 - .2 INITIAL SETPOINT = 5°C
 - .3 LOW TEMPERATURE SENSORS LOCATED IN CONTROL ROOM.
 - .4 ALARM TO BEACON AND AUTODIALER.
- 1.5 CONTROL LOGIC – GENERATOR COOLING SYSTEM
 - .1 WHEN THE GENERATOR STARTS, THE COMBUSTION AIR DAMPER OPENS FOR COMBUSTION AIR. COOLING AIR O/A AND E/A DAMPER TO REMAIN CLOSED, COOLING R/A DAMPER TO OPEN. ON A RISE IN ROOM TEMPERATURE, THE COOLING R/A WILL BEGIN TO MODULATE CLOSED AND THE COOLING O/A AND E/A DAMPER WILL MODULATE OPEN MAINTAINING AIR TEMPERATURE SET POINT. INITIAL TEMPERATURE SETPOINT: 20°C.

PUMP SCHEDULE											
TAG No.	SERVICE	LOCATION	MANUFACTURER	MODEL No.	CAPACITY (L/s)	HEAD (m)	FLUID	MOTOR (kW)	RPM	ELECTRICAL (V/Ph/Hz)	REMARKS
26-P-201	POTABLE WATER	CONTROL ROOM	GRUNDFOS	CR (E) 1-5	046	36.0	WATER	0.37	—	120/1/60	
30-P-001	SUMP	CONTROL ROOM SUMP TRENCH	BARNES	SEV511	5	3.21	WATER	0.37	1750	120/1/60	
40-P-001	FUEL OIL	CONTROL ROOM	OBERDORFER	N61K10G01	0.13	—	DIESEL	0.25	1725	120/1/60	
40-P-002	FUEL OIL	CONTROL ROOM	OBERDORFER	N61K10G01	0.13	—	DIESEL	0.25	1725	120/1/60	

PLUMBING FIXTURES SCHEDULE								
TAG No.	MANUFACTURER	MODEL No.	DESCRIPTION	DCW (ømm)	DHW (ømm)	SAN (ømm)	VENT(ø mm)	REMARKS
SK-1	—	—	LAB SINK	20	20	40	32	18 GA. TYPE 304 SS FABRICATION, BRUSHED FINISH, CORNER DRAIN WITH OVERFLOW PIPE AND STRAINER, C/W GOOSENECK TWO—HANDLE FAUCET.
HB-1	CHICAGO	835—CP	HOT AND COLD HOSE BIBB	13	13	—	—	WALL MOUNTED 6" FIXED CENTER EXPOSED HOT AND COLD WATER FAUCET WITH SUPPLIES FROM ABOVE C/W ATMOSPHERIC VACUUM BREAKER AND 3/4" HOSE THREAD OUTLET.

FURNACE											
TAG No.	LOCATION	MANUFACTURER	MODEL No.	HEAT WHEEL	DUTY	AIR FLOW (L/S)	HEAT OUTPUT (kW)	E.S.P. (Po)	ELECTRICAL (V/Ph/Hz)	MOTOR (kW)	REMARKS
01—FC—001	CONTROL ROOM	OLSEN	HML 80C	N/A	SUPPLY/RETURN	600	21.98	130	120/1/60	0.37	USED WITH BECKETT AF76BUHS BURNER

MOTORIZED DAMPER SCHEDULE					
TAG No.	DUTY	TYPE	SIZE	SYSTEM	REMARKS
00--YY--001	COMBUSTION AIR	2P	75X500	GENERATOR ROOM COMBURATION AIR	
00--YY--002	RECIRC AIR	MODULATING OBD	900X500	GENERATOR ROOM COOLING	
00--YY--003	EXHAUST AIR	MODULATING OBD	900X500	GENERATOR ROOM COOLING	
00--YY--004	COOLING AIR	MODULATING OBD	825X500	GENERATOR ROOM COOLING	
00--YY--005	OUTSIDE AIR	MODULATING OBD	450X400	CONTROL ROOM VENTILATION	
00--YY--006	RECIRC AIR	MODULATING OBD	550X350	CONTROL ROOM VENTILATON	
00--YY--007	EXHAUST AIR	MODULATING OBD	550X600	CONTROL ROOM VENTILATION	



The Contractor shall verify and be responsible for all dimensions. DO NOT scale the drawing - any errors or omissions shall be reported to Stantec without delay. The Copyrights to all designs and drawings are the property of Stantec. Reproduction or use for any purpose other than that authorized by Stantec is forbidden.

Legend

Notes

File Name:				
	Dwn.	Chkd.	Dsgn.	YY.MM.DD

PERMIT TO PRACTICE STANTEC ARCHITECTURE LTD. Signature: <u><i>[Signature]</i></u> Date: <u>11 Sept 2018</u> PERMIT NUMBER: P 800 NT/NU Association of Professional Engineers and Geoscientists <u>164902412</u>	 Sept 11, 2018 B. R. MORRIS 144902412 GNWT 3-WTP
---	---

GOVERNMENT OF THE
NORTHWEST TERRITORIES
BUNDLED WATER TREATMENT PLANT

Title
SCHEDULES

Drawing No.	Sheet	Revision
-------------	-------	----------

C/



The Contractor shall verify and be responsible for all dimensions. DO NOT scale the drawing - any errors or omissions shall be reported to Stantec without delay.

The Copyrights to all designs and drawings are the property of Stantec. Reproduction or use for any purpose other than that authorized by Stantec is forbidden.

Legend

Notes

[illegible]

PERMIT TO PRACTICE
STANTEC ARCHITECTURE LTD.
 Signature: [Signature]
 Date: 11 Sept 2013
PERMIT NUMBER: P 800
 NT/NU Association of Professional
 Engineers and Geoscientists
144902412


GOVERNMENT OF THE
NORTHWEST TERRITORIES

Title
ELECTRICAL SITE PLAN

Scale
AS SHOWN

Revision

C

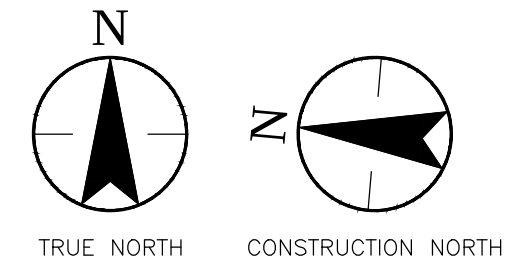

2 SERVICE ENTRY DETAIL
E100 N.T.S.

1. OVERHEAD CONDUCTORS TO BE INSTALLED ACCORDING TO C.E.C. THE POINT OF ATTACHMENT OF CONDUCTORS SHALL NOT EXCEED 9000mm ABOVE GRADE. MINIMUM CLEARANCE TO CONDUCTORS INCLUDING CONDUCTOR DROOP SHALL NOT BE LESS THAN THE FOLLOWING AS PER CEC 6-112:
 - a. 5000mm ACROSS DRIVEWAYS
 - b. 3500mm ACROSS GROUND NORMALLY ACCESSIBLE TO PEDESTRIANS ONLY.
2. COORDINATE METER HEIGHT TO UTILITY REQUIREMENTS.

POWER PLAN SYMBOLS	
	DUPLEX 5-15R RECEPTACLE
	DUPLEX 5-15R RECEPTACLE C/W INTEGRAL GFCI PROTECTION
	DUPLEX 5-20R RECEPTACLE, T-SLOT WITH SURGE PROTECTION DEVICE
	DUPLEX 5-15R RECEPTACLE, WEATHERPROOF C/W INTEGRAL GFCI PROTECTION
	DUPLEX 5-15R RECEPTACLE, WEATHERPROOF
	ELECTRICAL UNIT HEATER
	WALL MOUNTED JUNCTION BOX
	POWER PANELBOARD
	PANEL (TYPE AS INDICATED - SECURITY, LIGHTING RELAY, ETC.)
	GROUND BUS BAR
	MOTOR
	MANUAL MOTOR STARTER C/W PILOT LIGHT
	DEVICE MOUNTED ABOVE MILLWORK COUNTERTOP
TELECOMMUNICATIONS SYMBOLS	
	WALL MOUNTED TELECOM OUTLET (# DENOTES NUMBER OF CABLES)
LIGHTING PLAN SYMBOLS	
	STRIP LUMINAIRE, 4'
	STEP OR WALL MOUNTED LUMINAIRE WITH INTEGRAL PHOTOCELL
	EMERG. LTG. BATTERY PACK (# OF LAMPS AS SHOWN)
	WALL MOUNTED EMERG. LTG. REMOTE HEAD (# OF LAMPS AS SHOWN)
	WALL MOUNTED EXIT SIGN (FRONT MOUNTED)
	LINE VOLTAGE SWITCH (120V TO 347V)
SCHEMATIC SYMBOLS	
	WEATHERHEAD
	CIRCUIT BREAKER
	DISCONNECT SWITCH
	TRANSFER SWITCH
	GENERATOR
	REVENUE METER
	PANEL
	MAIN GROUND BUS
	SPLITTER BOX

— EXISTING UTILITY SERVICE POLE

1 ELECTRICAL SITE PLAN
E100 1:100

Copyright Reserved

The Contractor shall verify and be responsible for all dimensions, DO NOT scale the drawing - any errors or omissions shall be reported to Stantec without delay.
The Copyrights to all designs and drawings are the property of Stantec. Reproduction or use for any purpose other than that authorized by Stantec is forbidden.

Consultants

Legend


Notes

Revision

Issue d

File Name:	144902412_ELEC.DWG	GF	JY	GF/JY	18.04.13
		Dwn.	Chkd.	Dsgn.	YY.MM.DD

Permit-Seal

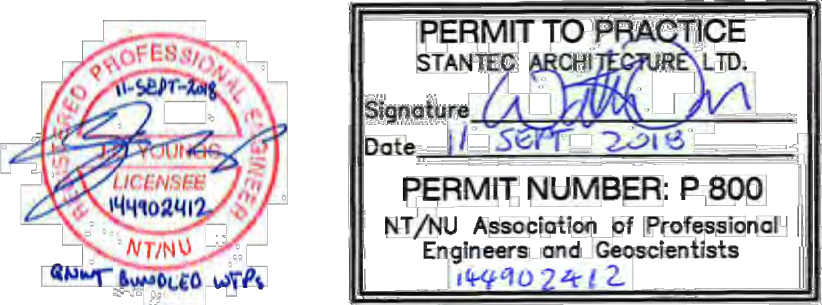

Client/Project

GOVERNMENT OF THE
NORTHWEST TERRITORIES

BUNDLED WATER TREATMENT PLANTS

Wekweeti, NT

Title

LIGHTING AND EMERGENCY
LIGHTING PLAN

Project No. 144902412 Scale AS SHOWN

Drawing No. Sheet Revision

E101

2 of 5

C

C

B

A

1

2

3

4

LUMINAIRE SCHEDULE

401	1219mm LONG, 6000 LUMEN, 57.3 WATT, 5000K, SURFACE MOUNTED VAPORTITE LED. TO BE METALUX INDUSTRIAL VAPORTITE LED OR APPROVED EQUIVALENT.
402	3137 LUMEN, 47W, 4000K FULL CUTOFF EXTERIOR LED WALL MOUNT FIXTURE. SUITABLE FOR USE AT -40°C AND WET LOCATION RATED WITH INTEGRAL PHOTOCELL. TO BE LUMARK WP SERIES OR APPROVED EQUIVALENT.
403	LED AMBER VISUAL SIGNAL LIGHT, 25.2W, NEMA 4X RATED AND SUITABLE FOR USE AT -40°C. TO BE FEDERAL SIGNAL MODEL 225XL OR APPROVED EQUIVALENT.

EMERGENCY LIGHT BATTERY PACK SCHEDULE

ID	DESCRIPTION	VOLTAGE	MINIMUM WATTAGE	MINIMUM RUN TIME
BP#1	WATER TREATMENT PLANT	24V	144W	2 HR


1

LIGHTING AND EMERGENCY LIGHTING PLAN

E101 1:25

KEYNOTE (APPLICABLE TO ALL PLANS):

- ALL EQUIPMENT INSTALLED IN CONTROLS ROOM AND TANK ROOM MUST BE DAMP LOCATION LISTED. PROVIDE WEATHERPROOF COVERS FOR WIRING DEVICES IN THESE AREAS. ALL CONDUCTORS IN THIS AREA TO BE TECK CABLE WITH WATERTIGHT CONNECTORS.
- ALL EQUIPMENT AND PANEL CONNECTIONS SHALL BE SIDE OR BOTTOM ENTRY. TOP ENTRY NOT PERMITTED.

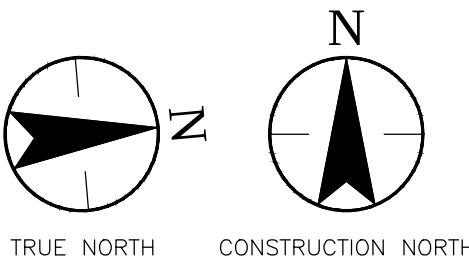

DP-01-25

DP-01-25

BP#1

BP#1

WP

WP

TANK ROOM

102

GENERATOR ROOM

103

CONTROLS ROOM

101



The Contractor shall verify and be responsible for all dimensions. DO NOT scale the drawing - any errors or omissions shall be reported to Stantec without delay. The Copyrights to all designs and drawings are the property of Stantec. Reproduction or use for any purpose other than that authorized by Stantec is forbidden.

Legend

File Name: 144902412_ELEC.DWG	GF	JY	GF/JY	18.04.13
	Dwn.	Chkd.	Dsgn.	YY.MM.DD

11-SEPT-2018
 PROFESSIONAL ENGINEER
 STATE OF NEW YORK
 LICENSE
 44492412
 NTNU
 (PRINT SAMPLED UPON)

PERMIT TO PRACTICE
 STANTEC ARCHITECTURE LTD.
 Signature: *[Signature]*
 Date: 11 SEPT 2018
PERMIT NUMBER: P. 800
 NT/NU Association of Professional Engineers and Geoscientists
 114492412


GOVERNMENT OF THE
NORTHWEST TERRITORIES

BUNDLED WATER TREATMENT PLANTS

Title
POWER AND LOW TENSION PLAN

Drawing No.	Sheet	Revision
-------------	-------	----------

E102 3 of 5 C

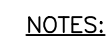

- 1 POWER AND LOW TENSION PLAN
E102 1:25

1. ALL EQUIPMENT INSTALLED IN CONTROLS ROOM AND TANK ROOM MUST BE DAMP LOCATION LISTED. PROVIDE WEATHERPROOF COVERS FOR WIRING DEVICES IN THESE AREAS. ALL CONDUCTORS IN THIS AREA TO BE TECK CABLE WITH WATERTIGHT CONNECTORS.
2. ALL EQUIPMENT AND PANEL CONNECTIONS SHALL BE SIDE OR BOTTOM ENTRY. TOP ENTRY NOT PERMITTED.



The Contractor shall verify and be responsible for all dimensions. DO NOT scale the drawing - any errors or omissions shall be reported to Stantec without delay.

The Copyrights to all designs and drawings are the property of Stantec. Reproduction or use for any purpose other than that authorized by Stantec is forbidden.

Legend

File Name: 144902412_ELEC.DWG	GF	JY	GF/JY	18.04.13
	Dwn.	Chkd.	Dsgn.	YY.MM.DD

The image shows two documents side-by-side. On the left is a circular professional engineer seal for the NTNU Association of Professional Engineers and Geoscientists. The seal contains the following information:
 - Outer ring: PROFESSIONAL ENGINEERS AND GEOSCIENTISTS
 - Inner ring: ASSOCIATION OF PROFESSIONAL ENGINEERS AND GEOSCIENTISTS
 - Center: NTNU
 - License Number: 44902412
 - Expiration Date: 11-SEP-2018
 A blue ink signature is written across the seal.
 Below the seal, the handwritten text "QUEST SAMPLED WITH" is visible.

On the right is a "PERMIT TO PRACTICE" form for STANTEC ARCHITECTURE LTD. The form includes:
 - Title: PERMIT TO PRACTICE
 - Firm Name: STANTEC ARCHITECTURE LTD.
 - Signature: [Handwritten Signature]
 - Date: 11 SEP 2018
 - Permit Number: P 800
 - Issued By: NT/NU Association of Professional Engineers and Geoscientists
 - Reference Number: 44902412


GOVERNMENT OF THE
NORTHWEST TERRITORIES

BUNDLED WATER TREATMENT PLANTS

Title
ELECTRICAL DETAILS

Drawing No.	Sheet	Revision
-------------	-------	----------


C

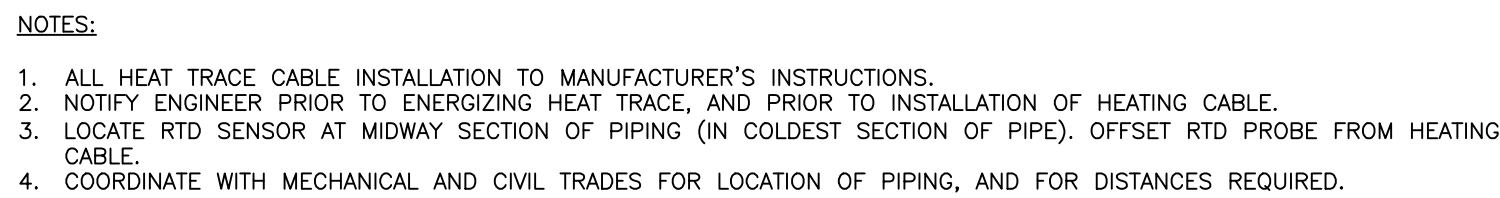

A cross-sectional diagram of a pipe assembly. The outermost layer is labeled "OUTER CASING". Inside this is a layer labeled "INSULATION". The central part is a "PIPE". A "TEMPERATURE SENSOR (SET TO 'ON' BELOW 3°C) ATTACHED TO THE PIPE WITH ALUMINUM TAPE." is shown on the right side of the pipe. At the bottom, a "HEAT TRACE CABLE" is shown inside a "HEAT TRACE CONDUIT".

NOTES:


1. CONTRACTOR TO CONFIRM ALL DIMENSIONS AND LOCATIONS ON SITE AND REPORT ANY DISCREPANCIES.
2. REFER TO CIVIL DRAWINGS FOR PIPE DETAILS.

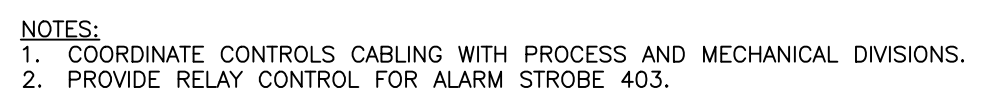

4 TELECOM ENCLOSURE INTERIOR ELEVATION
E500 1:10

PANELS MOUNTED ON FLOOR
MOUNTED STAND-OFFS

\\s-0125-cad\01\cadd\group\14491\Area\144902412\05_drawing\electrical\144902412_ELEC.dwg
2018/09/11 15:50 PM By: PAVAN, Geometric

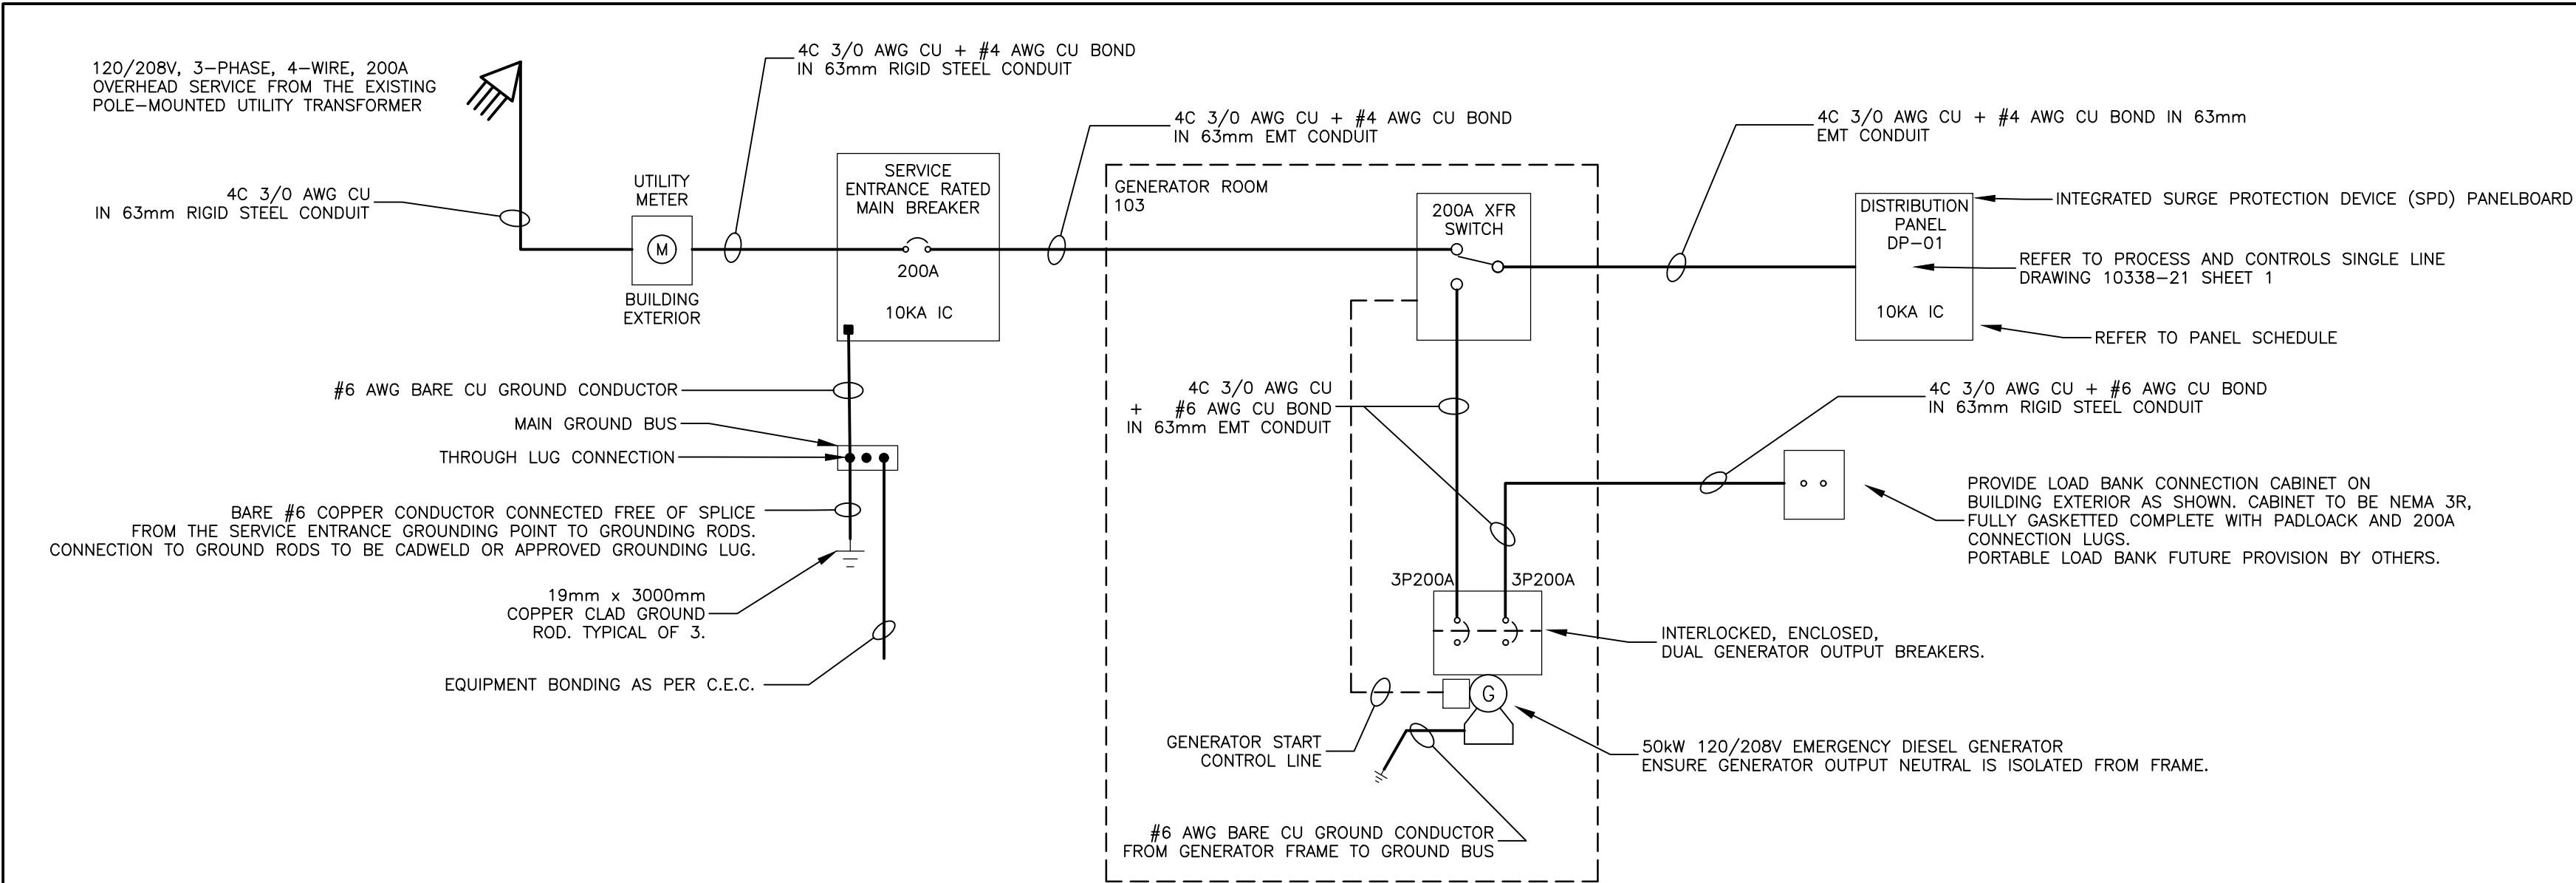

1 ELECTRICAL SINGLE LINE DIAGRAM
E700 N.T.S.

MOTOR, CONTROL AND EQUIPMENT SCHEDULE											
MOTOR	DESCRIPTION	LOCATION	KW	HP	VOLTS	PHASE	FLA	FEEDER	BREAKER	SOURCE	CONTROL
26-P-201	DOMESTIC WATER PRESSURE PUMP	TANK ROOM	—	0.5	115	1	9.8	2C #12 CU + #14 CU BOND TECK ON CABLE TRAY	1P20	DP-01	MMP/R
30-P-001	SUMP PUMP MOTOR	TANK ROOM	—	0.5	115	1	12.00	REFER TO DWG 10338-GNWT-CABLE SCHEDULE	NOTE 5	CP-01	REFER TO DWG 10338-21-100
40-P-001	DIESEL TRANSFER PUMP MOTOR 1	CONTROLS ROOM	—	0.333	115	1	7.2	2C #12 CU + #14 CU BOND TECK ON CABLE TRAY	1P15	DP-01	LRD/R
40-P-002	DIESEL TRANSFER PUMP MOTOR 2	CONTROLS ROOM	—	0.333	115	1	7.2	2C #12 CU + #14 CU BOND TECK ON CABLE TRAY	1P15	DP-01	LRD/R
01-FC-001	FURNACE	CONTROLS ROOM	—	0.5	115	1	9.80	2C #12 CU + #14 CU BOND TECK ON CABLE TRAY	1P20	DP-01	LRD/R
26-TK-202	ON-DEMAND WATER HEATER	TANK ROOM	3.5	—	115	1	—	2C #10 CU + #12 CU BOND TECK ON CABLE TRAY	1P40	DP-01	LRD
26-TK-203	ON-DEMAND HOT WATER TANK	TANK ROOM	1.5	—	115	1	—	2C #12 CU + #14 CU BOND TECK ON CABLE TRAY	1P20	DP-01	LRD
01-UH-001	ELECTRIC UNIT HEATER 1	GENERATOR ROOM	3.00	—	208	3	—	3C #12 CU + #14 CU BOND IN 21MM CONDUIT	3P15	DP-01	LRD/R
01-UH-002	ELECTRIC UNIT HEATER 2	CONTROLS ROOM	3.00	—	208	3	—	3C #12 CU + #14 CU BOND TECK ON CABLE TRAY	3P15	DP-01	LRD/R
01-UH-003	ELECTRIC UNIT HEATER 3	TANK ROOM	3.00	—	208	3	—	3C #12 CU + #14 CU BOND TECK ON CABLE TRAY	3P15	DP-01	LRD/R
TX-1	GENERATOR DAMPER ACTUATORS	GENERATOR ROOM	0.021	—	120	1	—	2C #12 CU + #14 CU BOND IN 21MM CONDUIT	1P15	DP-01	GEN SET CONTROLLER
TX-2	FURNACE DAMPER ACTUATORS	CONTROLS ROOM	0.013	—	120	1	—	2C #12 CU + #14 CU BOND TECK ON CABLE TRAY	1P15	DP-01	ELECTRIC THERMOSTAT
P-001	RAW WATER PUMP MOTOR	J-BOX IN CONTROLS ROOM	—	7.5	208	3	24.3	REFER TO DWG 10338-GNWT-CABLE SCHEDULE	NOTE 5	CP-01	REFER TO DWG 10338-21-100
P-310	PERMEATE PUMP MOTOR	CONTROLS ROOM	—	2	208	3	7.5	REFER TO DWG 10338-GNWT-CABLE SCHEDULE	NOTE 5	CP-01	REFER TO DWG 10338-21-100
P-370	TRUCK FILL PUMP MOTOR	TANK ROOM	—	5	208	3	15.4	REFER TO DWG 10338-GNWT-CABLE SCHEDULE	NOTE 5	CP-01	REFER TO DWG 10338-21-100
AB-410	AIR BLOWER A	CONTROLS ROOM	—	3.4	208	3	10.3	REFER TO DWG 10338-GNWT-CABLE SCHEDULE	NOTE 5	CP-01	REFER TO DWG 10338-21-100
AB-411	AIR BLOWER B	CONTROLS ROOM	—	3.4	208	3	10.3	REFER TO DWG 10338-GNWT-CABLE SCHEDULE	NOTE 5	CP-01	REFER TO DWG 10338-21-100
AC-400	AIR COMPRESSOR A	CONTROLS ROOM	—	2	120	1	12.5	REFER TO DWG 10338-GNWT-CABLE SCHEDULE	NOTE 5	CP-01	REFER TO DWG 10338-21-100
AC-401	AIR COMPRESSOR B	CONTROLS ROOM	—	2	120	1	12.5	REFER TO DWG 10338-GNWT-CABLE SCHEDULE	NOTE 5	CP-01	REFER TO DWG 10338-21-100
DR-001	REFRIGERATED AIR DRYER	CONTROLS ROOM	—	0.32	120	1	2.7	REFER TO DWG 10338-GNWT-CABLE SCHEDULE	NOTE 5	CP-01	REFER TO DWG 10338-21-100
P-360	ANALYZER RECIRCULATION PUMP	TANK ROOM	—	0.25	120	1	7	REFER TO DWG 10338-GNWT-CABLE SCHEDULE	NOTE 5	CP-01	REFER TO DWG 10338-21-100
MP-501	FIRE FLOW DISINFECTION PUMP	TANK ROOM	0.05	—	120	1	—	REFER TO DWG 10338-GNWT-CABLE SCHEDULE	NOTE 5	CP-01	REFER TO DWG 10338-21-100
MP-500	CT DISINFECTION PUMP	TANK ROOM	0.05	—	120	1	—	REFER TO DWG 10338-GNWT-CABLE SCHEDULE	NOTE 5	CP-01	REFER TO LIST OF EQUIPMENT COMPONENTS
MP-402	TOP UP DISINFECTION PUMP	TANK ROOM	0.05	—	120	1	—	REFER TO DWG 10338-GNWT-CABLE SCHEDULE	NOTE 5	CP-01	REFER TO LIST OF EQUIPMENT COMPONENTS
MP-200	COAGULANT PUMP	TANK ROOM	0.05	—	120	1	—	REFER TO DWG 10338-GNWT-CABLE SCHEDULE	NOTE 5	CP-01	REFER TO LIST OF EQUIPMENT COMPONENTS
EHT-1	RAW WATER HEAT TRACE	SOUTH EXTERIOR SIDE OF BUILDING	2.325	—	240	1	—	2C #12 CU + #14 CU BOND TECK ON CABLE TRAY	2P15	DP-01	HEAT TRACE CONTROLLER
EHT-2	TRUCK FILL ARM HEAT TRACE	EAST EXTERIOR SIDE OF BUILDING	0.057	—	240	1	—	2C #12 CU + #14 CU BOND TECK ON CABLE TRAY	2P15	DP-01	HEAT TRACE CONTROLLER
EHT-3	BACKWASH LINE HEAT TRACE	EAST EXTERIOR SIDE OF BUILDING	0.336	—	240	1	—	2C #12 CU + #14 CU BOND TECK ON CABLE TRAY	2P15	DP-01	HEAT TRACE CONTROLLER

NOTES:

1. MOTOR SCHEDULE IS FOR ESTIMATING PURPOSES ONLY. CONFIRM ALL MOTOR FULL LOAD CURRENTS WITH NAMEPLATES AND SIZE MOTOR DISCONNECTS, BREAKERS, FEEDERS AND OVERLOADS ACCORDINGLY.
2. CONFIRM MECHANICAL EQUIPMENT LOCATIONS WITH MECHANICAL DIVISION.
3. DIVISION 26 CONTRACTOR SHALL COORDINATE THE LOCATIONS OF ALL LINE VOLTAGE PILOT DEVICES WITH DIVISION 23 AND PROVIDE CONDUIT AND WIRING AS NECESSARY.
4. IN ADDITION TO CONTROL SHOWN, PROVIDE LOCAL DISCONNECT IF REQUIRED BY CEC.
5. REFER TO DRAWING #10338-21 - POWER DISTRIBUTION (SHEET #2-3)

CONTROL DEVICE LEGEND:

- LRD - LOAD RATED DISCONNECT
MAG - MAGNETIC STARTER
CMS - COMBINATION MAGNETIC STARTER WITH DISCONNECT
MMP - MANUAL MOTOR PROTECTION
/R - WITH LOAD RATED RELAY
/HOA - WITH H-O-A SWITCH
/K - KEYED
/SS - SOFT START
VFD - VARIABLE FREQUENCY DRIVE

PANEL: DP-01												
VOLTS: 120/208		LOCATION: CONTROLS ROOM				BUSS: 225A						
PHASE: 3		FEEDER: REFER TO SINGLE LINE DIAGRAM				MTG: SURFACE						
WIRE: 4												
CIRC	BRKR	WATTS			DESCRIPTION	DESCRIPTION	WATTS			BRKR	CIRC	
		A	B	C			A	B	C			
1		6553			PLC CONTROL PANEL CP-01						2	
3	3P160		6553									4
5				6553								6
7		X										8
9			X									10
11	3P40			X	GE SUEZ CONTROL PANEL CP-02	DIESEL TRANSFER PUMP 1	333				1P15	
						DIESEL TRANSFER PUMP 2		333			1P15	
						FURNACE				1196	1P20	
13	1P15	250			ABOVE COUNTER RECEPTACLES	COMPUTER AND PRINTER	350				1P15	
15	1P20		500		DOMESTIC WATER PRESSURE PUMP	GEN DAMPER ACTUATORS		21			1P15	
17	1P15			13	FURNACE DAMPER ACTUATORS	RAW WATER INTAKE HEAT TRACE*			1165		1P15	
19		29			TRUCK FILL ARM HEAT TRACE*		1165				2P15	
21			29			BACKWASH LINE HEAT TRACE*		168			2P15	
23	1P15			360	INTERIOR / E-LIGHT					168	2P15	
25	1P15	225			EXTERIOR LIGHT / ALARM STROBE	EXTERIOR RECEPTACLES*	500				1P15	
27	1P15		72		GEN SET RELAY BATTERY CHARGER	INTERIOR RECEPTACLES		375			1P15	
29	1P15			1000	GEN SET BLOCK HEATER	TELECOM RECEPTACLE 1			500		1P20	
31		1000				TELECOM RECEPTACLE 2	500				1P20	
33	3P15		1000		ELECTRIC UNIT HEATER 1			1000			3P15	
35				1000		ELECTRIC UNIT HEATER 3			1000		3P15	
37		1000					1000				3P15	
39	3P15		1000		ELECTRIC UNIT HEATER 2						3P15	
41				1000		SPD					3P30	
43	1P20	1500			ON-DEMAND HOT WATER TANK							
45	1P40		3500		ON-DEMAND WATER HEATER	SPARE					1P15	
47	1P15			500	EXTERIOR LOAD BANK FAN RECEPTACLE	SPARE					1P15	
49					SPACE	SPARE					1P15	
51					SPACE	SPACE					52	
53					SPACE	SPACE					54	
TOTAL		10557	12654	10426			3848	1897	4029		TOTAL	
PHASE A TOTAL = 14405												
PHASE B TOTAL = 14551												
PHASE C TOTAL = 14455												
PANEL TOTAL = 43411		Ø120/208 VOLTS 3 PHASE				120.5		AMPS				
REMARKS												
*PROVIDE GFI BREAKER												

DEMAND CALCULATION AS PER C22.1-15						
SERVICE FEEDER CALCULATION - 144902412						
	AREA (m²)	WATTS / m²	PERCENT		LOAD	
INDUSTRIAL	80	25	100	=	2000	W
SUBTOTAL	80			=	2000	W
SPECIAL LOADS	WATTS		PERCENT			
ELECTRIC HEATERS	9060		100	=	9060	W
HOT WATER ELECTRIC HEATERS	5000		100	=	5000	W
MECHANICAL & PROCESS LOADS	23000		100	=	23000	W
TOTAL SPECIAL LOADS				=	37060	W
TOTAL BUILDING SERVICE SIZE				=	39060	W
AT 120/208V, 3ø, 60Hz				=	108	A
USE 80% MAIN BREAKER				=	136	A
25% SPARE CAPACITY				=	169	
MAIN DISCONNECT SIZE					200	A
SERVICE CAPACITY					72	kVA



Stantec Architecture Ltd.
4910 53rd Street
Yellowknife, NT, Canada X1A 2P4
Tel. (867)-920-2882
www.stantec.com

Copyright Reserved

The Contractor shall verify and be responsible for all dimensions. DO NOT scale the drawing - any errors or omissions shall be reported to Stantec without delay.
The Copyrights to all designs and drawings are the property of Stantec. Reproduction or use for any purpose other than that authorized by Stantec is forbidden.

Consultants

Legend

Notes

Revision	By	Appd.	YY.MM.DD
C ISSUED FOR CONSTRUCTION	GF	JY	18.09.11
B ISSUED FOR 100% REVIEW	GF/EH	JY	18/07/13
A ISSUED FOR 70% REVIEW	GF/JY	JY	18.04.13
Issue d	By	Appd.	YY.MM.DD

File Name: 144902412_ELEC.DWG	GF	JY	GF/JY	18.04.13
	Dwn.	Chkd.	Dsgn.	YY.MM.DD

Permit-Seal



Client/Project

GOVERNMENT OF THE
NORTHWEST TERRITORIES

BUNDLED WATER TREATMENT PLANTS

Wekweeti, NT

Title

SCHEMATIC AND SCHEDULES

Project No. 144902412	Scale AS SHOWN
Drawing No.	Sheet Revision


E700

5 of 5


C




PROCESS AND INSTRUMENTATION DRAWING

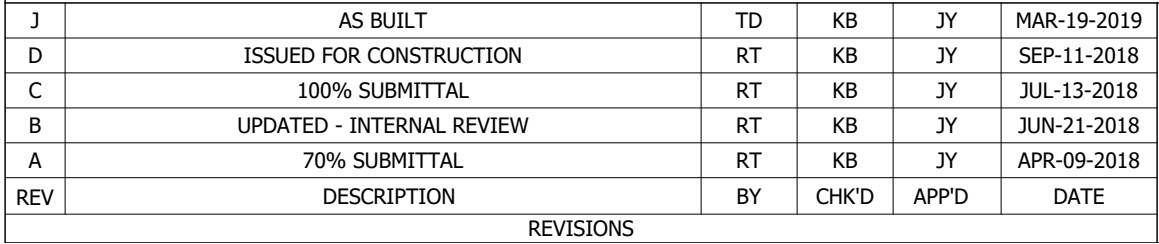


THIS DRAWING IS THE PROPERTY OF AWC WATER SOLUTIONS.
AND CONTAINS PROPRIETARY AND CONFIDENTIAL INFORMATION
WHICH MUST NOT BE DUPLICATED, USED OR DISCLOSED OTHER
THAN EXPRESSLY AUTHORIZED BY AWC WATER SOLUTIONS.

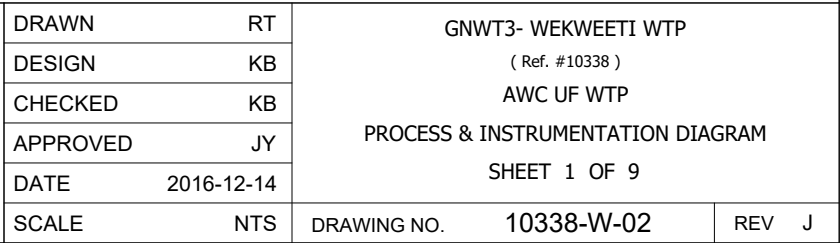

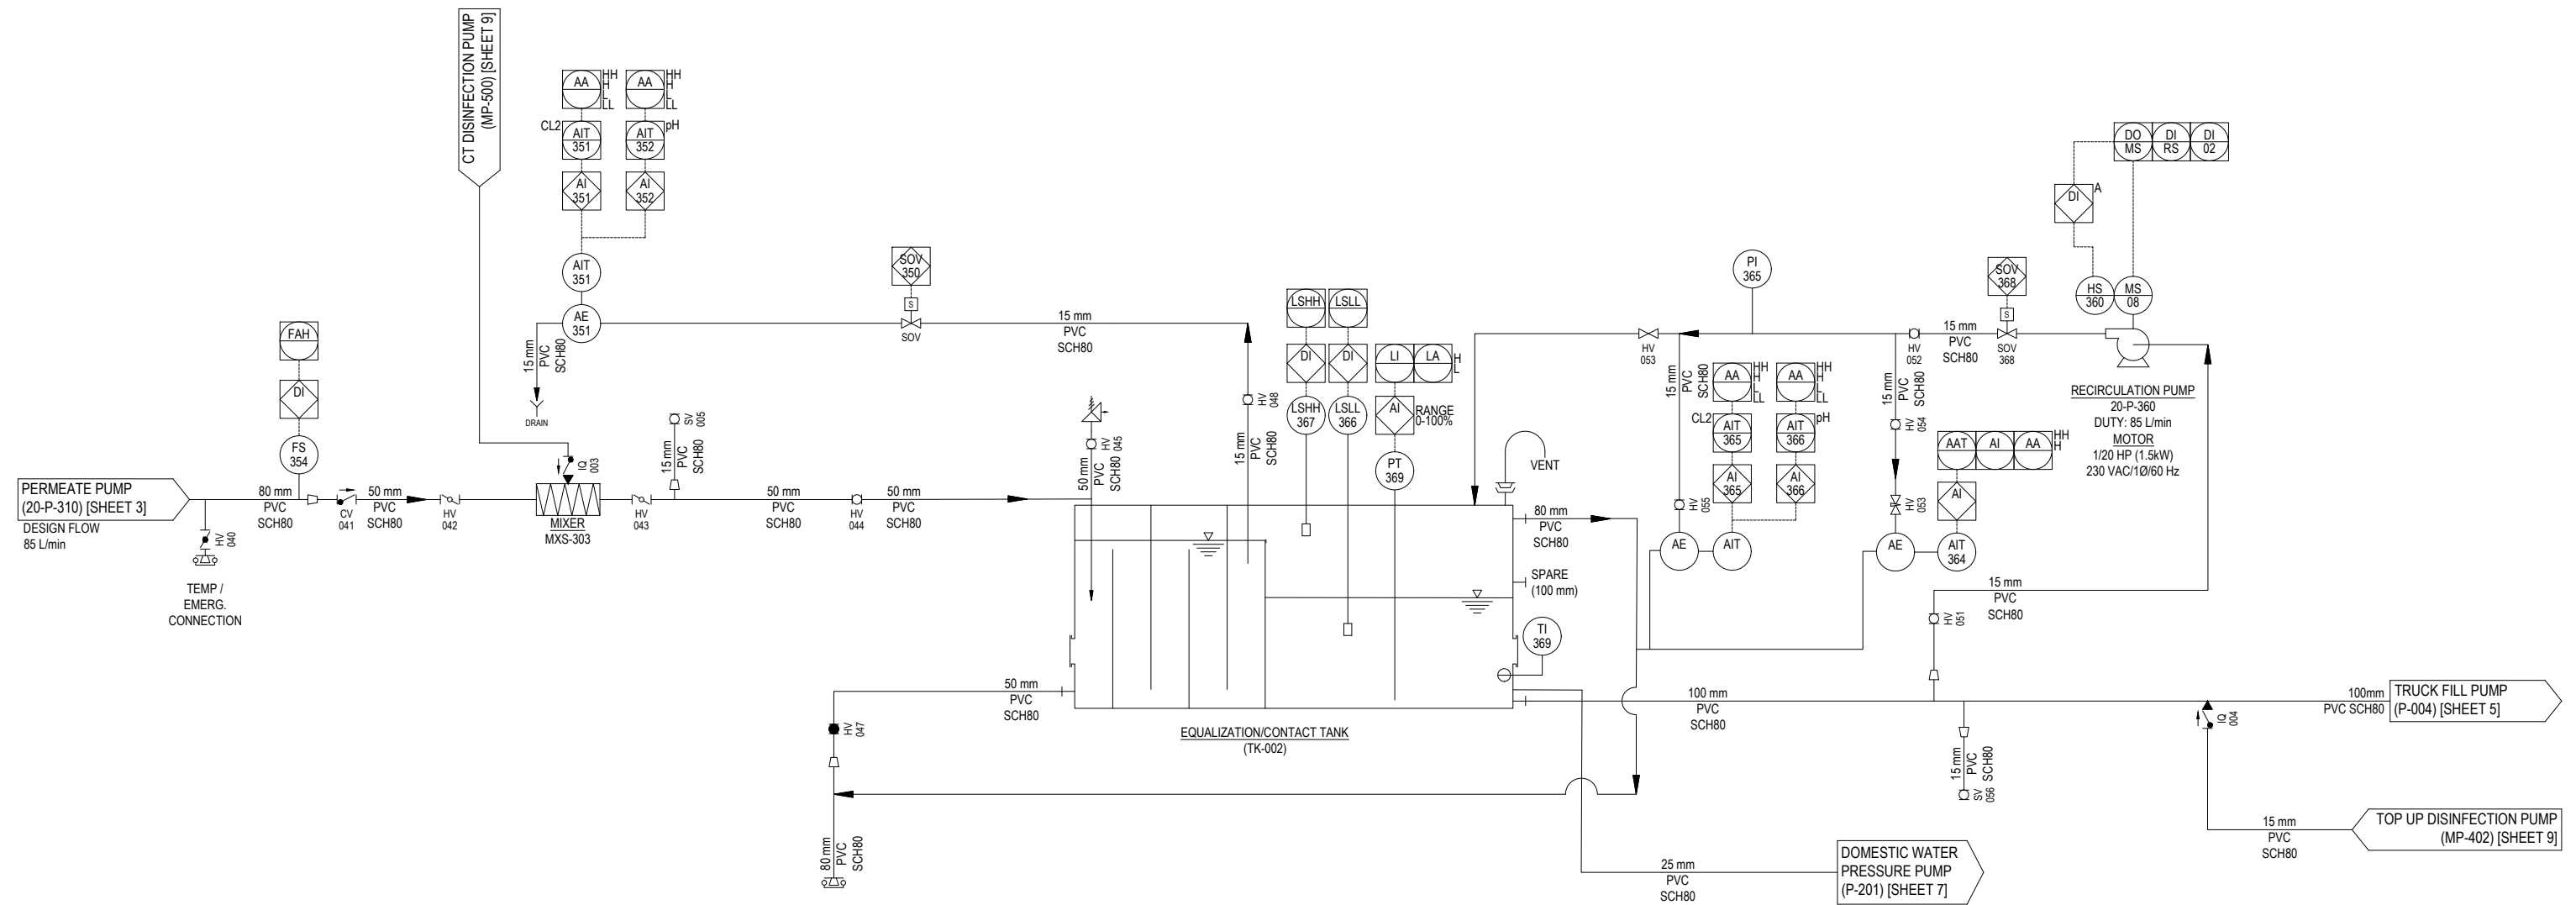

NOTE



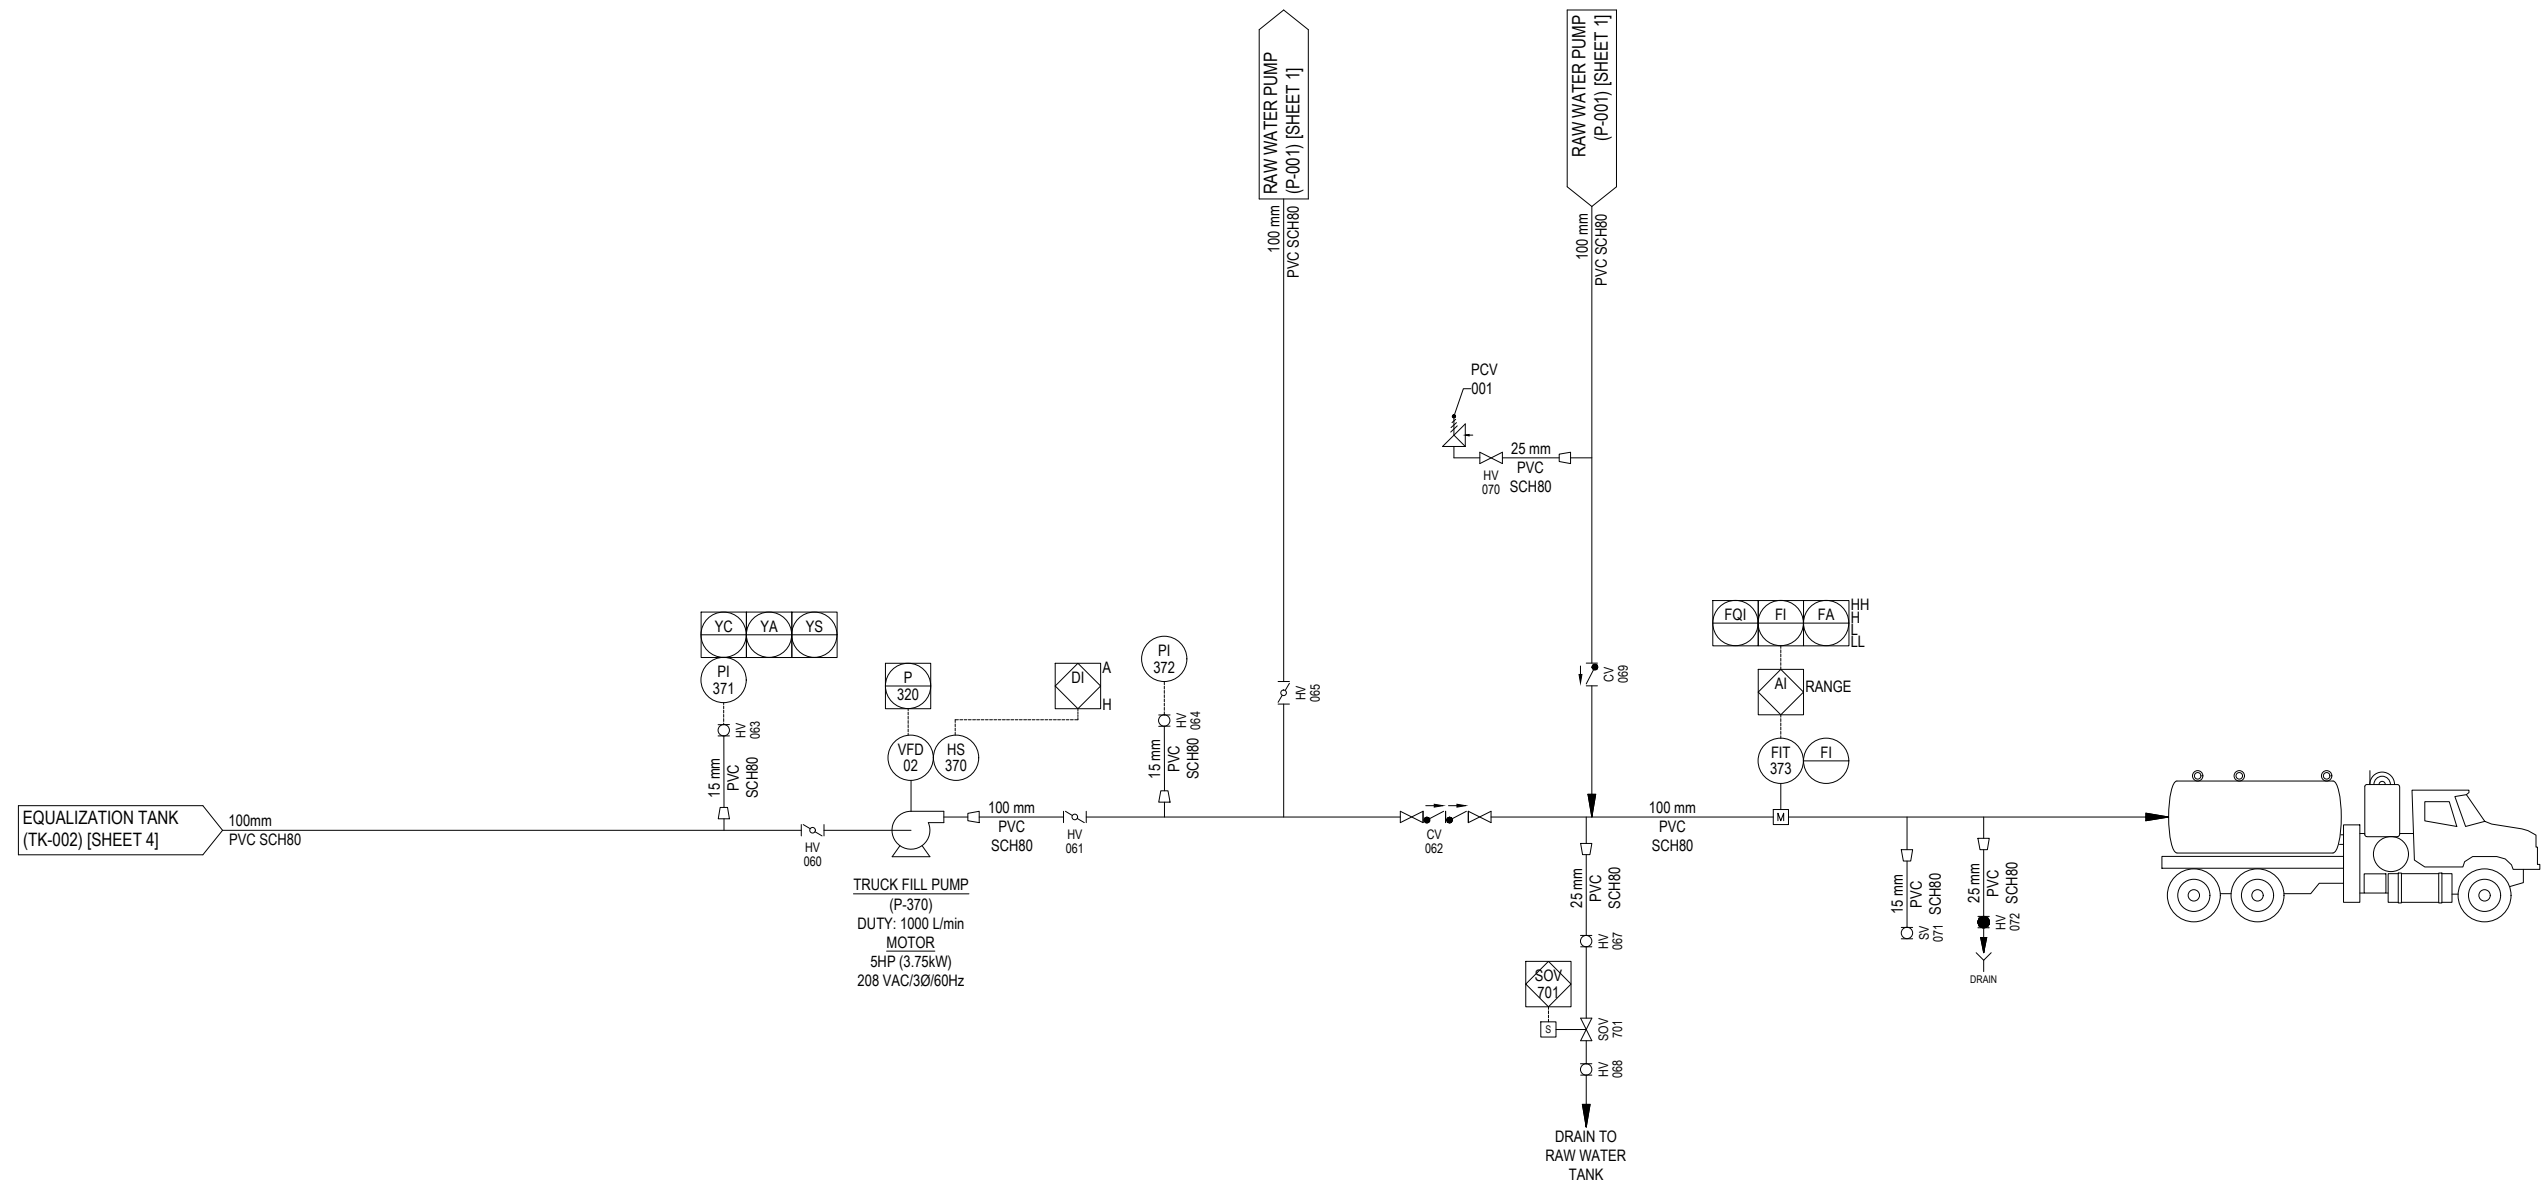


J	AS BUILT	TD	KB	JY	MAR-19-2019
D	ISSUED FOR CONSTRUCTION	RT	KB	JY	SEP-11-2018
C	100% SUBMITTAL	RT	KB	JY	JUL-13-2018
B	UPDATED - INTERNAL REVIEW	RT	KB	JY	JUN-21-2018
A	70% SUBMITTAL	RT	KB	JY	APR-09-2018
REV	DESCRIPTION	BY	CHK'D	APP'D	DATE
REVISIONS					

NOTE

THIS DRAWING IS THE PROPERTY OF AWC WATER SOLUTIONS.
AND CONTAINS PROPRIETARY AND CONFIDENTIAL INFORMATION
WHICH MUST NOT BE DUPLICATED, USED OR DISCLOSED OTHER
THAN EXPRESSLY AUTHORIZED BY AWC WATER SOLUTIONS.



DRAWN	RT	GNWT3- WEKWEETI WTP (Ref. #10338) AWC UF WTP PROCESS & INSTRUMENTATION DIAGRAM SHEET 5 OF 9			
DESIGN	KB				
CHECKED	KB				
APPROVED	JY				
DATE	2016-12-14				
SCALE	NTS	DRAWING NO.	10338-W-02	REV	J

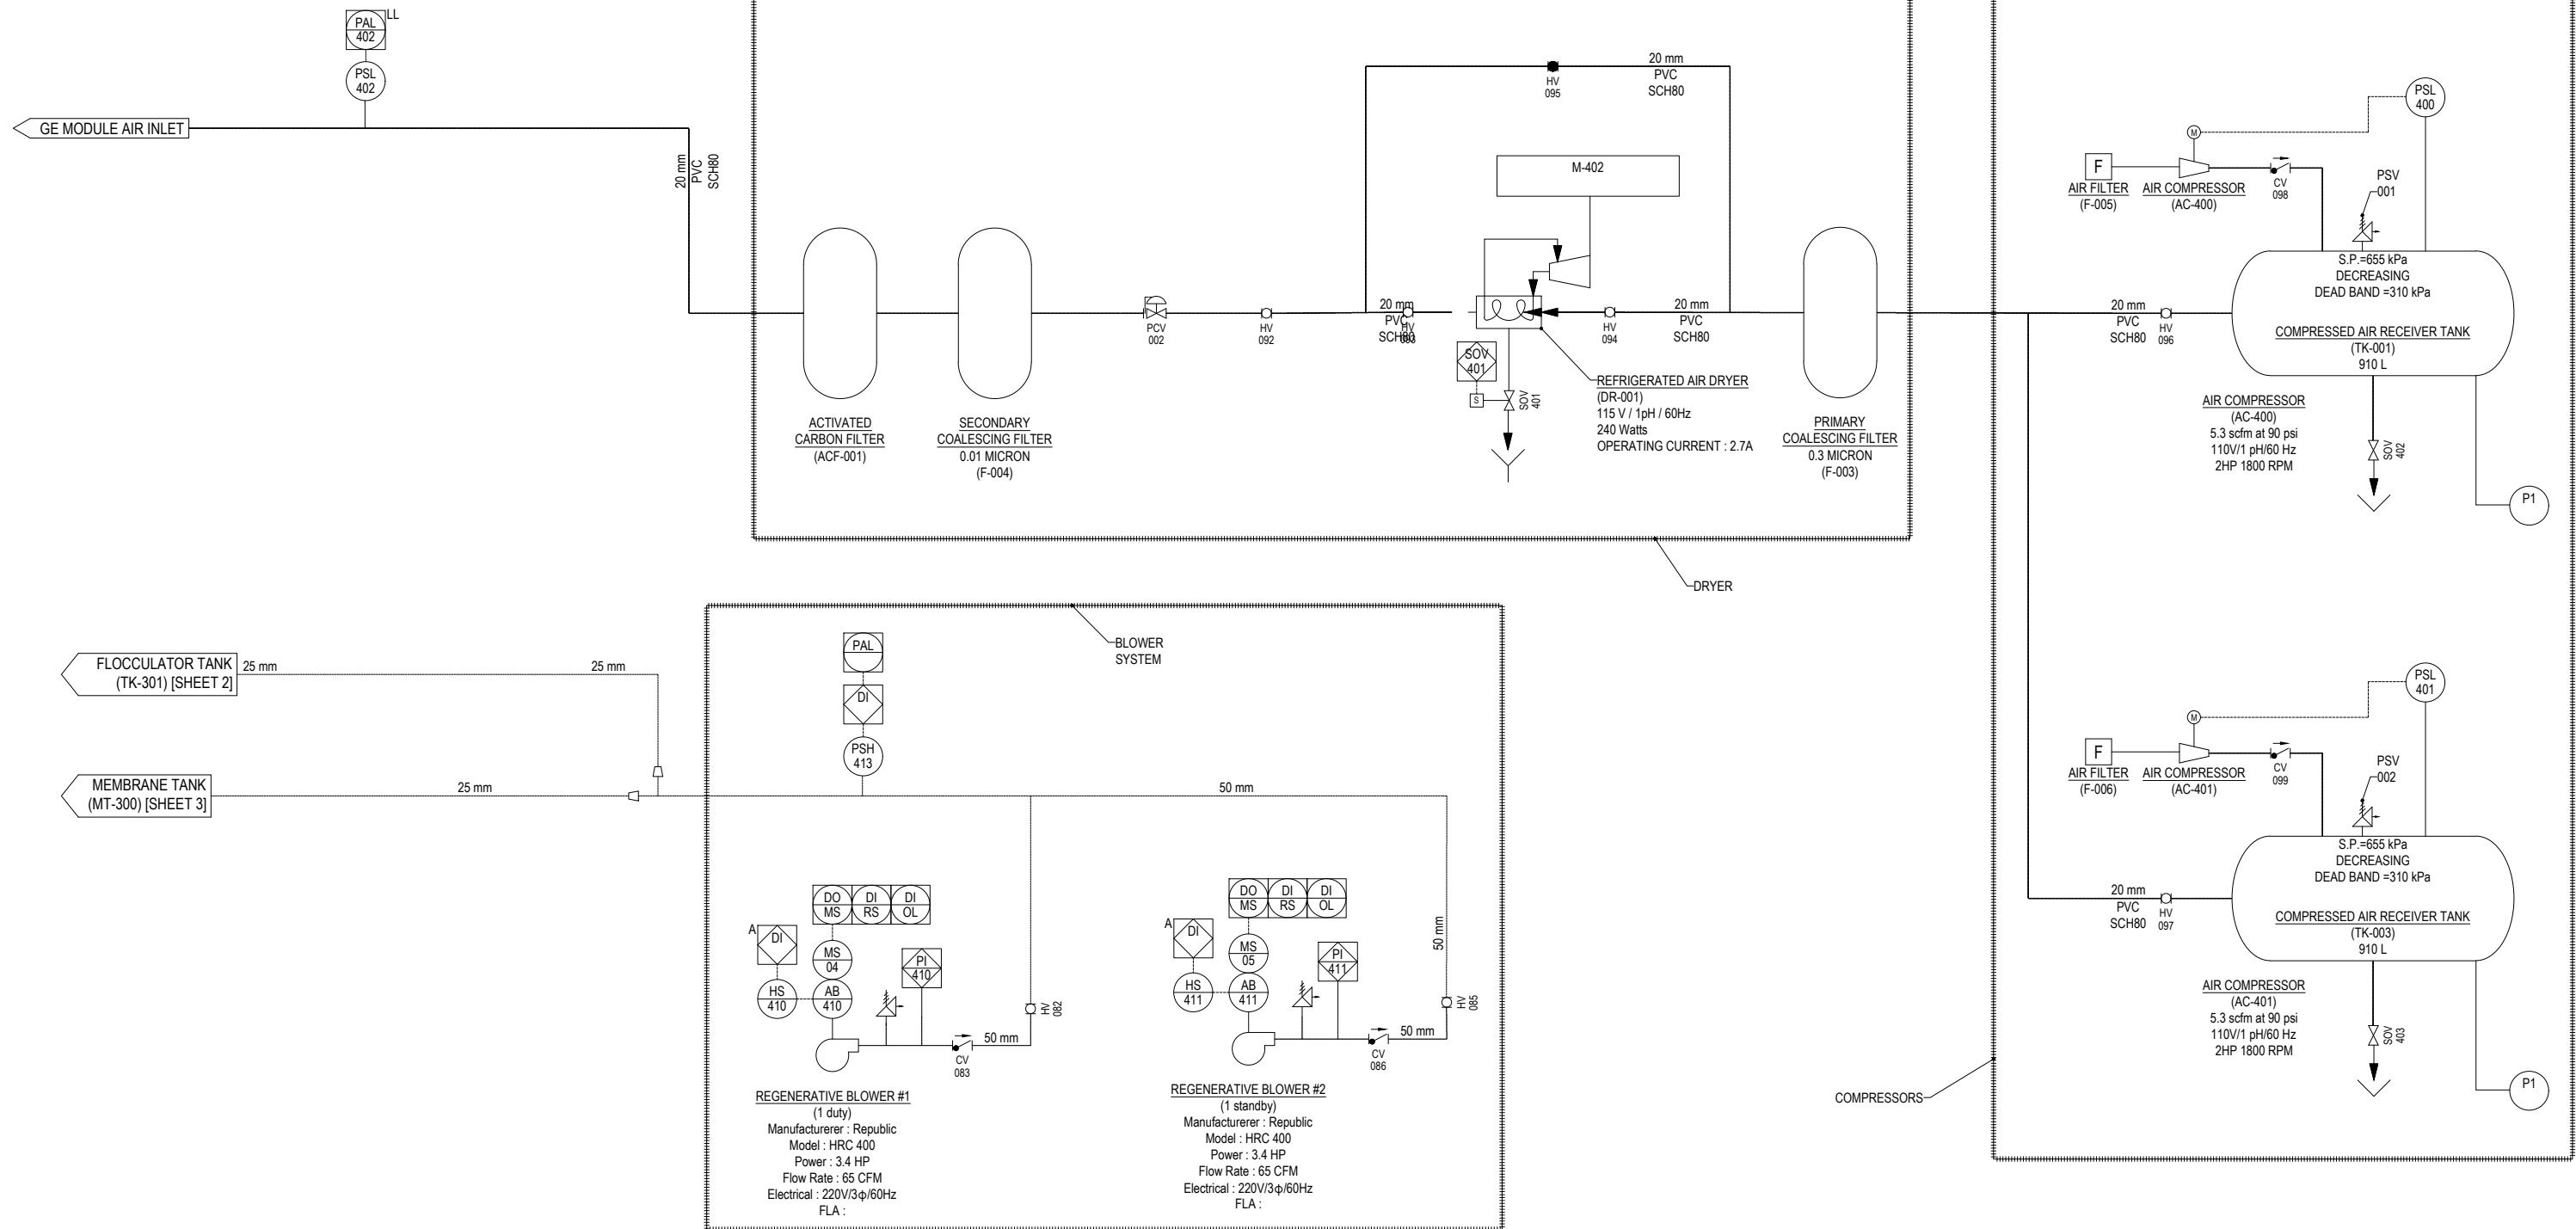


J	AS BUILT	TD	KB	JY	MAR-19-2019
D	ISSUED FOR CONSTRUCTION	RT	KB	JY	SEP-11-2018
C	100% SUBMITTAL	RT	KB	JY	JUL-13-2018
B	UPDATED - INTERNAL REVIEW	RT	KB	JY	JUN-21-2018
A	70% SUBMITTAL	RT	KB	JY	APR-09-2018
REV	DESCRIPTION	BY	CHK'D	APP'D	DATE
REVISIONS					

NOTE

THIS DRAWING IS THE PROPERTY OF AWC WATER SOLUTIONS, AND CONTAINS PROPRIETARY AND CONFIDENTIAL INFORMATION WHICH MUST NOT BE DUPLICATED, USED OR DISCLOSED OTHER THAN EXPRESSLY AUTHORIZED BY AWC WATER SOLUTIONS.



DRAWN	RT	GNWT3- WEKWEETI WTP (Ref. #10338) AWC UF WTP PROCESS & INSTRUMENTATION DIAGRAM SHEET 6 OF 9	
DESIGN	KB		
CHECKED	KB		
APPROVED	JY		
DATE	2016-12-14		
SCALE	NTS	DRAWING NO.	10338-W-02
		REV	J

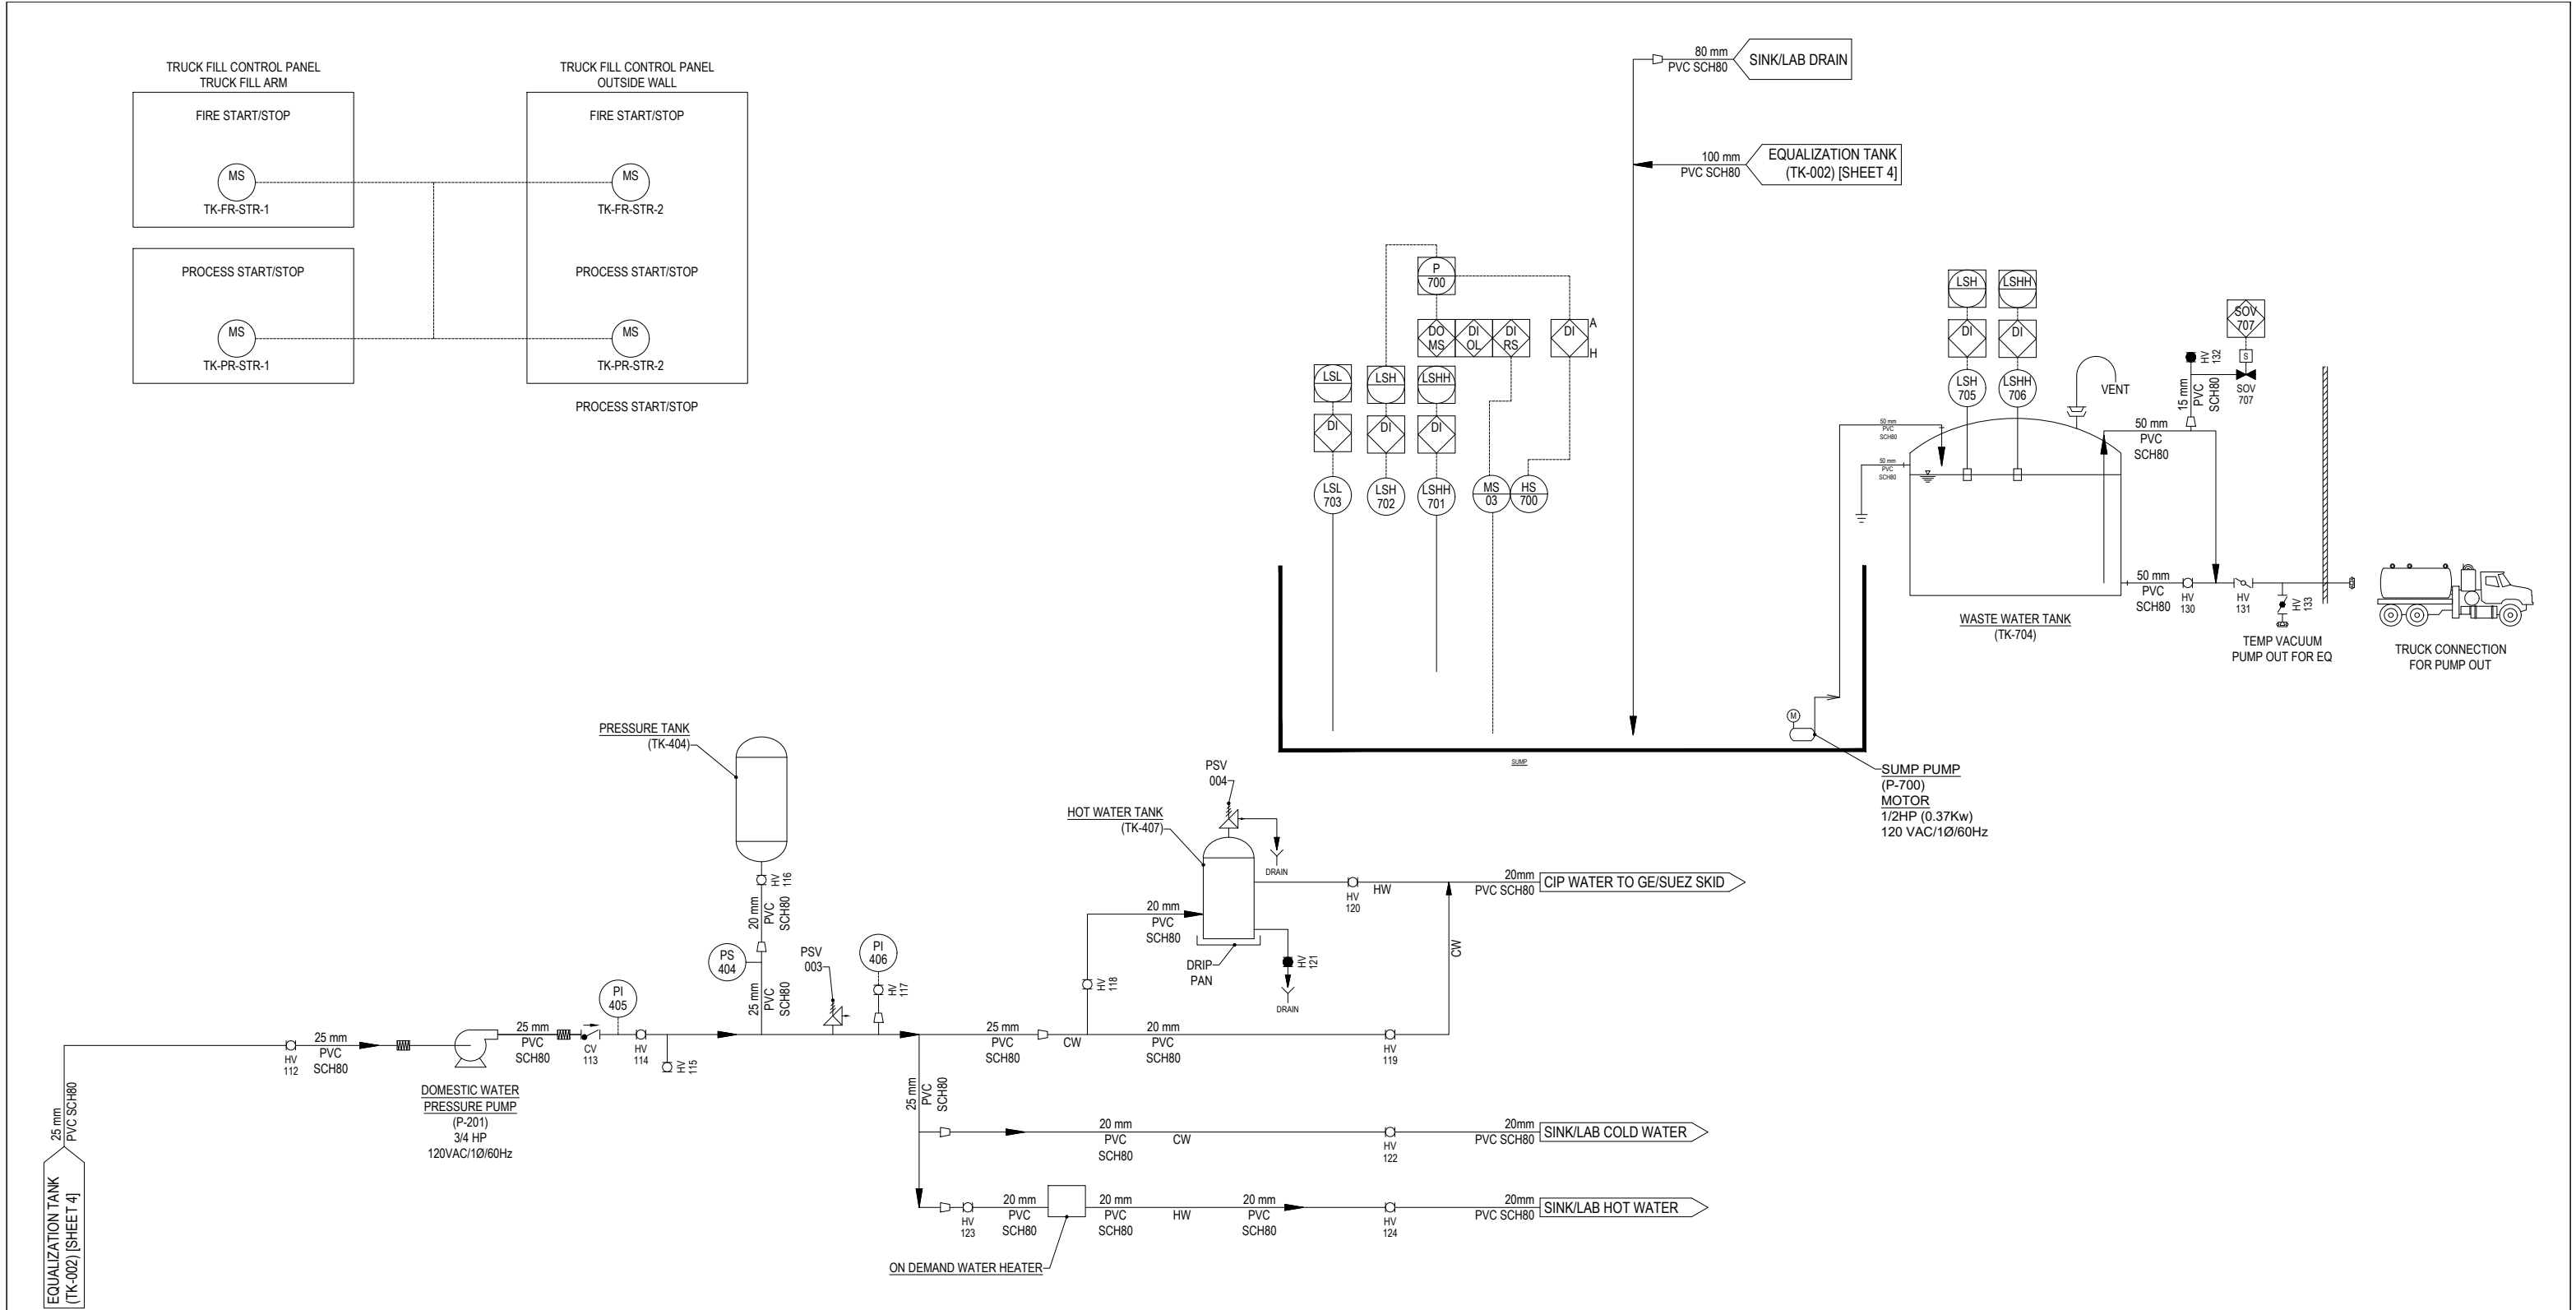

J	AS BUILT	TD	KB	JY	MAR-19-2019
D	ISSUED FOR CONSTRUCTION	RT	KB	JY	SEP-11-2018
C	100% SUBMITTAL	RT	KB	JY	JUL-13-2018
B	UPDATED - INTERNAL REVIEW	RT	KB	JY	JUN-21-2018
A	70% SUBMITTAL	RT	KB	JY	APR-09-2018
REV	DESCRIPTION	BY	CHK'D	APP'D	DATE
REVISIONS					

NOTE



THIS DRAWING IS THE PROPERTY OF AWC WATER SOLUTIONS, AND CONTAINS PROPRIETARY AND CONFIDENTIAL INFORMATION WHICH MUST NOT BE DUPLICATED, USED OR DISCLOSED OTHER THAN EXPRESSLY AUTHORIZED BY AWC WATER SOLUTIONS.

AWC

WATER SOLUTIONS LTD.

#104-19074 22nd Avenue Surrey, BC Canada V3Z 3S6
Phone : 604-638-0760 Fax: 604-638-0795
www.awcwater.com

DRAWN	RT	GNWT3- WEKWEETI WTP (Ref. #10338) AWC UF WTP PROCESS & INSTRUMENTATION DIAGRAM SHEET 7 OF 9	
DESIGN	KB		
CHECKED	KB		
APPROVED	JY		
DATE	2016-12-14		
SCALE	NTS	DRAWING NO.	10338-W-02
		REV	J

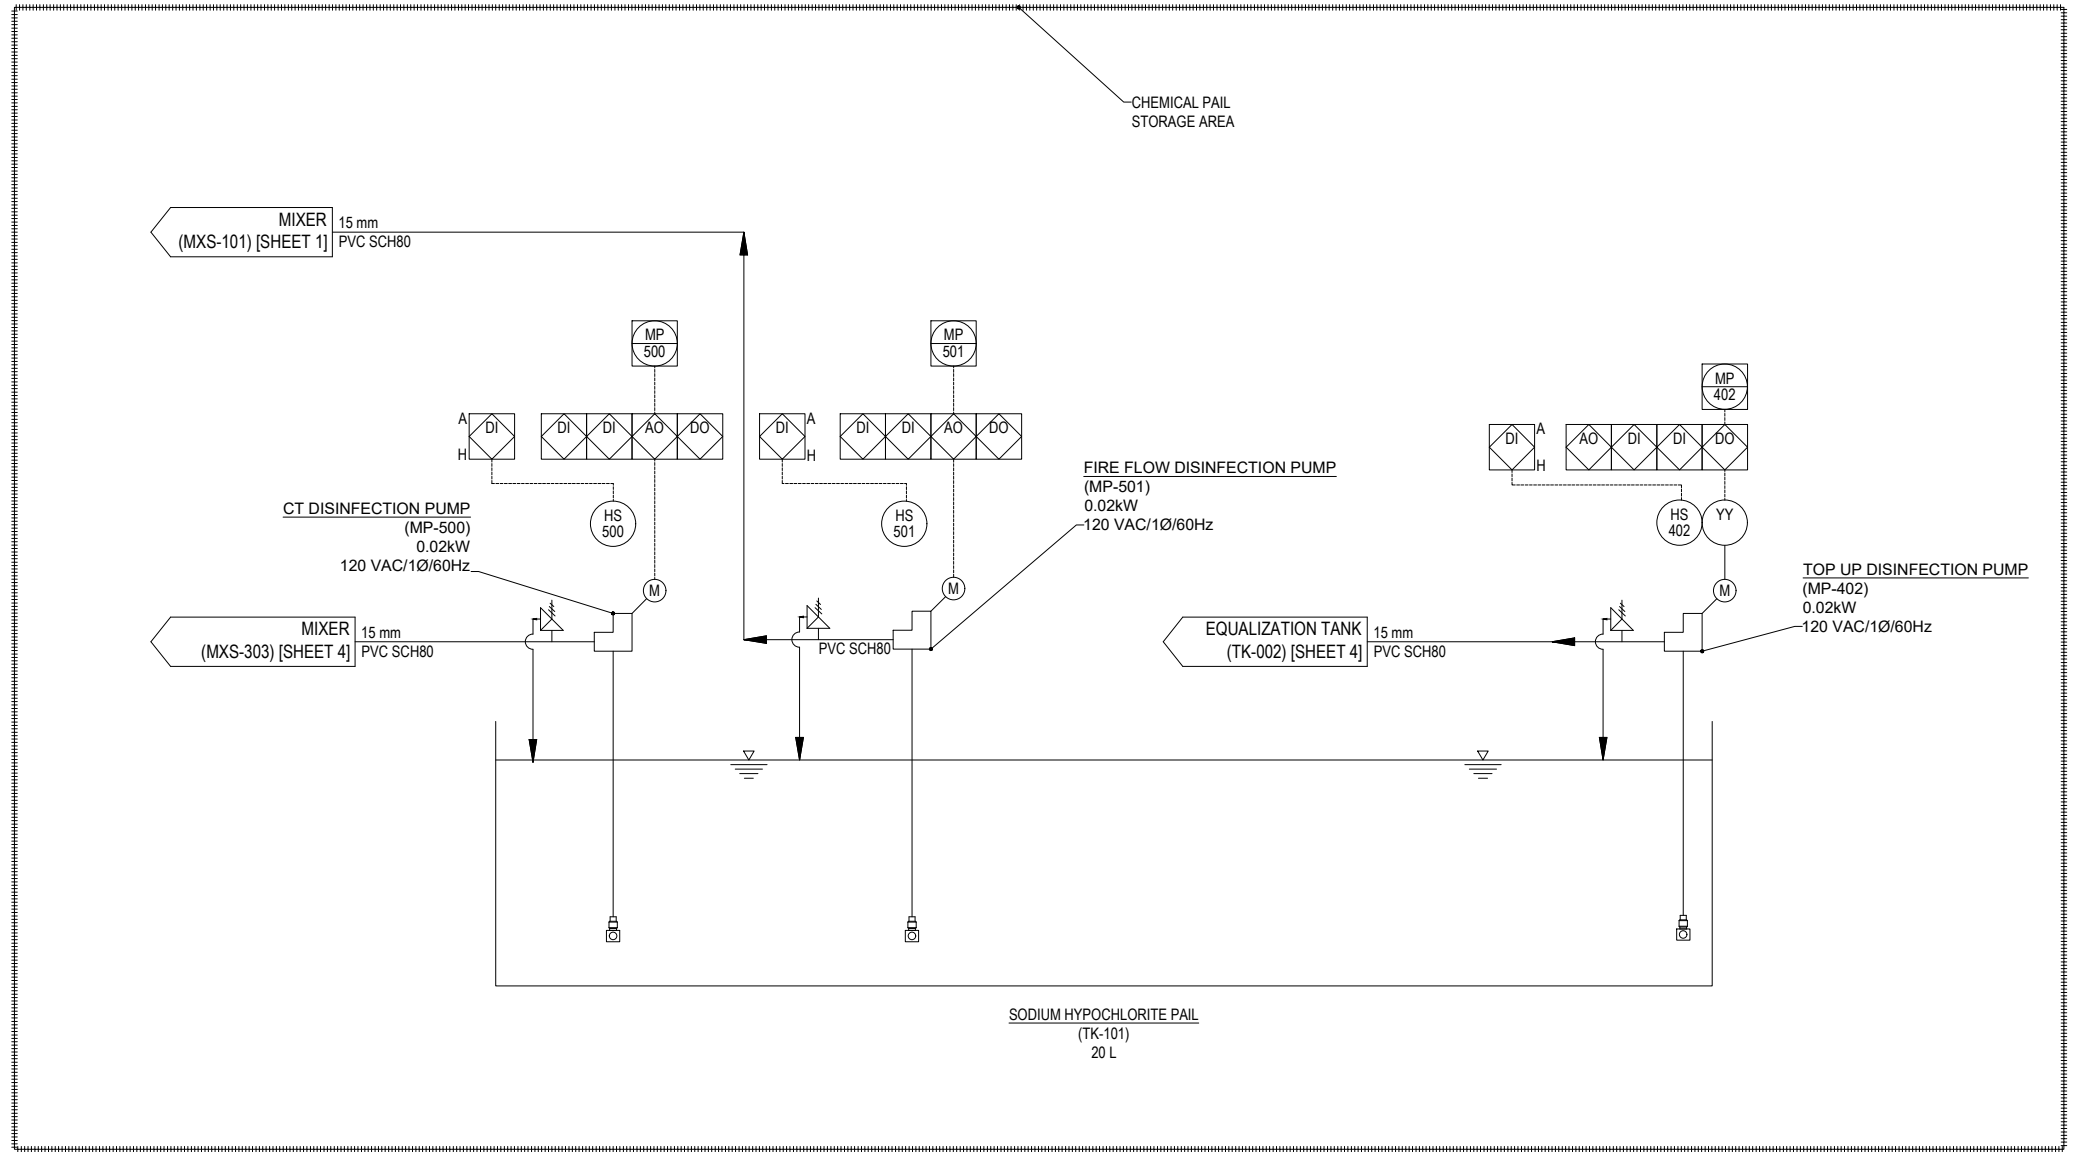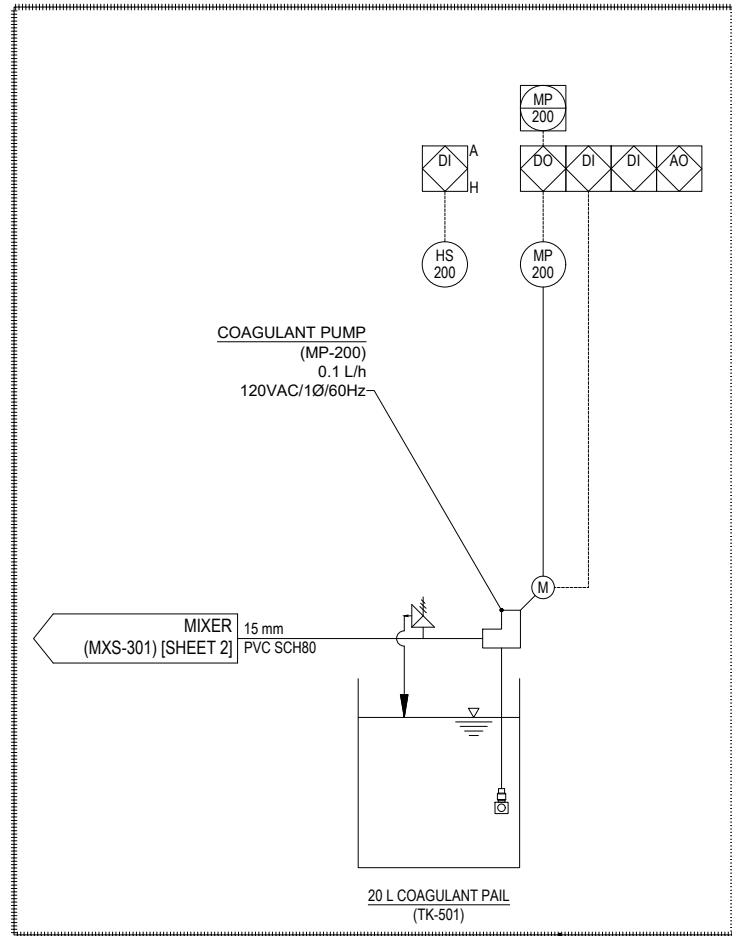

J	AS BUILT	TD	KB	JY	MAR-19-2019
D	ISSUED FOR CONSTRUCTION	RT	KB	JY	SEP-11-2018
C	100% SUBMITTAL	RT	KB	JY	JUL-13-2018
B	UPDATED - INTERNAL REVIEW	RT	KB	JY	JUN-21-2018
A	70% SUBMITTAL	RT	KB	JY	APR-09-2018
REV	DESCRIPTION	BY	CHK'D	APP'D	DATE
REVISIONS					

NOTE	
THIS DRAWING IS THE PROPERTY OF AWC WATER SOLUTIONS, AND CONTAINS PROPRIETARY AND CONFIDENTIAL INFORMATION WHICH MUST NOT BE DUPLICATED, USED OR DISCLOSED OTHER THAN EXPRESSLY AUTHORIZED BY AWC WATER SOLUTIONS.	



AWC WATER SOLUTIONS LTD.
 #104-19074 22nd Avenue Surrey, BC Canada V3Z 3S6
 Phone : 604-638-0760 Fax: 604-638-0795
 www.awcwater.com

DRAWN	RT	GNWT3- WEKWEETI WTP (Ref. #10338) AWC UF WTP PROCESS & INSTRUMENTATION DIAGRAM SHEET 9 OF 9	
DESIGN	KB		
CHECKED	KB		
APPROVED	JY		
DATE	2016-12-14		
SCALE	NTS	DRAWING NO.	10338-W-02
		REV	J