

			ADNOC GAS HABSHAN & BAB CONTROL SYSTEMS UPGRADE (PACKAGE 1) PROJECT NO. 0405323						  			
			COMMENTS RESOLUTION SHEET									
Document Title:			PIPING & INSTRUMENTATION DIAGRAM EARLY THAMMAMA 'B' (HABSHAN) H.P. PIPELINE SCRAPER RECEIVER				AGP Response Code			Prepared By:	VK	
Document No:			13-00-202		Revision No:	B	1. Revise and Re-submit	3. Approved	✓	Checked By:	DV	
AG Ref. No:			ADNOCGP-WTRAN-007160		Date:	10-Oct-2024	2. Approved with comments	4. For Information only		Approved By:	YVR	
SN	Reference		COMPANY Comments				CONSULTANT Response			COMPANY Resolution		
	Page No.	Clause No.										
1	1	-	No Comments				-					
2	1	-	-				Following changes are made in P&ID w.r.t. Rev.B submission as per piping/instrumentation inputs. 1) Tie-in 44-TP-4002 and 44-TP-4009 location updated. 2) Tie-in 44-TP-4011 deleted. 3) Tie-in 44-TP-4005 and 44-TP-4006 location updated. 4) Tie-in 44-TP-4001A location updated. 5) Tie-in 44-TP-4000A/B location updated. 6) New Tie-in 44-TP-4056 added. 7) Note-33 has been added where ever existing valve to be re-used. 8) Existing Spectacle blind deleted beside 44-TP-4004A as it is not present at site.					

010.10.2024ISSUED FOR CONSTRUCTION (IFC)PRAVK/DVYVRAMT

24.05.2024ISSUED FOR APPROVAL (IFA)PRAKP/DVYVRWAM

25.02.2024ISSUED FOR COMPANY REVIEW (ICR)PTNMMMYVRWAM

REVDATEDESCRIPTIONDRAWNCHKDAPPRDAPPRD TARGET

أدنوك للغاز

ADNOC Gas

CONTRACTOR:

ENGINEERING SUBCONTRACTOR:

PROJECT TITLE:

HABSHAN & BAB CONTROL SYSTEMS UPGRADE PACKAGE 1

CONTR. PROJ. No.:

CONTR. DWG. No.:


ADNOC GAS AGREEMENT No.:

ADNOC GAS PROJ. No.:

MASTER COPY

11-Oct-2024idm260310

TEBODIN M.E. LTD.

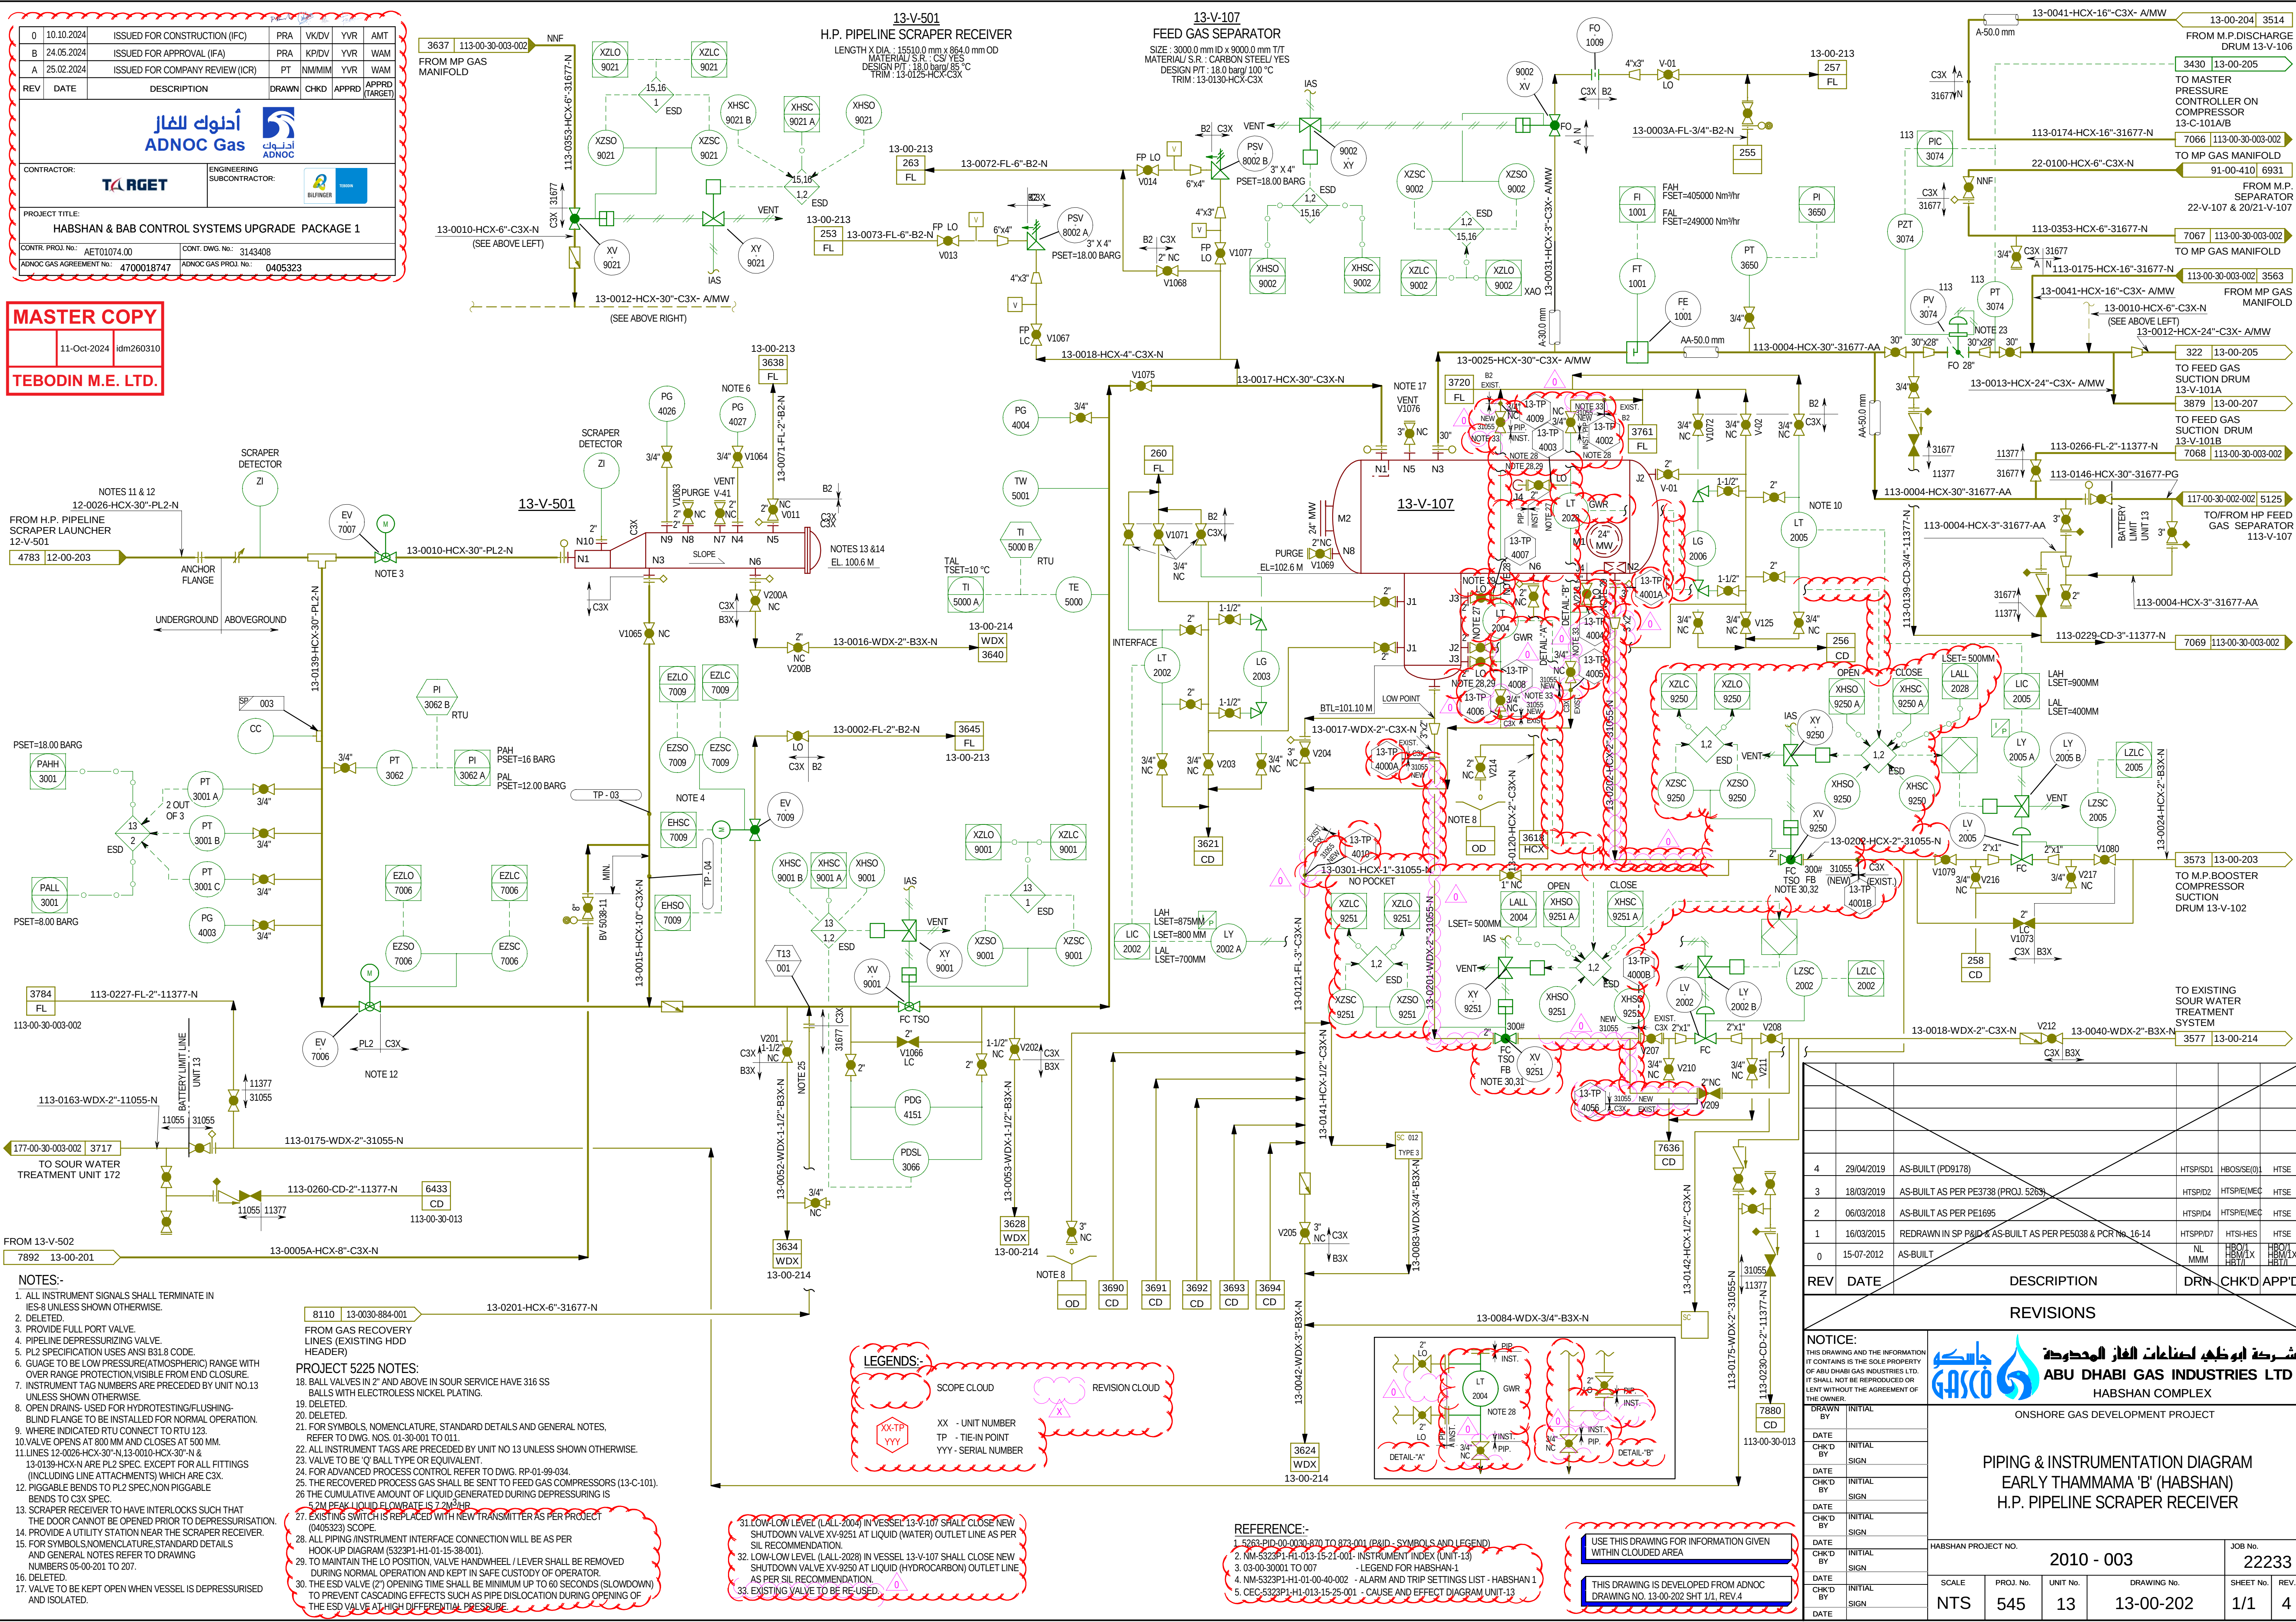

NOTES:-

- ALL INSTRUMENT SIGNALS SHALL TERMINATE IN IES-8 UNLESS SHOWN OTHERWISE.
- DELETED.
- PROVIDE FULL PORT VALVE.
- PIPELINE DEPRESSURIZING VALVE.
- PL2 SPECIFICATION USES ANSI B31.8 CODE.
- GUAGE TO BE LOW PRESSURE (ATMOSPHERIC) RANGE WITH OVER RANGE PROTECTION VISIBLE FROM END CLOSURE.
- INSTRUMENT TAG NUMBERS ARE PRECEDED BY UNIT NO.13 UNLESS SHOWN OTHERWISE.
- OPEN DRAINS- USED FOR HYDROTESTING/FLUSHING- BLIND FLANGE TO BE INSTALLED FOR NORMAL OPERATION.
- WHERE INDICATED RTU CONNECT TO RTU 123.
- VALVE OPENS AT 800 MM AND CLOSSES AT 500 MM.
- LINE 12-0026-HCX-30"-N, 13-0010-HCX-30"-N & 13-0138-HCX-N ARE PL2 SPEC. EXCEPT FOR ALL FITTINGS (INCLUDING LINE ATTACHMENTS) WHICH ARE C3X.
- PIGGABLE BENDS TO PL2 SPEC, NON PIGGABLE BENDS TO C3X SPEC.
- SCRAPER RECEIVER TO HAVE INTERLOCKS SUCH THAT THE DOOR CANNOT BE OPENED PRIOR TO DEPRESSURISING.
- PROVIDE A UTILITY STATION NEAR THE SCRAPER RECEIVER.
- FOR SYMBOLS, NOMENCLATURE, STANDARD DETAILS AND GENERAL NOTES REFER TO DRAWING NUMBERS 05-00-201 TO 207.
- DELETED.
- VALVE TO BE KEPT OPEN WHEN VESSEL IS DEPRESSURISED AND ISOLATED.

PROJECT 5225 NOTES:

18. BALL VALVES IN 2" AND ABOVE IN SOUR SERVICE HAVE 316 SS BALLS WITH ELECTROLESS NICKEL PLATING.
19. DELETED.
20. DELETED.
21. FOR SYMBOLS, NOMENCLATURE, STANDARD DETAILS AND GENERAL NOTES, REFER TO DWG. NOS. 01-30-001 TO 011.
22. ALL INSTRUMENT TAGS ARE PRECEDED BY UNIT NO 13 UNLESS SHOWN OTHERWISE.
23. VALVE TO BE 'Q' BALL TYPE OR EQUIVALENT.
24. FOR ADVANCED PROCESS CONTROL REFER TO DWG. RP-01-99-034.
25. THE RECOVERED PROCESS GAS SHALL BE SENT TO FEED GAS COMPRESSORS (13-C-101).
26. THE CUMULATIVE AMOUNT OF LIQUID GENERATED DURING DEPRESSURING IS 5.2M PEAK LIQUID FLOW RATE IS 7.2M3/H.
27. EXISTING SWITCH IS REPLACED WITH NEW TRANSMITTER AS PER PROJECT (0405323) SCOPE.
28. ALL PIPING INSTRUMENT INTERFACE CONNECTION WILL BE AS PER HOOK UP DIAGRAM (5323P1-HI-01-15-38-001).
29. TO MAINTAIN THE LO POSITION, VALVE HANDWHEEL / LEVER SHALL BE REMOVED DURING NORMAL OPERATION AND KEPT IN SAFE CUSTODY OF OPERATOR.
30. THE ESD VALVE (2") OPENING TIME SHALL BE MINIMUM UP TO 60 SECONDS (SLOWDOWN) TO PREVENT CASCADING EFFECTS SUCH AS PIPE DISLOCATION DURING OPENING OF THE ESD VALVE AT HIGH DIFFERENTIAL PRESSURE.
31. LOW-LOW LEVEL (LALL-2004) IN VESSEL 13-V-107 SHALL CLOSE NEW SHUTDOWN VALVE XV-9251 AT LIQUID (WATER) OUTLET LINE AS PER SIL RECOMMENDATION.
32. LOW-LOW LEVEL (LALL-2028) IN VESSEL 13-V-107 SHALL CLOSE NEW SHUTDOWN VALVE XV-9250 AT LIQUID (HYDROCARBON) OUTLET LINE AS PER SIL RECOMMENDATION.
33. EXISTING VALVE TO BE RE-USED.

LEGENDS:

SCOPE CLOUD

REVISION CLOUD

XX-TP

YYY

XX - UNIT NUMBER

TP - TIE-IN POINT

YYY - SERIAL NUMBER

REFERENCE:-

- 5263 PID-00-0030-870 TO 873-001 (P&ID - SYMBOLS AND LEGEND)
- NM-5323P1-HI-013-15-21-001- INSTRUMENT INDEX (UNIT-13)
- 03-00-30001 TO 007 - LEGEND FOR HABSHAN-1
- NM-5323P1-HI-01-00-40-002 - ALARM AND TRIP SETTINGS LIST - HABSHAN 1
- CEC-5323P1-HI-013-15-25-001 - CAUSE AND EFFECT DIAGRAM UNIT-13

USE THIS DRAWING FOR INFORMATION GIVEN WITHIN CLOUDED AREA

THIS DRAWING IS DEVELOPED FROM ADNOC DRAWING NO. 13-00-202 SH1 JLT, REV.4

429/04/2019AS-BUILT (PD9178)HTSPISD1HBOS/SE01HTSE

318/03/2019AS-BUILT AS PER PE3738 (PROJ. 5263)HTSPID2HTSP/MECHTSE

206/03/2018AS-BUILT AS PER PE1695HTSPID4HTSP/MECHTSE

116/03/2015REDRAWN IN SP P&ID & AS-BUILT AS PER PE5038 & PCR No. 16-14HTSPID7HTSH/ESHHTSE

015-07-2012AS-BUILTMMHBM/IXHBM/IXHBM/IXHBM/IX

REVDATEDESCRIPTIONDRNCHK'DAPPR'D

REVISIONS

NOTICE:

THIS DRAWING AND THE INFORMATION IT CONTAINS IS THE SOLE PROPERTY OF ABU DHABI GAS INDUSTRIES LTD. IT SHALL NOT BE REPRODUCED OR LENT WITHOUT THE AGREEMENT OF THE OWNER.

ABU DHABI GAS INDUSTRIES LTD

HABSHAN COMPLEX

ONSHORE GAS DEVELOPMENT PROJECT

PIPING & INSTRUMENTATION DIAGRAM

EARLY THAMMAMA 'B' (HABSHAN)

H.P. PIPELINE SCRAPER RECEIVER

HABSHAN PROJECT NO.

2010 - 003

JOB No.

22233

SCALE

NTS

PROJ. No.

545

UNIT No.

13

DRAWING No.

13-00-202

SHEET No.

1/1

REV.

4

FILENAME : 13-00-202.pid