


			ADNOC GAS HABSHAN & BAB CONTROL SYSTEMS UPGRADE (PACKAGE 1) PROJECT NO. 0405323						  				
			COMMENTS RESOLUTION SHEET										
Document Title:			PIPING & INSTRUMENTATION DIAGRAM EARLY THAMMAMA 'B' (HABSHAN) M.P. BOOSTER COMPRESSOR 2ND STAGE				AGP Response Code			Prepared By:	VK		
Document No:			13-00-204		Revision No:	B	1. Revise and Re-submit		3. Approved	✓	Checked By:	DV	
AG Ref. No:			ADNOCGP-WTRAN-007160		Date:	3-Jun-2024	2. Approved with comments		4. For Information only		Approved By:	YVR	
SN	Reference		COMPANY Comments				CONSULTANT Response			COMPANY Resolution			
	Page No.	Clause No.											
1	1	Process Comment	Please review there is a change between Rev.A and Rev.B Changes shall be mentioned in the CRS or notes (typical).				Noted. Changes mentioned in row 2 of the CRS.						
2	1	-	-				Following changes are made in P&ID w.r.t. Rev.B submission as per piping/instrumentation inputs. 1. Note 17 and 18 updated. 2. Note 26 and 27 added. 3. All PT valve are now updated as flange valve. 4. Existing thermowell TW-5009 & 5011 shown as these thermowells are not used and new thermowell will be installed. 5. New Tie-in number provided for TE-5544C & 5545C for installation of new thermowell. 6. Pipe spec is mentioned for segment in piping scope for FE-1527 and TE-5544C.						

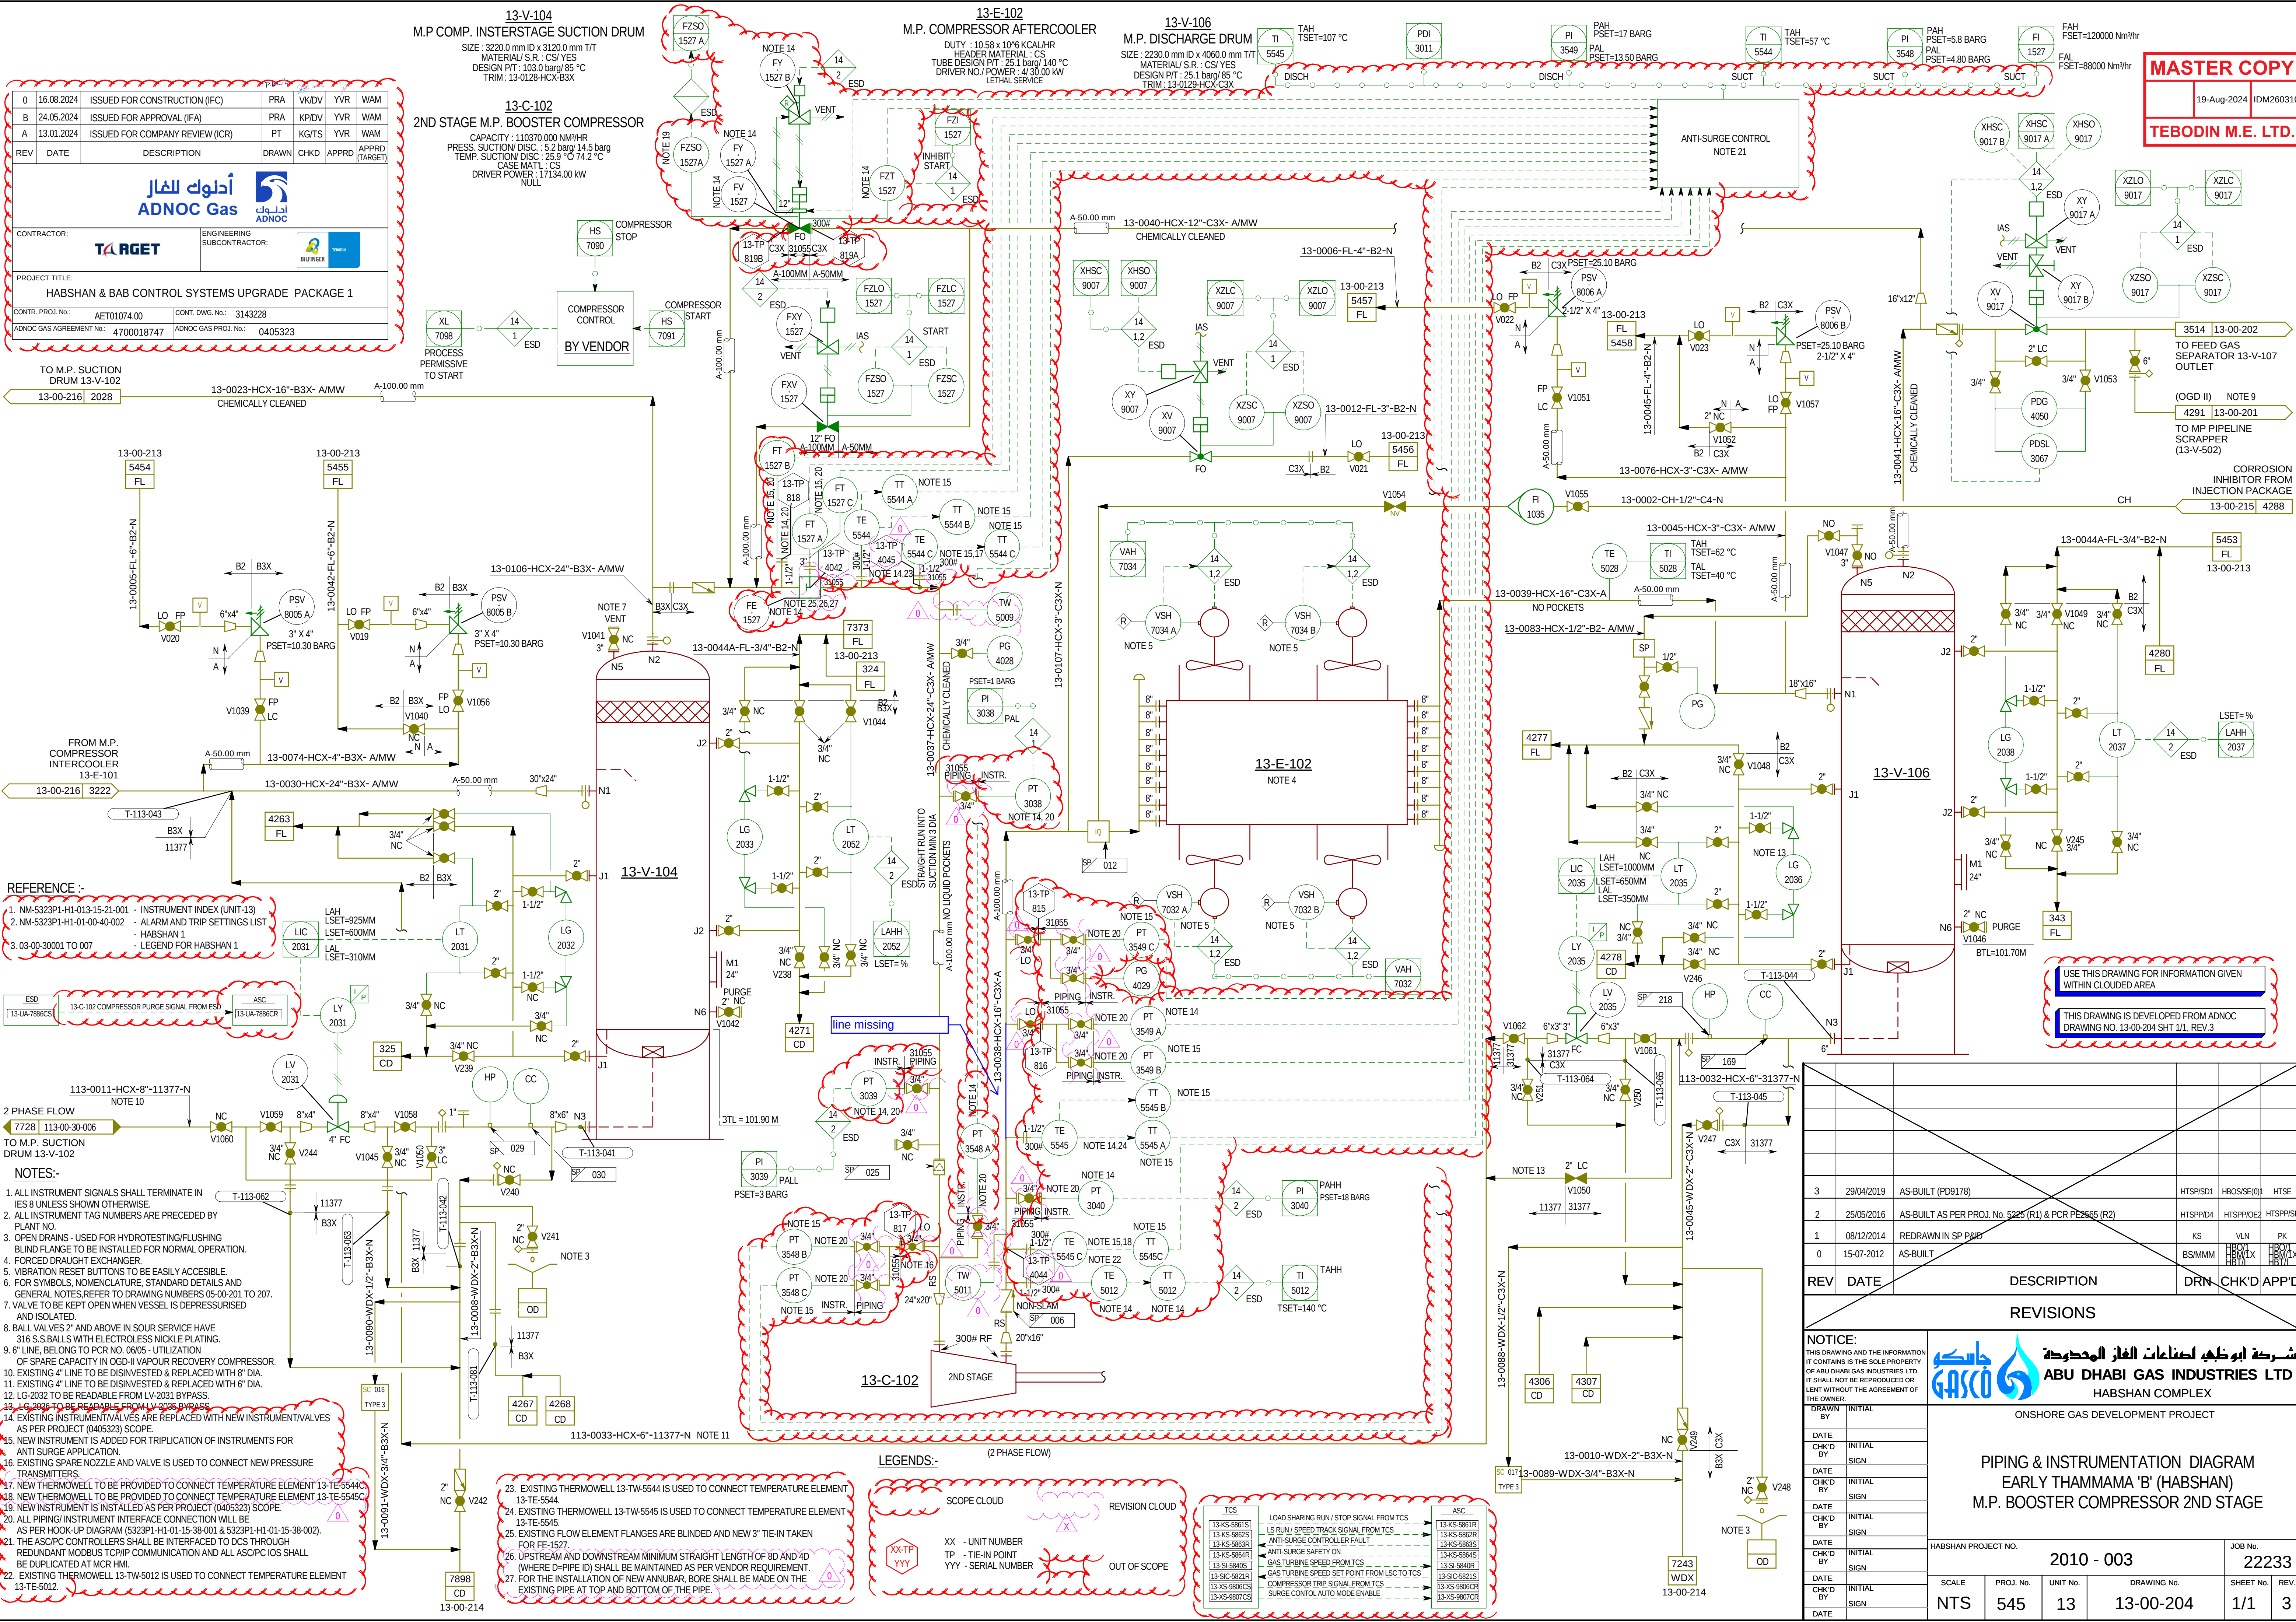

0	16.08.2024	ISSUED FOR CONSTRUCTION (IFC)	PRA	VK/DV	YVR	WAM
B	24.05.2024	ISSUED FOR APPROVAL (IFA)	PRA	KP/DV	YVR	WAM
A	13.01.2024	ISSUED FOR COMPANY REVIEW (ICR)	PT	KG/TS	YVR	WAM
REV	DATE	DESCRIPTION	DRAWN	CHKD	APPRD	APPRD (TARGET)
ADNOC Gas ADNOC						
CONTRACTOR: TARGET						
PROJECT TITLE: HABSHAN & BAB CONTROL SYSTEMS UPGRADE PACKAGE 1						
CONTR. PROJ. No.: AET01074.00 CONT. DWG. No.: 3143228						
ADNOC GAS AGREEMENT No.: 4700018747 ADNOC GAS PROJ. No.: 0405323						

MASTER COPY

19-Aug-2024 IDM26031C

TEBODIN M.E. LTD.

- REFERENCE :-**
- 1. NM-5323P1-H1-013-15-21-001 - INSTRUMENT INDEX (UNIT-13)
 - 2. NM-5323P1-H1-01-00-40-002 - ALARM AND TRIP SETTINGS LIST - HABSHAN 1
 - 3. 03-00-30001 TO 007 - LEGEND FOR HABSHAN 1

- NOTES:-**
- ALL INSTRUMENT SIGNALS SHALL TERMINATE IN IES 8 UNLESS SHOWN OTHERWISE.
 - ALL INSTRUMENT TAG NUMBERS ARE PRECEDED BY PLANT NO.
 - OPEN DRAINS - USED FOR HYDROTESTING/FLUSHING BLIND FLANGE TO BE INSTALLED FOR NORMAL OPERATION.
 - FORCED DRAUGHT EXCHANGER
 - VIBRATION RESET BUTTONS TO BE EASILY ACCESSIBLE.
 - FOR SYMBOLS, NOMENCLATURE, STANDARD DETAILS AND GENERAL NOTES, REFER TO DRAWING NUMBERS 05-00-201 TO 207.
 - VALVE TO BE KEPT OPEN WHEN VESSEL IS DEPRESSURISED AND ISOLATED.
 - BALL VALVES 2" AND ABOVE IN SOUR SERVICE HAVE 316 S.S. BALLS WITH ELECTROLESS NICKEL PLATING.
 - 6" LINE, BELONG TO PCR NO. 0605 - UTILIZATION OF SPARE CAPACITY IN OGD-II VAPOUR RECOVERY COMPRESSOR.
 - EXISTING 4" LINE TO BE DISINVESTED & REPLACED WITH 8" DIA
 - EXISTING 4" LINE TO BE DISINVESTED & REPLACED WITH 6" DIA
 - LG-2032 TO BE READABLE FROM LV-2031 BYPASS.
 - LG-2036 TO BE READABLE FROM LV-2035 BYPASS.
 - EXISTING INSTRUMENT/VALVES ARE REPLACED WITH NEW INSTRUMENT/VALVES AS PER PROJECT (0405323) SCOPE.
 - NEW INSTRUMENT IS ADDED FOR TRIPLICATION OF INSTRUMENTS FOR ANTI SURGE APPLICATION.
 - EXISTING SPARE NOZZLE AND VALVE IS USED TO CONNECT NEW PRESSURE TRANSMITTERS.
 - NEW THERMOWELL TO BE PROVIDED TO CONNECT TEMPERATURE ELEMENT 13-TE-5544C.
 - NEW THERMOWELL TO BE PROVIDED TO CONNECT TEMPERATURE ELEMENT 13-TE-5545C.
 - NEW INSTRUMENT IS INSTALLED AS PER PROJECT (0405323) SCOPE.
 - ALL PIPING/INSTRUMENT INTERFACE CONNECTION WILL BE AS PER HOOK-UP DIAGRAM (5323P1-H1-01-15-38-001 & 5323P1-H1-01-15-38-002).
 - THE ASC/PC CONTROLLERS SHALL BE INTERFACED TO DCS THROUGH REDUNDANT MODBUS TCP/IP COMMUNICATION AND ALL ASC/PC I/Os SHALL BE DUPLICATED AT MCR HMI.
 - EXISTING THERMOWELL 13-TW-5012 IS USED TO CONNECT TEMPERATURE ELEMENT 13-TE-5012.
 - EXISTING THERMOWELL 13-TW-5544 IS USED TO CONNECT TEMPERATURE ELEMENT 13-TE-5544.
 - EXISTING THERMOWELL 13-TW-5545 IS USED TO CONNECT TEMPERATURE ELEMENT 13-TE-5545.
 - EXISTING FLOW ELEMENT FLANGES ARE BLINDED AND NEW 3" TIE-IN TAKEN FOR FE-1527.
 - UPSTREAM AND DOWNSTREAM MINIMUM STRAIGHT LENGTH OF 8D AND 4D (WHERE D=PIPE ID) SHALL BE MAINTAINED AS PER VENDOR REQUIREMENT.
 - FOR THE INSTALLATION OF NEW ANNULAR, BORE SHALL BE MADE ON THE EXISTING PIPE AT TOP AND BOTTOM OF THE PIPE.

- LEGENDS:-**
- SCOPE CLOUD**
- XX - UNIT NUMBER
TP - TIE-IN POINT
YYY - SERIAL NUMBER
- REVISION CLOUD**
- OUT OF SCOPE

13-KS-5861S	LOAD SHARING RUN / STOP SIGNAL FROM TCS	13-KS-5861R	ASC
13-KS-5862S	LS RUN / SPEED TRACK SIGNAL FROM TCS	13-KS-5862R	ASC
13-KS-5863S	ANTI-SURGE CONTROLLER FAULT	13-KS-5863R	ASC
13-KS-5864S	ANTI-SURGE SAFETY ON	13-KS-5864R	ASC
13-KS-5865S	GAS TURBINE SPEED FROM TCS	13-KS-5865R	ASC
13-KS-5866S	GAS TURBINE SPEED SET POINT FROM TCS TO TCS	13-KS-5866R	ASC
13-KS-5867S	COMPRESSOR TRIP SIGNAL FROM TCS	13-KS-5867R	ASC
13-KS-5868S	SURGE CONTROL AUTO MODE ENABLE	13-KS-5868R	ASC

3	29/04/2019	AS-BUILT (PD9178)	HTSP/SD1	HBOS/SE/01	HTSE
2	25/05/2016	AS-BUILT AS PER PROJ. No. 5225 (R1) & PCR PE2665 (R2)	HTSP/SD4	HTSP/PE2	HTSP/PE
1	08/12/2014	REDRAWN IN SP B&B	KS	VLN	PK
0	15-07-2012	AS-BUILT	BS/MMM	HBO/IX	HBO/IX
REV	DATE	DESCRIPTION	DRN	CHK'D	APP'D
REVISIONS					
NOTICE: THIS DRAWING AND THE INFORMATION IT CONTAINS IS THE SOLE PROPERTY OF ABU DHABI GAS INDUSTRIES LTD. IT SHALL NOT BE REPRODUCED OR LENT WITHOUT THE AGREEMENT OF THE OWNER.					
ABU DHABI GAS INDUSTRIES LTD HABSHAN COMPLEX					
ONSHORE GAS DEVELOPMENT PROJECT					
PIPING & INSTRUMENTATION DIAGRAM EARLY THAMMAMA 'B' (HABSHAN) M.P. BOOSTER COMPRESSOR 2ND STAGE					
HABSHAN PROJECT NO.		2010 - 003	JOB No.		22233
SCALE	PROJ. No.	UNIT No.	DRAWING No.	SHEET No.	REV.
NTS	545	13	13-00-204	1/1	3