


			ADNOC GAS HABSHAN & BAB CONTROL SYSTEMS UPGRADE (PACKAGE 1) PROJECT NO. 0405323										
			COMMENTS RESOLUTION SHEET										
Document Title:			PIPING & INSTRUMENTATION DIAGRAM FEED GAS COMPRESSOR 2ND STAGE TRAIN 2 EARLY THAMMAMA 'B' (HABSHAN)				AGP Response Code			Prepared By:	CA		
Document No:			13-00-208		Revision No:	B	1. Revise and Re-submit		3. Approved	✓	Checked By:	DV	
AG Ref. No:			ADNOCGP-WTRAN-007160		Date:	23-Aug-2024	2. Approved with comments		4. For Information only		Approved By:	YVR	
SN	Reference		COMPANY Comments				CONSULTANT Response			COMPANY Resolution			
	Page No.	Clause No.											
1	-	-	No Comments.										
2	1	-					Following changes are made in P&ID w.r.t. Rev.B submission as per piping/instrumentation inputs. 1. Note 18 and 19 updated. 2. Note 29,30,31 and 32 added. 3. All PT valve are now updated as flange valve. 4. Existing thermowell TW-5121 & 5123 shown as these thermowells are not used and new thermowell will be installed. 5. New Tie-in number provided for TE-5744C & 5745C for installation of new thermowell. 6. Pipe spec is mentioned for segment in piping scope for TE-5744C and TE-5745C. 7. Tie-in point location updated for FE-1727. 8. Cause and effect document no. added in reference list.						

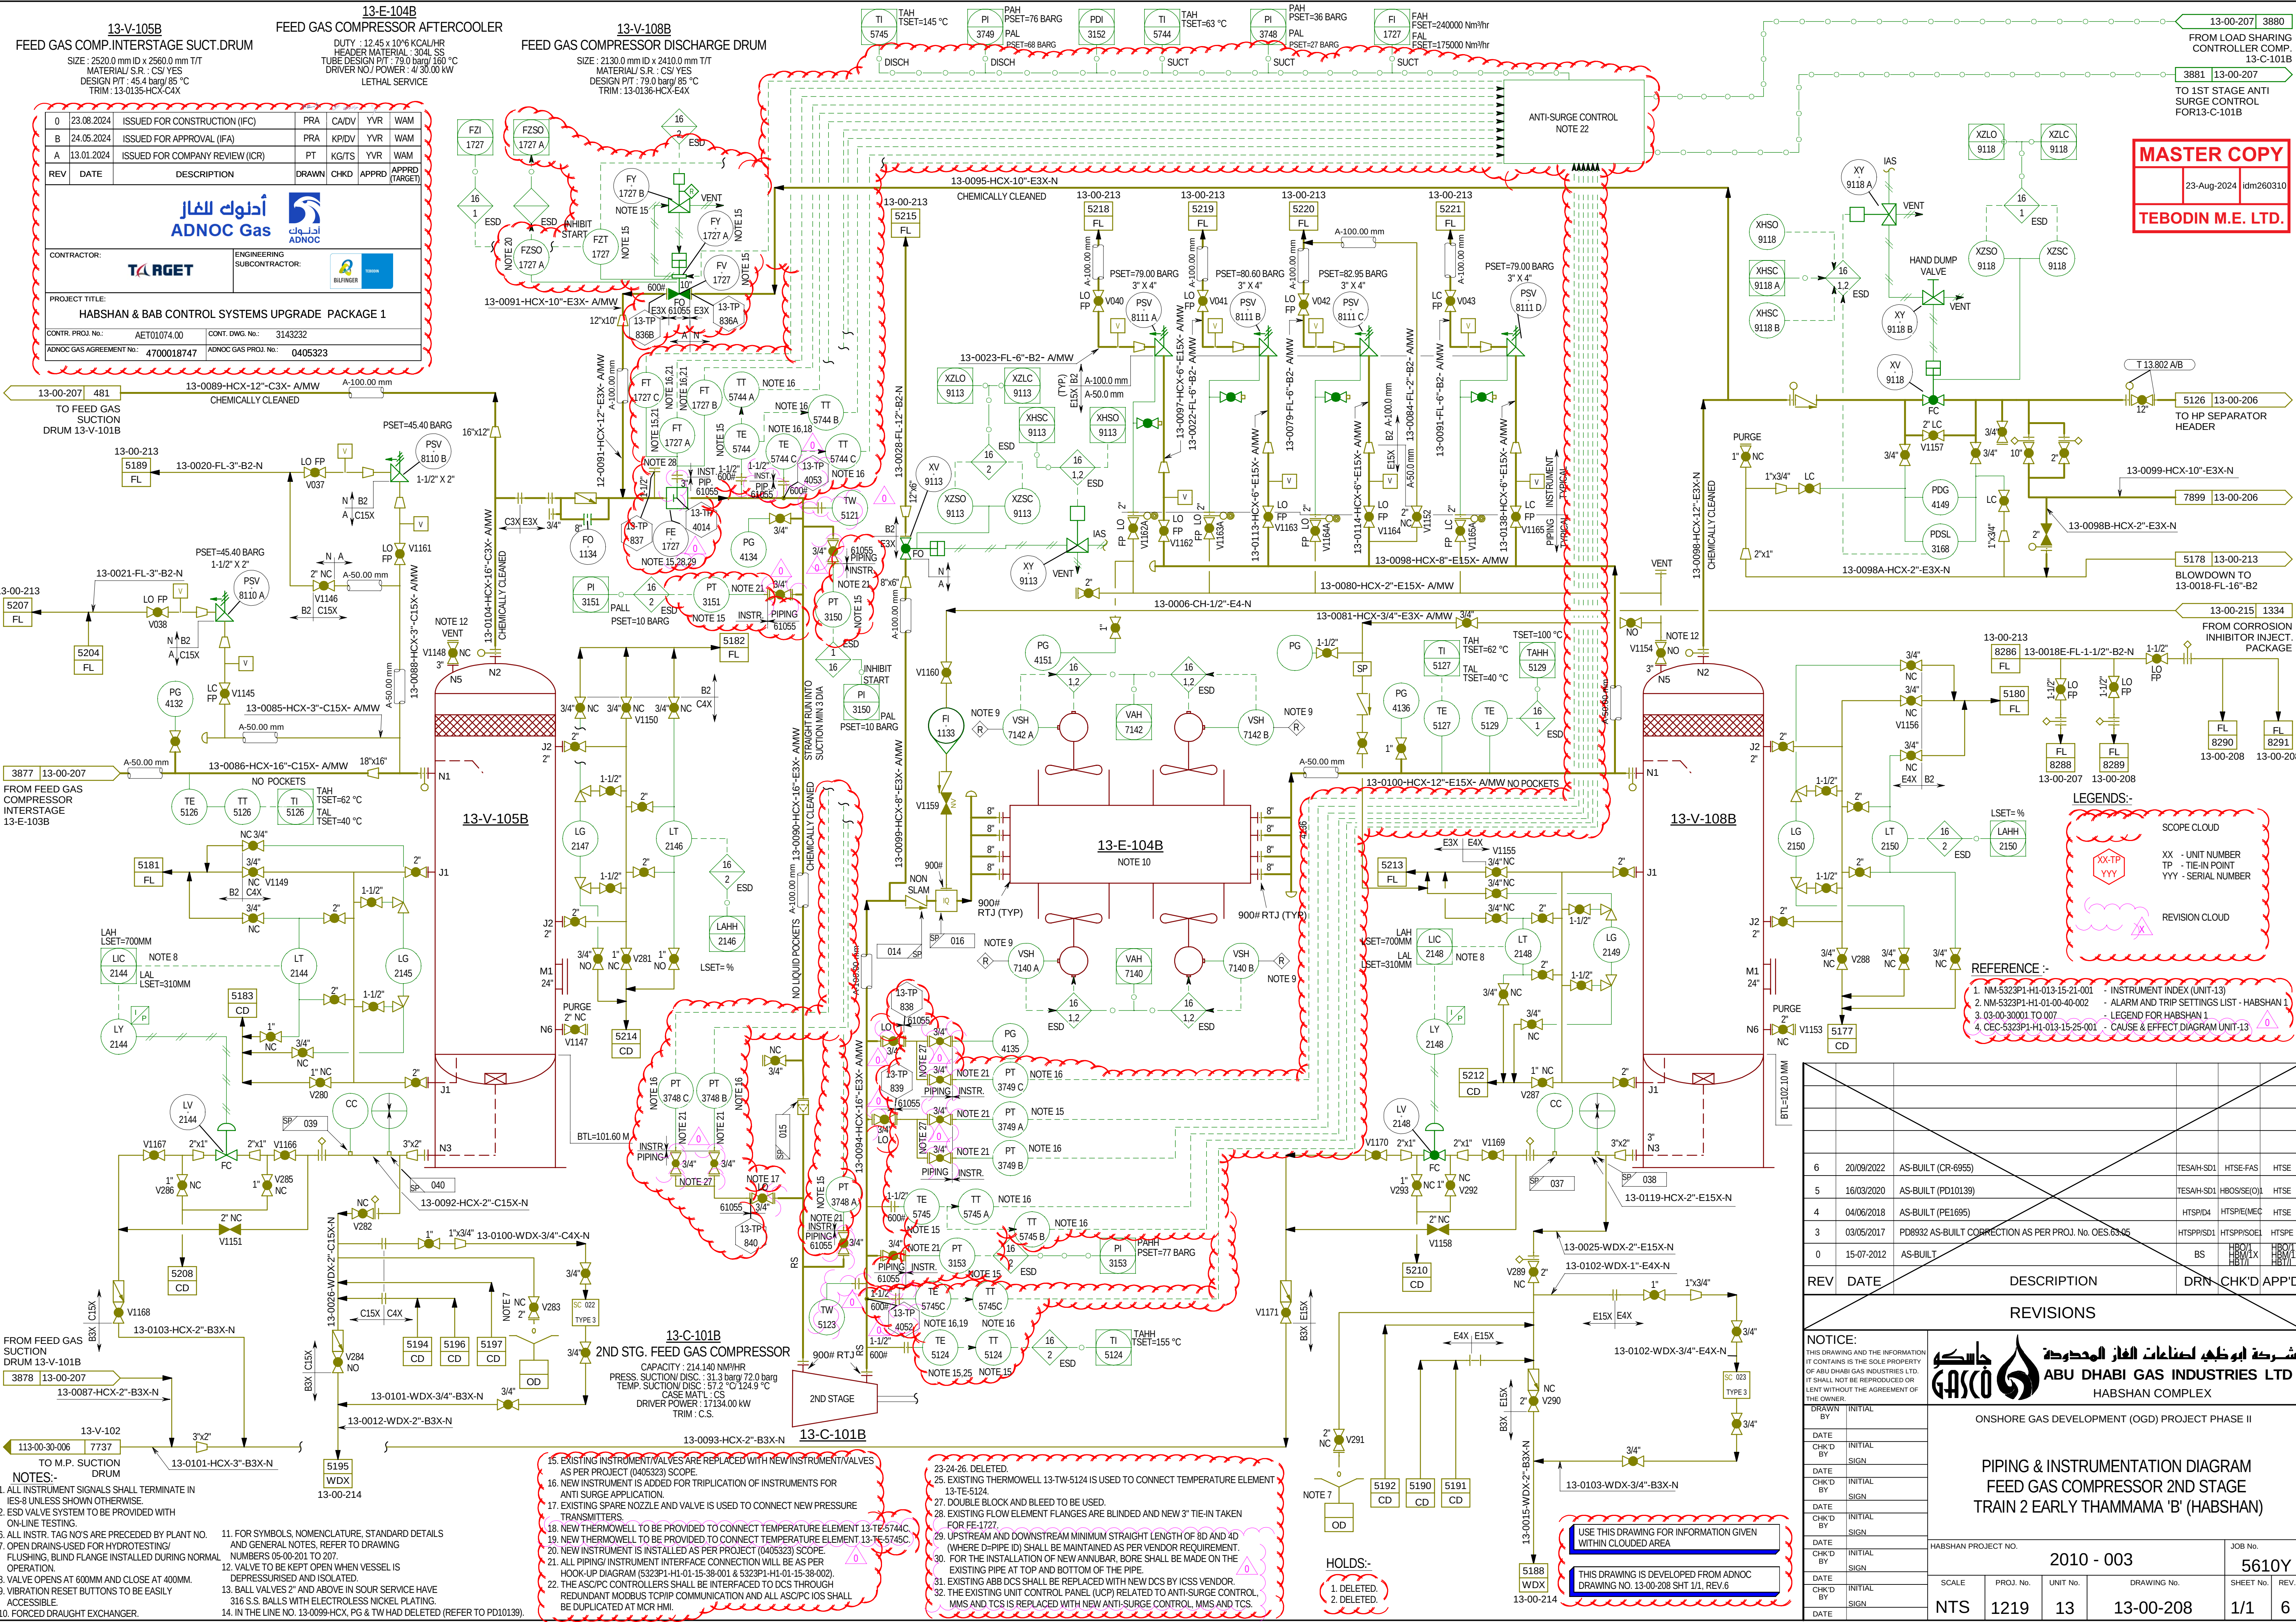

13-V-105B
FEED GAS COMP.INTERSTAGE SUCT.DRUM

SIZE : 2520.0 mm ID x 2560.0 mm T/T
MATERIAL S.P. : CS YES
DESIGN P.T. : 45.4 barg/85 °C
TRIM : 13-0135-HCX-C4X

13-E-104B
FEED GAS COMPRESSOR AFTERCOOLER

DUTY : 12.45 x 10⁶ Kcal/hr
HEADER MATERIAL : 304L SS
TUBE DESIGN P.T. : 79.0 barg/160 °C
DRIVER NO./POWER : 43.00 kW
LETHAL SERVICE

13-V-108B
FEED GAS COMPRESSOR DISCHARGE DRUM

SIZE : 2130.0 mm ID x 2410.0 mm T/T
MATERIAL S.P. : CS YES
DESIGN P.T. : 79.0 barg/85 °C
TRIM : 13-0136-HCX-E4X

023.08.2024
ISSUED FOR CONSTRUCTION (IFC)

024.05.2024
ISSUED FOR APPROVAL (IFA)

13.01.2024
ISSUED FOR COMPANY REVIEW (ICR)

REV

DATE

DESCRIPTION

DRAWN

CHKD

APPRD

APPRD (TARGET)

أدنوك للغاز
ADNOC Gas

أدنوك
ADNOC

CONTRACTOR:
TARGET

ENGINEERING
SUBCONTRACTOR:
BURNER

PROJECT TITLE:
HABSHAN & BAB CONTROL SYSTEMS UPGRADE PACKAGE 1

CONTR. PROJ. No.:
AET01074.00

CONT. DWS. No.:
3143232

ADNOC GAS AGREEMENT No.:
4700018747

ADNOC GAS PROJ. No.:
0405323

MASTER COPY

23-Aug-2024

idm260310

TEBODIN M.E. LTD.

- NOTES:-
1. ALL INSTRUMENT SIGNALS SHALL TERMINATE IN IES-8 UNLESS SHOWN OTHERWISE.
2. ESD VALVE SYSTEM TO BE PROVIDED WITH ON-LINE TESTING.
3. ALL INSTR. TAG NO'S ARE PRECEDED BY PLANT NO.
4. OPEN DRAINS-USED FOR HYDROTESTING/FLUSHING, BLIND FLANGE INSTALLED DURING NORMAL OPERATION.
5. VALVE OPENS AT 600MM AND CLOSE AT 400MM.
6. VIBRATION RESET BUTTONS TO BE EASILY ACCESSIBLE.
7. FORCED DRAUGHT EXCHANGER.
8. FOR SYMBOLS, NOMENCLATURE, STANDARD DETAILS AND GENERAL NOTES, REFER TO DRAWING NUMBERS 05-001 TO 207.
9. VALVE TO BE KEPT OPEN WHEN VESSEL IS DEPRESSURISED AND ISOLATED.
10. BALL VALVES 2" AND ABOVE IN SOUR SERVICE HAVE 316 S.S. BALLS WITH ELECTROLESS NICKEL PLATING.
11. IN THE LINE NO. 13-0099-HCX, PG & TW HAD DELETED (REFER TO PD10139).
12. EXISTING INSTRUMENTAL VALVES ARE REPLACED WITH NEW INSTRUMENT/VALVES AS PER PROJECT (0405323) SCOPE.
13. NEW INSTRUMENT IS ADDED FOR TRIPlication OF INSTRUMENTS FOR ANTI SURGE APPLICATION.
14. EXISTING SPARE NOZZLE AND VALVE IS USED TO CONNECT NEW PRESSURE TRANSMITTERS.
15. NEW THERMOWELL TO BE PROVIDED TO CONNECT TEMPERATURE ELEMENT 13-TE-5744C.
16. NEW THERMOWELL TO BE PROVIDED TO CONNECT TEMPERATURE ELEMENT 13-TE-5745C.
17. NEW INSTRUMENT IS INSTALLED AS PER PROJECT (0405323) SCOPE.
18. ALL PIPING/INSTRUMENT INTERFACE CONNECTION WILL BE AS PER HOOK-UP DIAGRAM (5323P1-H1-01-15-39-001 & 5323P1-H1-01-15-39-002).
19. THE ASCOP/CONTROL SYSTEMS SHALL BE INTERFACED TO DCS THROUGH REDUNDANT MODBUS TCP/IP COMMUNICATION AND ALL ASCOP I/Os SHALL BE DUPLICATED AT MCR HMI.
20. 23-24-26. DELETED.
21. EXISTING THERMOWELL 13-TW-5124 IS USED TO CONNECT TEMPERATURE ELEMENT 13-TE-5124.
22. DOUBLE BLOCK AND BLEED TO BE USED.
23. EXISTING FLOW ELEMENT FLANGES ARE BLINDED AND NEW 3" TIE-IN TAKEN FOR FE-1127.
24. UPSTREAM AND DOWNSTREAM MINIMUM STRAIGHT LENGTH OF 8D AND 4D (WHERE D=PIPE ID) SHALL BE MAINTAINED AS PER VENDOR REQUIREMENT.
25. FOR THE INSTALLATION OF NEW ANNUNCIATOR, BORE SHALL BE MADE ON THE EXISTING PIPE AT TOP AND BOTTOM OF THE PIPE.
26. EXISTING ABB DCS SHALL BE REPLACED WITH NEW DCS BY ICSS VENDOR.
27. THE EXISTING UNIT CONTROL PANEL (UCP) RELATED TO ANTI-SURGE CONTROL, MMS AND TCS IS REPLACED WITH NEW ANTI-SURGE CONTROL, MMS AND TCS.

- LEGENDS:-
- SCOPE CLOUD
- XX - UNIT NUMBER
- TP - TIE-IN POINT
- YYY - SERIAL NUMBER
- REVISION CLOUD
- REFERENCE :-
1. NM-5323P1-H1-01-15-21-001 - INSTRUMENT INDEX (UNIT-13)
2. NM-5323P1-H1-01-00-40-002 - ALARM AND TRIP SETTINGS LIST - HABSHAN 1
3. 03-00-30001 TO 007 - LEGEND FOR HABSHAN 1
4. CEC-5323P1-H1-01-15-25-001 - CAUSE & EFFECT DIAGRAM UNIT-13

6	20/09/2022	AS-BUILT (CR-6955)	TESAH-S01	HTSE-FAS	HTSE
5	16/03/2020	AS-BUILT (PD10139)	TESAH-S01	HBOG/SE(O)	HTSE
4	04/06/2018	AS-BUILT (PE1695)	HTSPD4	HTSP/EMEC	HTSE
3	03/05/2017	PD8932 AS-BUILT CORRECTION AS PER PROJ. No. OES-6345	HTSPSPD1	HTSPSP/SEL	HTSPSE
0	15-07-2012	AS-BUILT	BS	HBO/IX HBO/IX HBO/IX	HBO/IX HBO/IX HBO/IX
REV	DATE	DESCRIPTION	DRN	CHK'D	APP'D
REVISIONS					
NOTICE: THIS DRAWING AND THE INFORMATION IT CONTAINS IS THE SOLE PROPERTY OF ABU DHABI GAS INDUSTRIES LTD. IT SHALL NOT BE REPRODUCED OR LENT WITHOUT THE AGREEMENT OF THE OWNER.					
		شركة أبوظبي لصناعات الغاز المحدودة ABU DHABI GAS INDUSTRIES LTD HABSHAN COMPLEX			
DRAWN BY	INITIAL	ONSHORE GAS DEVELOPMENT (OGD) PROJECT PHASE II PIPING & INSTRUMENTATION DIAGRAM FEED GAS COMPRESSOR 2ND STAGE TRAIN 2 EARLY THAMMAMA 'B' (HABSHAN)			
DATE					
CHK'D BY	INITIAL				
	SIGN				
DATE					
CHK'D BY	INITIAL				
	SIGN				
DATE					
CHK'D BY	INITIAL				
	SIGN				
DATE		HABSHAN PROJECT NO.		JOB No.	
CHK'D BY	INITIAL	2010 - 003		5610Y	
	SIGN				
DATE		SCALE	PROJ. No.	UNIT No.	DRAWING No.
CHK'D BY	INITIAL	SHEET No.		REV.	
	SIGN	1/1		6	
DATE		NTS		1219	
		13		13-00-208	
		1/1		6	