


			ADNOC GAS HABSHAN & BAB CONTROL SYSTEMS UPGRADE (PACKAGE 1) PROJECT NO. 0405323						  				
			COMMENTS RESOLUTION SHEET										
Document Title:			PIPING & INSTRUMENTATION DIAGRAM 13-C-102 TURBINE DRIVE & AUXILIARIES EARLY THAMMAMA 'B' (HABSHAN)				AGP Response Code			Prepared By:	VK		
Document No:			13-00-209		Revision No:	B		1. Revise and Re-submit		3. Approved	Checked By:	DV	
AG Ref. No:			ADNOCGP-WTRAN-002750		Date:	11-Feb-2024		2. Approved with comments	✓	4. For Information only	Approved By:	YVR	
SN	Reference		COMPANY Comments	CONSULTANT Response	COMPANY Resolution								
	Page No.	Clause No.											
1	1	Process Comment	Note 14 shall keep in the appropriate place.	Noted and updated									
2	1	Process Comment	Existing instrument tag number / New instrument tag number / Valve tag number shall specify.	Noted. However, we have not incorporated this comment as per discussion during design review meeting.									
3	1	Process Comment	Please review the isolation valve / drain valve for the pressure instruments or confirm with the site photograph that no isolation valve is required.	Noted. We have already provided Isolation valve in Rev B P&ID.									
4	1	Process Comment	Why HOLD? This HOLD point is not justified.	Noted. Note 14 is updated and hold is deleted from P&ID.									
5	1	Process Comment	Why straight length requirement could not be specified for Orifice Flow Element? Why awaiting vendor info? BTME to clarify.	Noted and straight length is updated.									
6	1	Process Comment	1. Holds shall be removed before submitting the next revision of the documents. 2. Alarm & Trip list document number shall be provided under the reference list. 3. Please provide the Legend P&ID number under the reference list. 4. DCS symbol / Local / functional symbol shall be shown in the legend. 5. The Isolation philosophy/ Cause & Effect document number shall be provided under the reference list. 6. Previous comments not incorporated.	1. Noted and holds are removed from P&ID. 2. Noted, However alarm and trip list document number is provided in Rev B P&ID. 3. Noted and legend reference is updated under reference list. 4. Noted. Refer legend reference added in reference section for DCS symbol legend. 5. As discussed for other P&IDs Isolation philosophy is not required in reference list. Cause & Effect document number is not required as there is no signal in our scope going to ESD. 6. All previous comments incorporated in Rev B									
7	1	-	-	Following changes are made in P&ID w.r.t. Rev.B submission as per piping/instrumentation inputs. 1. Tie-in Point 13-TP-1583 & 1584 location and pipe class is updated as per piping input. 2. Note 17 added.									

- NOTES:
- CONNECTION FOR WASH WATER FROM TROLLEY SUPPLIED BY VENDOR NO PERMANENT CONNECTION REQUIRED. REFER TO VENDOR DRAWING 478-720. M.R.NO. 545-4-3002. V.P.NO.118.
 - PLUGGED/BLIND FLANGE CONNECTIONS NOT SHOWN.
 - DELETED.
 - VENT TO SAFE LOCATION.
 - FOR DETAILS OF LUBE OIL CONSOLE,REFER TO VENDOR DRAWING 317-200. M.R.NO. 545-4-3002. V.P.NO.118.
 - FOR DETAILS OF LUBE OIL CONSOLE.(GAS GENERATOR) REFER TO VENDOR DRAWING 317-210. M.R.NO. 545-4-3002. V.P.NO.124.
 - DELETED.
 - REFER TO VENDOR DWG.NO 478-447 SHEET 2 M.R.NO. 545-4-3002. V.P.NO.106.
 - Y-TYPE STRAINER SUPPLIED BY VENDOR.
 - FOR SYMBOLS,NOMENCLATURE,STANDARD DETAILS AND GENERAL NOTES REFER TO DRAWING NUMBERS 05-00-201 TO 207.
 - 11.6" NB FLAME ARRESTOR SUPPLIED BY VENDOR.
 - 12.DELLETED
 - NEW INSTRUMENTS ARE ADDED AS PER PROJECT (0405323) SCOPE TO MEASURE THE FUEL GAS SUPPLY FLOW TO GAS GENERATOR.
 - UPSTREAM & DOWNSTREAM DISTANCE OF 4D & 2D SHALL BE MAINTAINED AS PER FLOW ELEMENT VENDOR REQUIREMENT.
 - ALL PIPING (INSTRUMENT INTERFACE CONNECTION) WILL BE AS PER HOOK-UP DIAGRAM (5323P1-HI-01-15-38-001).
 - BREAK FLANGE IS ADDED AS PER SITE AS BUILT.
 - THE EXISTING DCS WILL BE REPLACED WITH A NEW DCS BY THE ICSS VENDOR AS PART OF THE HBCSU PROJECT.

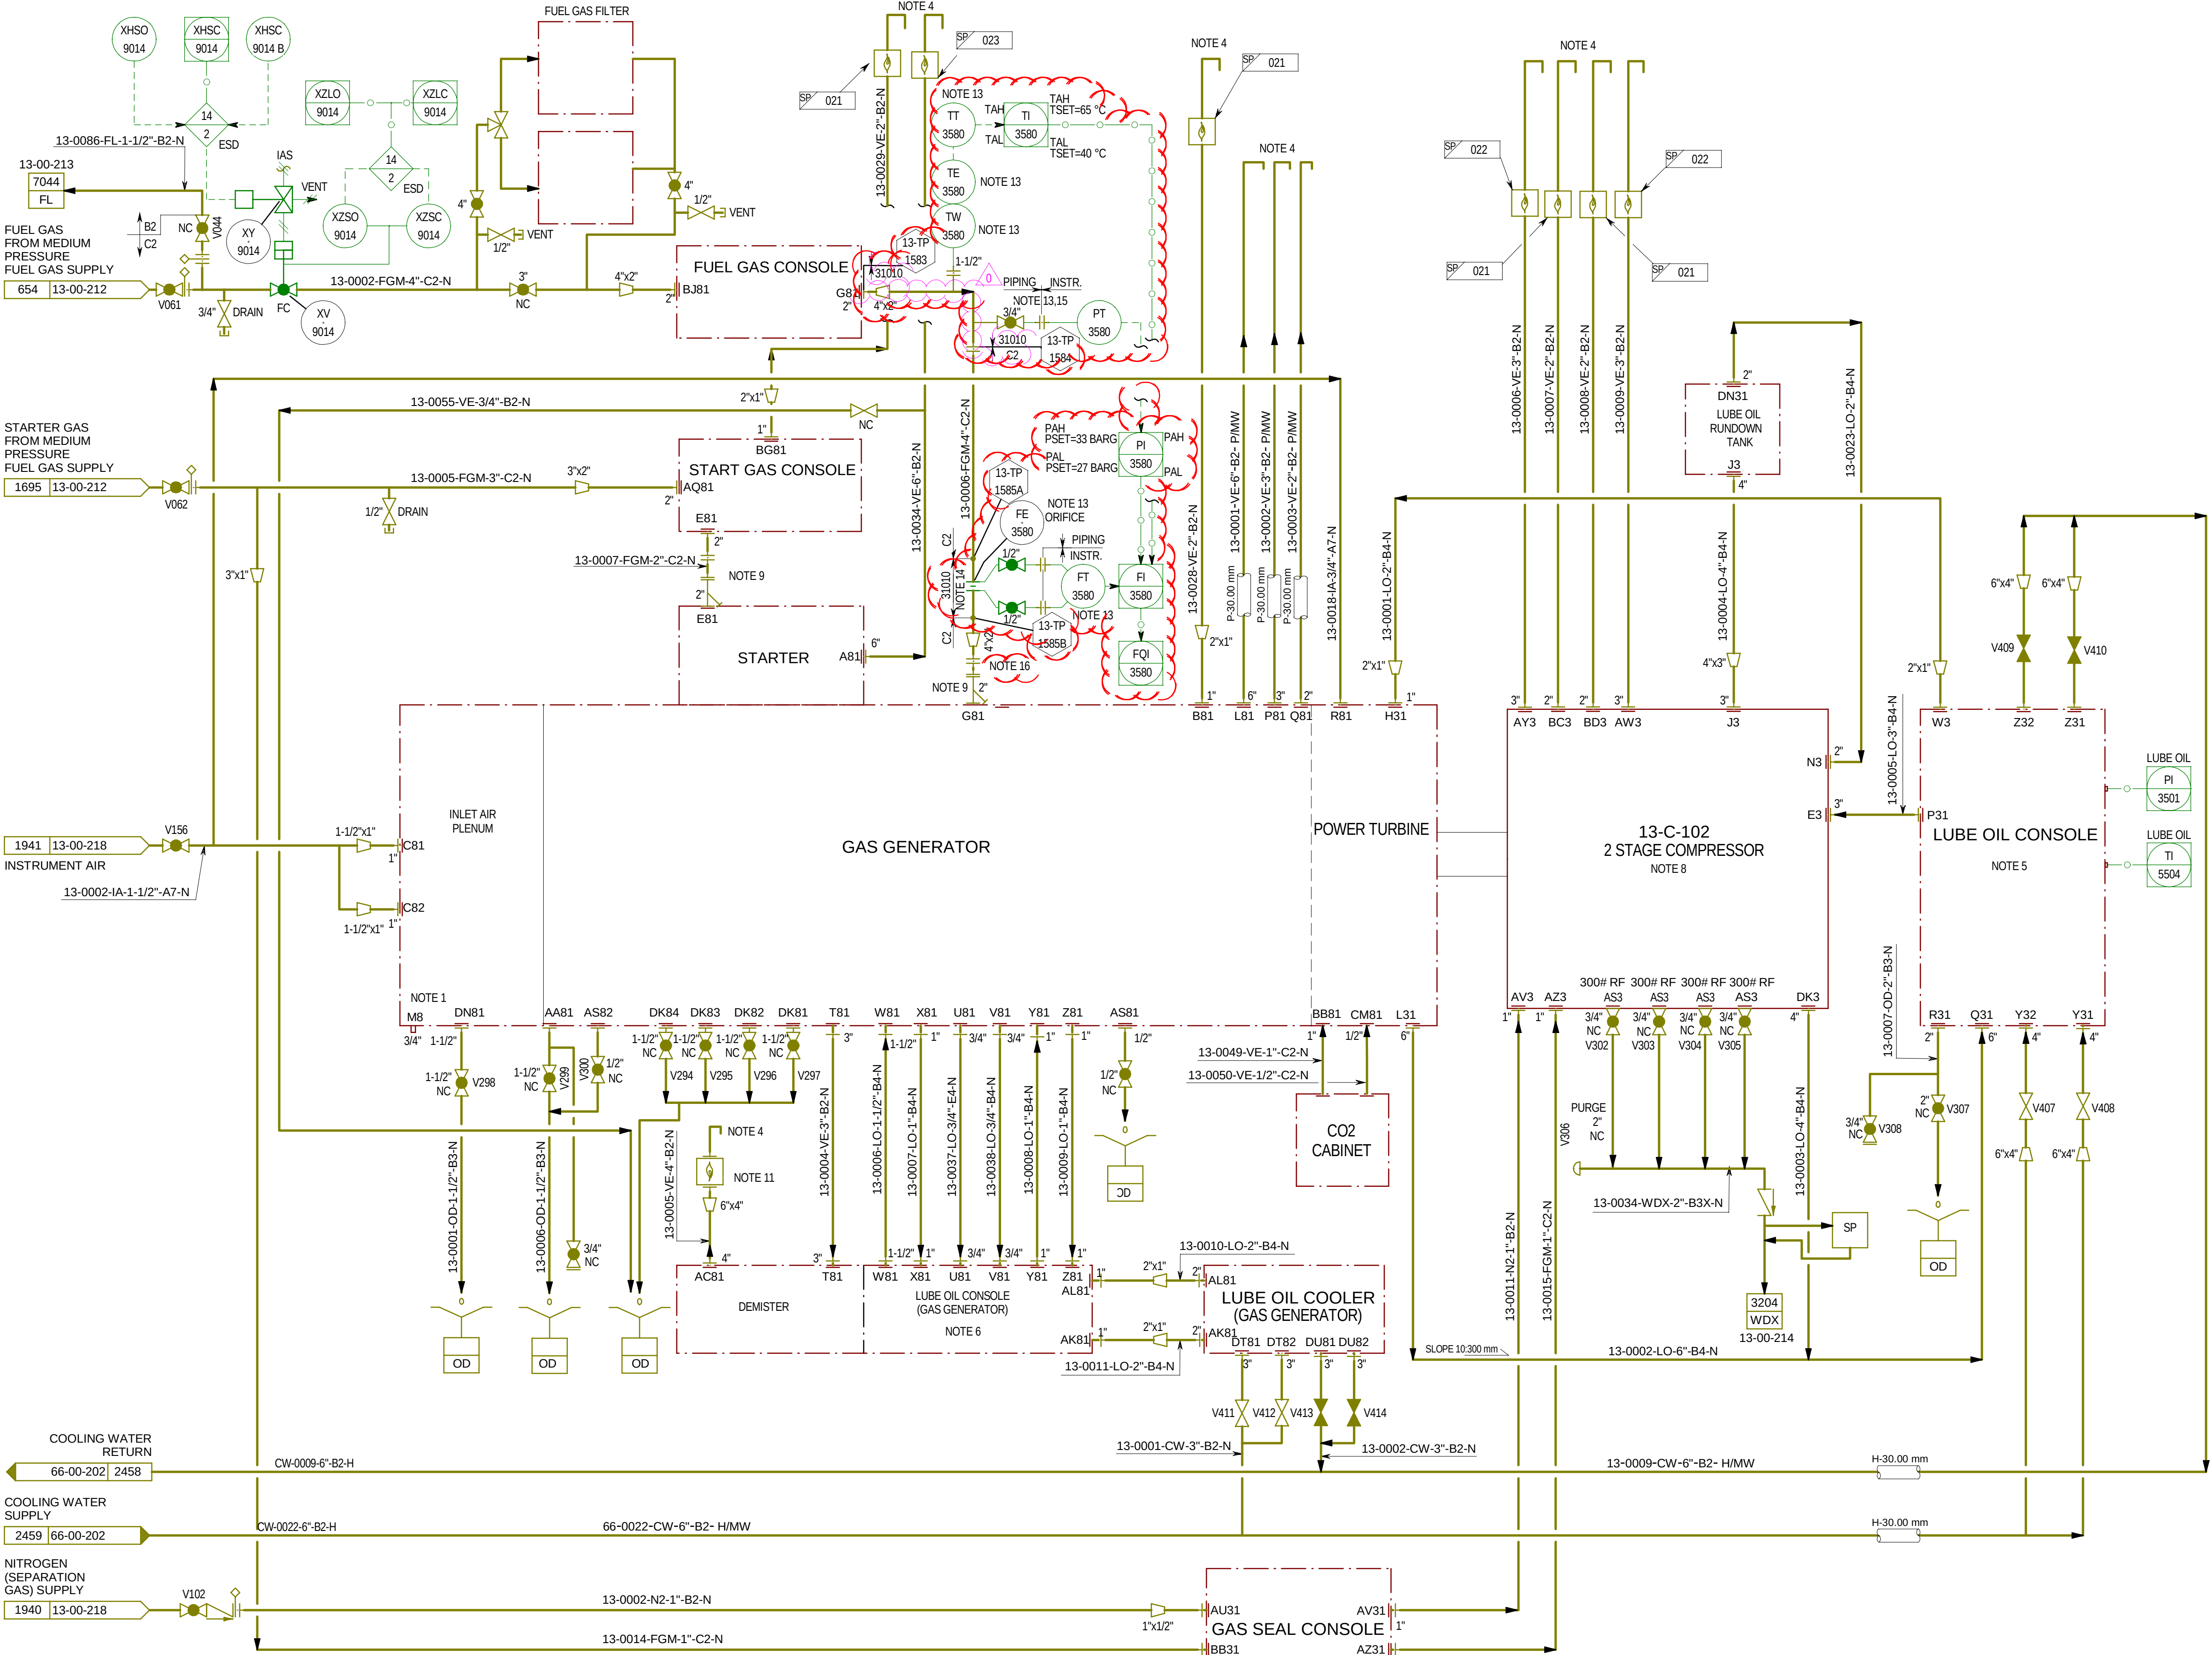

0	16.08.2024	ISSUED FOR CONSTRUCTION (IFC)	PRA	VK/DV	YVR	WAM
B	02.02.2024	ISSUED FOR APPROVAL (IFA)	PT	KG/DV	YVR	WAM
A	13.01.2024	ISSUED FOR COMPANY REVIEW (ICR)	PT	KG/TS	YVR	WAM
REV	DATE	DESCRIPTION	DRAWN	CHKD	APPRD	APPRD (TARGET)
أدنوك للغاز ADNOC Gas ادنيك ADNOC						
CONTRACTOR:			ENGINEERING SUBCONTRACTOR:			
PROJECT TITLE:			HABSHAN & BAB CONTROL SYSTEMS UPGRADE PACKAGE 1			
CONTR. PROJ. No.:			AET01074.00		CONT. DWG. No.: 3143243	
ADNOC GAS AGREEMENT No.:			4700018747		ADNOC GAS PROJ. No.: 0405323	

1	08/12/2014	REDRAWN IN SP P&ID & AS-BUILT AS PER PCR 06-2010	KS	VLN	PK
0	15-07-2012	AS-BUILT	NL	MM	HBO/1 HBM/1X HBT/1
REV	DATE	DESCRIPTION	DRN	CHK'D	APP'D
REVISIONS					

NOTICE:

THIS DRAWING AND THE INFORMATION IT CONTAINS IS THE SOLE PROPERTY OF ABU DHABI GAS INDUSTRIES LTD. IT SHALL NOT BE REPRODUCED OR LENT WITHOUT THE AGREEMENT OF THE OWNER.

شركة أبوظبي لصناعات الغاز المحدودة

ABU DHABI GAS INDUSTRIES LTD

HABSHAN COMPLEX

DRAWN BY

DATE

CHK'D BY

DATE

CHK'D BY

DATE

CHK'D BY

DATE

CHK'D BY

DATE

ONSHORE GAS DEVELOPMENT PROJECT

PIPING & INSTRUMENTATION DIAGRAM

13-C-102 TURBINE DRIVE & AUXILIARIES

EARLY THAMMAMA 'B' (HABSHAN)

HABSHAN PROJECT NO.

2010 - 003

JOB No.

22233

SCALE

PROJ. No.

UNIT No.

DRAWING No.

SHEET No.

REV.

NTS

545

13

13-00-209

1/1

1

HOLDS:-

- DELETED.
- DELETED.

- REFERENCE :-
- NM-5323P1-HI-01-15-21-001 - INSTRUMENT INDEX (UNIT-13)
 - NM-5323P1-HI-01-00-40-002 - ALARM AND TRIP SETTINGS LIST - HABSHAN 1
 - 03-00-30001 TO 007 - LEGEND FOR HABSHAN-1

LEGENDS:-

SCOPE CLOUD

XX-TP
YYY

XX - UNIT NUMBER
TP - TIE-IN POINT
YYY - SERIAL NUMBER

REVISION CLOUD

X

USE THIS DRAWING FOR INFORMATION GIVEN WITHIN CLOUDED AREA

THIS DRAWING IS DEVELOPED FROM ADNOC DRAWING NO. 13-00-209 SHT 1/1, REV.1