

			ADNOC GAS HABSHAN & BAB CONTROL SYSTEMS UPGRADE (PACKAGE 1) PROJECT NO. 0405323						  				
			COMMENTS RESOLUTION SHEET										
Document Title:			PIPING & INSTRUMENTATION DIAGRAM 13-C-101A TURBINE DRIVE & AUX. - TRAIN 2 EARLY THAMMAMA 'B' (HABSHAN)				AGP Response Code			Prepared By:	VK		
Document No:			13-00-210		Revision No:	B	1. Revise and Re-submit		3. Approved		Checked By:	DV	
AG Ref. No:			ADNOCGP-WTRAN-002750		Date:	11-Feb-2024	2. Approved with comments	✓	4. For Information only		Approved By:	YVR	
SN	Reference		COMPANY Comments				CONSULTANT Response			COMPANY Resolution			
	Page No.	Clause No.											
1	1	Process Comment	Why HOLD? This HOLD point is not justified.				Noted. Note 14 is updated and hold is deleted from P&ID.						
2	1	Process Comment	Why straight length requirement could not be specified for Orifice Flow Element? Why awaiting vendor info? BTME to clarify.				Noted and straight length is updated.						
3	1	Process Comment	Please refer to general comments provided in unit.no 013 (Doc.no. 13-00-209) - 5323P1-TL-1395.				Noted and all the relevant comments are updated in the P&ID.						
4	1	-	-				Following changes are made in P&ID w.r.t. Rev.B submission as per piping/instrumentation inputs. 1. Tie-in Point 13-TP-1536 & 1537 location is updated as per piping input. 2. Note 17 added.						


NOTES

1. CONNECTION FOR WASH WATER FROM TROLLEY SUPPLIED BY VENDOR, NO PERMANENT CONNECTION REQUIRED. REFER TO VENDOR DRAWING 478-720. M.R. NO. 545-4-3002.
2. PLUGGED/BLIND FLANGE CONNECTIONS NOT SHOWN
3. DELETED
4. VENT TO SAFE LOCATION.
5. FOR DETAILS OF LUBE OIL CONSOLE, REFER TO VENDOR DRAWING 317-200. M.R. NO.545-4-3002. V.P. NO.118
6. FOR DETAILS OF LUBE OIL CONSOLE (GAS GENERATOR), REFER TO VENDOR DRAWING 317-210. M.R. NO.545-4-3002. V.P. NO.124.
7. DELETED
8. REFER TO VENDOR DWG. NO 478-447 SHEET 2 M.R. NO.545-4-3002. V.P. NO.106.
9. Y-TYPE STRAINER SUPPLIED BY VENDOR
10. FOR SYMBOLS, NOMENCLATURE, STANDARD DETAILS AND GENERAL NOTES, REFER TO DRAWING NUMBERS 05-00-201 TO 207.
11. 6" NB FLAME ARRESTOR SUPPLIED BY VENDOR.
12. DELETED
13. NEW INSTRUMENTS ARE ADDED AS PER PROJECT (040523) SCOPE TO MEASURE THE FUEL GAS SUPPLY FLOW TO GAS GENERATOR.
14. UPSTREAM & DOWNSTREAM DISTANCE OF 4D & 2D SHALL BE MAINTAINED AS PER FLOW ELEMENT VENDOR REQUIREMENT.
15. ALL PIPING / INSTRUMENT INTERFACE CONNECTION WILL BE AS PER HOOK-UP DIAGRAM (5323P1-HI-01-15-38-001).
16. BREAK FLANGE IS ADDED AS PER SITE AS BUILT.
17. THE EXISTING DCS WILL BE REPLACED WITH A NEW DCS BY THE ICSS VENDOR AS PART OF THE HBCSU PROJECT.

0	16.08.2024	ISSUED FOR CONSTRUCTION (IFC)	PRA	VK/DV	YVR	WAM
B	02.02.2024	ISSUED FOR APPROVAL (IFA)	PT	KG/DV	YVR	WAM
A	13.01.2024	ISSUED FOR COMPANY REVIEW (ICR)	PT	KG/TS	YVR	WAM
REV	DATE	DESCRIPTION	DRAWN	CHKD	APPRD	APPRD TARGET
أدنوك للغاز ADNOC Gas CONTRACTOR: TARGET ENGINEERING SUBCONTRACTOR: BURNER PROJECT TITLE: HABSHAN & BAB CONTROL SYSTEMS UPGRADE PACKAGE 1 CONTR. PROJ. No.: AET01074.00 CONT. DWG. No.: 3143244 ADNOC GAS AGREEMENT No.: 4700018747 ADNOC GAS PROJ. No.: 0405323						

1	08/12/2014	REDRAWN IN SP P&ID & AS-BUILT AS PER PCR 06-2010	KS	VLN	PK
0	15-07-2012	AS-BUILT	NL	MM	MM
REV	DATE	DESCRIPTION	DRN	CHK'D	APP'D
REVISIONS					

NOTICE: THIS DRAWING AND THE INFORMATION IT CONTAINS IS THE SOLE PROPERTY OF ABU DHABI GAS INDUSTRIES LTD. IT SHALL NOT BE REPRODUCED OR LEFT WITHOUT THE AGREEMENT OF THE OWNER.					
شركة أبوظبي لصناعات الغاز المحدودة ABU DHABI GAS INDUSTRIES LTD HABSHAN COMPLEX ONSHORE GAS DEVELOPMENT PROJECT PIPING & INSTRUMENTATION DIAGRAM 13-C-101A TURBINE DRIVE & AUX. - TRAIN 2 EARLY THAMMAMA 'B' (HABSHAN)					
HABSHAN PROJECT NO. 2010 - 003			JOB No. 22233		
SCALE	PROJ. No.	UNIT No.	DRAWING No.	SHEET No.	REV.
NTS	545	13	13-00-210	1/1	1

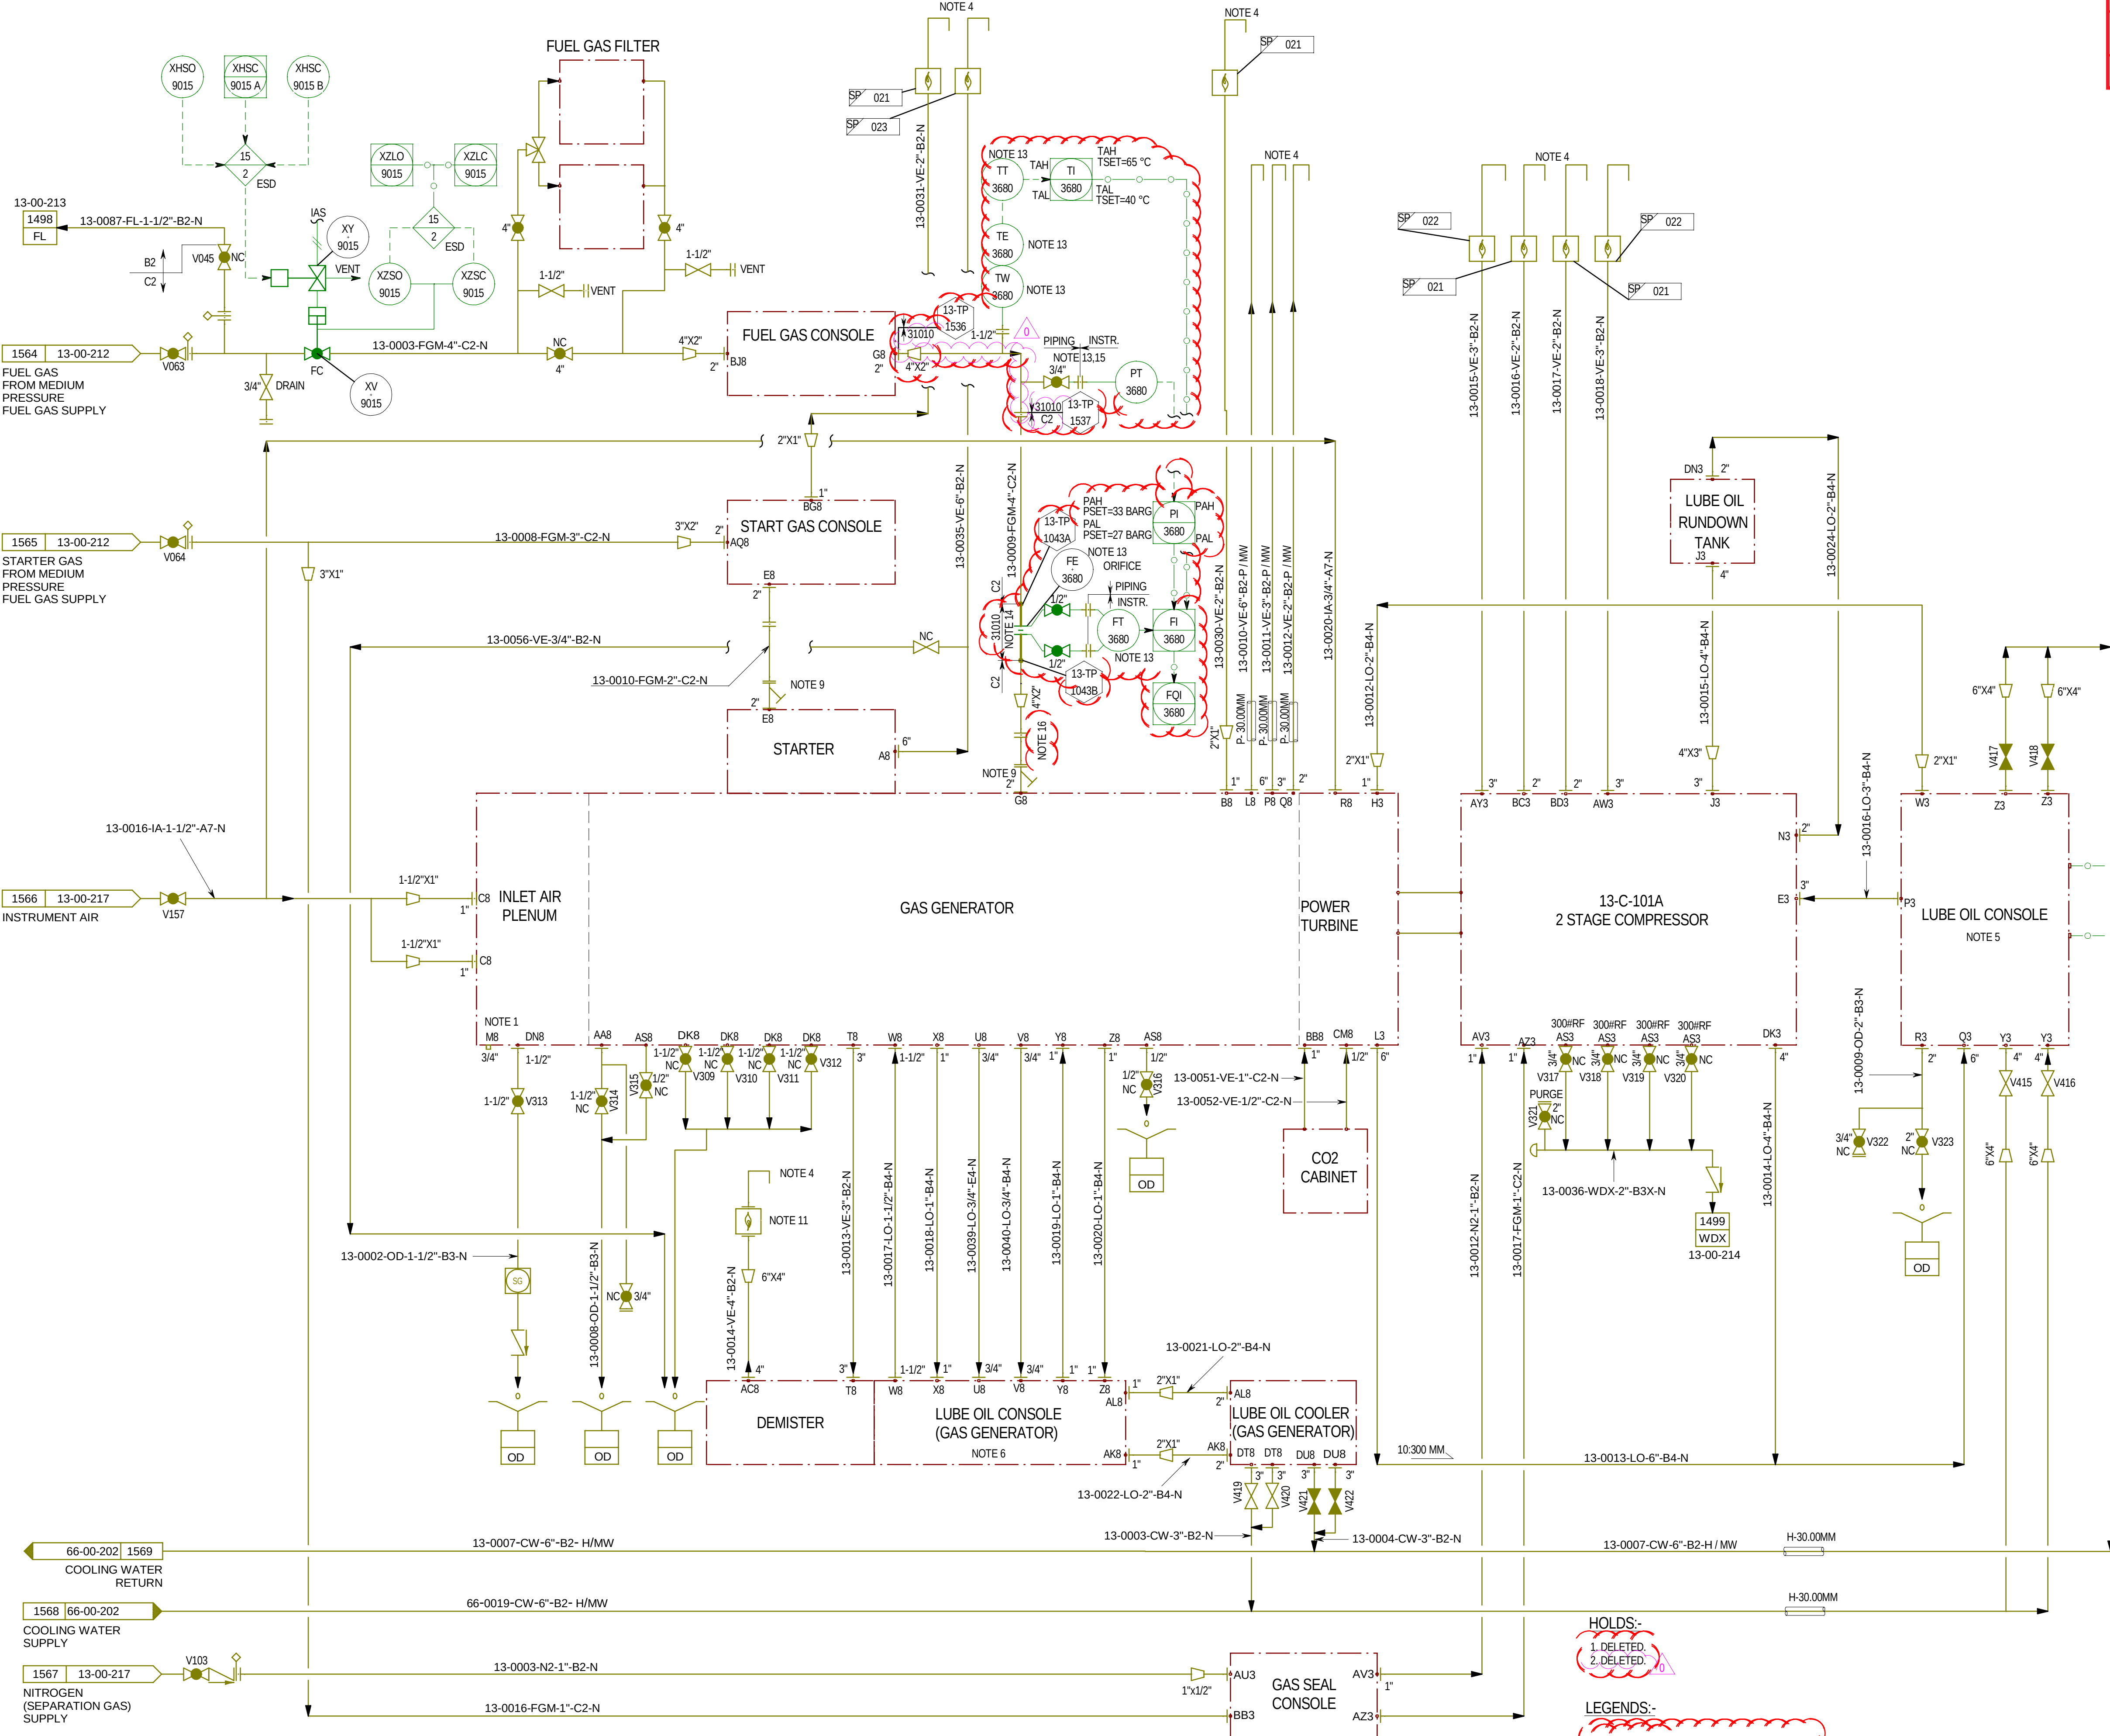

- REFERENCE:-
1. NM-5323P1-HI-013-15-21-001 - INSTRUMENT INDEX (UNIT-13)
 2. NM-5323P1-HI-01-00-40-002 - ALARM AND TRIP SETTINGS LIST - HABSHAN 1
 3. 03-00-30001 TO 007 - LEGEND FOR HABSHAN-1

HOLDS:-

1. DELETED
2. DELETED

- LEGENDS:-
- SCOPE CLOUD
 - XX-TP - UNIT NUMBER
 - TP - TIE-IN POINT
 - YYY - SERIAL NUMBER
 - REVISION CLOUD

USE THIS DRAWING FOR INFORMATION GIVEN WITHIN CLOUDED AREA

THIS DRAWING IS DEVELOPED FROM ADNOC DRAWING NO. 13-00-210 SHT 1/1, REV.1