

			ADNOC GAS HABSHAN & BAB CONTROL SYSTEMS UPGRADE (PACKAGE 1) PROJECT NO. 0405323						  				
			COMMENTS RESOLUTION SHEET										
Document Title:			PIPING & INSTRUMENTATION DIAGRAM 13-C-101B TURBINE DRIVE & AUX. - RAIN 2 EARLY THAMMAMA 'B' (HABSHAN)				AGP Response Code			Prepared By:	VK		
Document No:			13-00-211		Revision No:	B	1. Revise and Re-submit		3. Approved		Checked By:	DV	
AG Ref. No:			ADNOCGP-WTRAN-002750		Date:	29-Jul-2024	2. Approved with comments	✓	4. For Information only		Approved By:	YVR	
SN	Reference		COMPANY Comments	CONSULTANT Response	COMPANY Resolution								
	Page No.	Clause No.											
1	1	Process Comment	Why straight length requirement could not be specified for Orifice Flow Element? Why awaiting vendor info? BTME to clarify.	Noted and straight length is updated.									
2	1	Process Comment	Why HOLD? This HOLD point is not justified.	Noted. Note 14 is updated and hold is deleted from P&ID.									
3	1	Process Comment	Please refer to general comments provided in unit.no 013 (Doc.no. 13-00-209) - 5323P1-TL-1395	Noted and all the relevant comments are updated in the P&ID.									
4	1	-	-	Following changes are made in P&ID w.r.t. Rev.B submission as per piping/instrumentation inputs. 1. Tie-in Point 13-TP-1044 & 1045 location is updated as per piping input. 2. Flange rating for TW-3780 is updated as 600# as per piping Input. 3.Note 17 added.									

MASTER COPY

19-Aug-2024 IDM26031C

TEBODIN M.E. LTD.

NOTES


1. CONNECTION FOR WASH WATER FROM TROLLEY SUPPLIED BY VENDOR. NO PERMANENT CONNECTION REQUIRED. REFER TO VENDOR DRAWING 478-720. M.R. NO. 545-4-3002. V.P. NO.98.
2. PLUGGED/BLIND FLANGE CONNECTIONS NOT SHOWN. 3. DELETED.
4. VENT TO SAFE LOCATION.
5. FOR DETAILS OF LUBE OIL CONSOLE, REFER TO VENDOR DRAWING 317-200. M.R. NO.545-4-3002. V.P. NO.118.
6. FOR DETAILS OF LUBE OIL CONSOLE (GAS GENERATOR), REFER TO VENDOR DRAWING 317-210. M.R. NO.545-4-3002. V.P. NO.124.
7. DELETED.
8. REFER TO VENDOR DWG. NO 478-447 SHEET 2 M.R. NO.545-4-3002. V.P. NO.106.
9. Y-TYPE STRAINER SUPPLIED BY VENDOR.
10. FOR SYMBOLS, NOMENCLATURE, STANDARD DETAILS AND GENERAL NOTES, REFER TO DRAWING NUMBERS 05-00-201 TO 207.
11. 6" NB FLAME ARRESTOR SUPPLIED BY VENDOR.
12. DELETED.
13. NEW INSTRUMENTS ARE ADDED AS PER PROJECT (0405323) SCOPE TO MEASURE THE FUEL GAS SUPPLY FLOW TO GAS GENERATOR.
14. UPSTREAM & DOWNSTREAM DISTANCE OF 4D & 2D SHALL BE MAINTAINED AS PER FLOW ELEMENT VENDOR REQUIREMENT.
15. ALL PIPING/INSTRUMENT INTERFACE CONNECTION WILL BE AS PER HOOK-UP DIAGRAM (5323P1-HI-01-15-38-001).
16. BREAK FLANGE IS ADDED AS PER SITE AS BUILT.
17. THE EXISTING DCS WILL BE REPLACED WITH A NEW DCS BY THE ICSS VENDOR AS PART OF THE HBCSU PROJECT.

0	16.08.2024	ISSUED FOR CONSTRUCTION (IFC)	PRA	VK/DV	YVR	WAM
B	02.02.2024	ISSUED FOR APPROVAL (IFA)	PT	KG/DV	YVR	WAM
A	13.01.2024	ISSUED FOR COMPANY REVIEW (ICR)	PT	KG/TS	YVR	WAM
REV	DATE	DESCRIPTION	DRAWN	CHKD	APPRD	APPRD TARGET
أدنوك للغاز ADNOC Gas ADNOC						
CONTRACTOR:			ENGINEERING SUBCONTRACTOR:			
PROJECT TITLE:			HABSHAN & BAB CONTROL SYSTEMS UPGRADE PACKAGE 1			
CONTR. PROJ. No.:		AET01074.00	CONT. DWG. No.:		3143245	
ADNOC GAS AGREEMENT No.:		4700018747	ADNOC GAS PROJ. No.:		0405323	

REV	DATE	DESCRIPTION	DRN	CHK'D	APP'D
1	08/12/2014	REDRAWN IN SP P&ID & AS-BUILT AS PER PCR 06-2010	KS	VLN	PK
0	15-07-2012	AS-BUILT	NL	MMB	A/HB02 HBM1X HBT1

REVISIONS

NOTICE:		شركة أبوظبي لصناعات الغاز المحدودة	
THIS DRAWING AND THE INFORMATION IT CONTAINS IS THE SOLE PROPERTY OF ABU DHABI GAS INDUSTRIES LTD. IT SHALL NOT BE REPRODUCED OR LEFT WITHOUT THE AGREEMENT OF THE OWNER.		ABU DHABI GAS INDUSTRIES LTD	
HABSHAN PROJECT NO.		2010 - 003	
JOB No.		22233	
SCALE		PROJ. No.	UNIT No.
NTS		545	13
DRAWING No.		13-00-211	
SHEET No.		1/1	
REV		1	

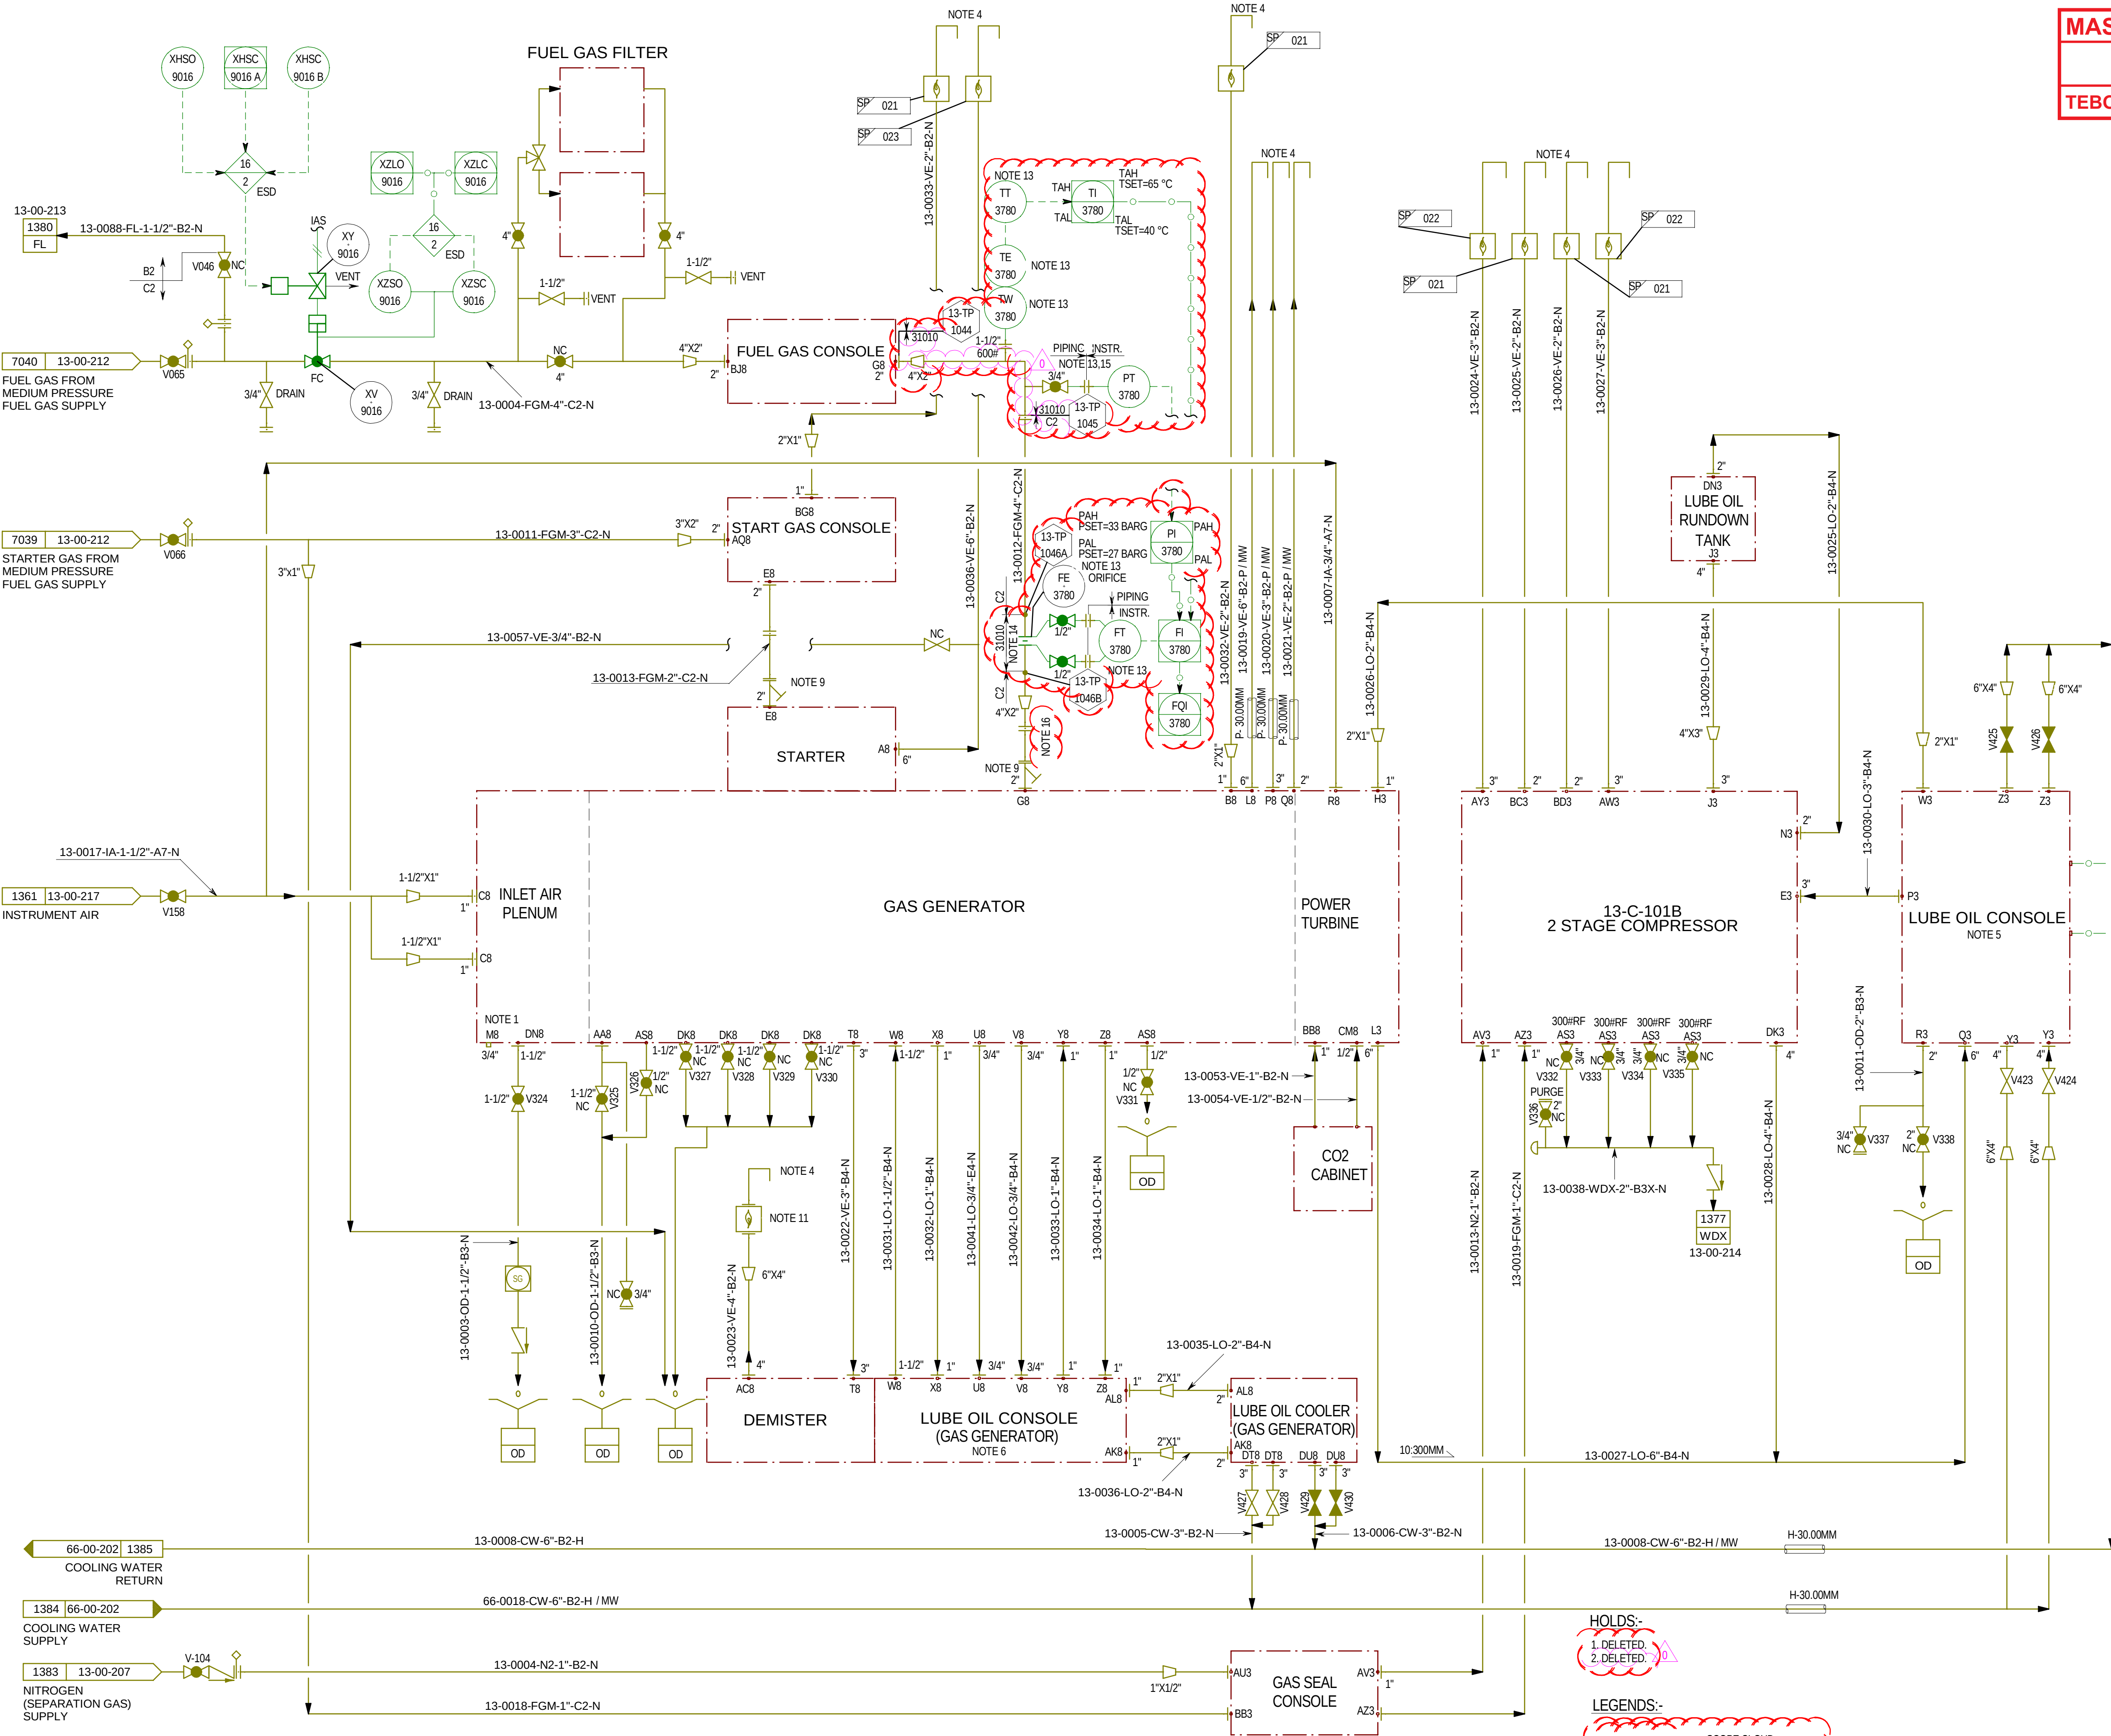

- REFERENCE:-
1. NM-5323P1-HI-013-15-21-001 - INSTRUMENT INDEX (UNIT-13)
 2. NM-5323P1-HI-01-00-40-002 - ALARM AND TRIP SETTINGS LIST - HABSHAN 1
 3. 03-00-30001 TO 007 - LEGEND FOR HABSHAN-1

- HOLDS:-
1. DELETED
 2. DELETED

- LEGENDS:-
- SCOPE CLOUD
 - XX-TP - UNIT NUMBER
 - YYY - SERIAL NUMBER
 - REVISION CLOUD

USE THIS DRAWING FOR INFORMATION GIVEN WITHIN CLOUDED AREA

THIS DRAWING IS DEVELOPED FROM ADNOC DRAWING NO. 13-00-211 SHT 1/1, REV.1