

			ADNOC GAS HABSHAN & BAB CONTROL SYSTEMS UPGRADE (PACKAGE 1) PROJECT NO. 0405323						  					
			COMMENTS RESOLUTION SHEET											
Document Title:			PIPING AND INSTRUMENTATION DIAGRAM COMPRESSOR LUBE OIL DIAGRAM FOR 13-C-101A/B			AGP Response Code			Prepared By:		VK			
Document No:			5323P1-H1-013-00-50-007		Revision No:	B		1. Revise and Re-submit	☐	3. Approved	☐	Checked By:	DV	
AG Ref. No:			ADNOCGP-WTRAN-007250		Date:	6-Jun-2024		2. Approved with comments	☒	4. For Information only	☐	Approved By:	YVR	
SN	Reference		COMPANY Comments				CONSULTANT Response				COMPANY Resolution			
	Page No.	Clause No.												
1	1	Process Comment	Please review there is a change between Rev.A and Rev.B Changes shall be mentioned in the CRS or notes (typical).				Noted, However all the pressure alarm values are updated based on value given in operating manual.							
2	1	-	-				Following changes are made in P&ID w.r.t. Rev.B submission as per piping/instrumentation inputs: 1. LT-2602 vent valve type and size updated based on piping input. 2. LT-2602 process connection size and rating updated based on piping input 3. LT-2601 Tie-in no are deleted from detail "A" as per piping input 4. TI-6006 connection is updated as flange connection as per piping input. 5. FG-1610 removed from project scope as per letter from company. 6. Root valves for all PT are shown in project scope cloud based on instrument input. 7. Note-19 added. 8. Table to mention instruments in project scope for 13-C-101A and 13-C-101B is added. Refer detail "B".							

NOTICE: THIS DRAWING AND THE INFORMATION IT CONTAINS IS THE SOLE PROPERTY OF ADNOC GAS PROCESSING
IT SHALL NOT BE REPRODUCED OR LENT WITHOUT THE AGREEMENT OF THE OWNER

MASTER COPY

12-Aug-2024 idm260310

TEBODIN M.E. LTD.


NOTES:-

- SEE DRAWING 478-373-601 FOR COMPONENT SYMBOLS AND LETTER DESIGNATIONS.
- SEE DRAWING 003-152-001 FOR PIPING LINE CODE EXPLANATION.
- SEE DETACHED LIST OF MATERIALS 317-201-201,202, OR 203 FOR COMPONENT DESCRIPTIONS.
- SEE DETACHED CUSTOMER CONNECTION LIST 478-145-601. FOR CUSTOMER CONNECTION DESCRIPTIONS.
- SEE DRAWING 478-121 FOR WIRING DETAILS.
- FLUSHING STRAINERS ARE TO BE REMOVED ONLY AFTER FLUSHING IS COMPLETE.
- ALL INSTRUMENT TAG NUMBERS SHOULD BE PREFIXED WITH THE AREA DESIGNATIONS-13".
- INSTRUMENT TAG NUMBERS SHOWN ARE FOR THE A-TRAIN. FOR B-TRAIN INSTRUMENT TAG NUMBERS ADD 100.
- EXISTING INSTRUMENT IS REPLACED WITH NEW INSTRUMENT AS PER PROJECT(0405323) SCOPE.
- FOR UNIT 13-C-101A CORRESPONDING EXISTING INSTRUMENT/VALVES ARE REPLACED WITH NEW INSTRUMENT/VALVES AS PER PROJECT(0405323) SCOPE.
- EXISTING SWITCH IS REPLACED WITH NEW TRANSMITTER AS PER PROJECT (0405323) SCOPE.
- FOR 13-C-101B, CORRESPONDING EXISTING INSTRUMENT/VALVES ARE REPLACED WITH NEW INSTRUMENT/VALVES AS PER PROJECT (0405323) SCOPE.
- FOR TRAIN-B, EXISTING INSTRUMENT 13-TI-6707 IS REPLACED WITH NEW INSTRUMENT AS PER PROJECT (0405323) SCOPE.
- ALL PIPING /INSTRUMENT INTERFACE CONNECTION WILL BE AS PER HOOK-UP DIAGRAM (5323P1-H1-01-15-38-001).
- VALVE SIZE IS UPDATED AS PER SITE AS-BUILT.
- EXISTING THERMOWELL TO BE RE-USED.
- THE TURBINE CONTROL SYSTEM (TCS) SHALL BE INTERFACED TO DCS THROUGH REDUNDANT MODBUS TCP/IP COMMUNICATION.
- THE EXISTING UNIT CONTROL PANEL (UCP) RELATED TO GE RX 3I AND WOODWARD IS REPLACED WITH NEW TURBINE CONTROL SYSTEM.
- REFER DETAIL "B" FOR LIST OF INSTRUMENTS/VALVES, WHICH ARE REPLACED OR ADDED AS PER PROJECT (0405323) SCOPE.

HOLDS:-

- DELETED.

LEGENDS:-

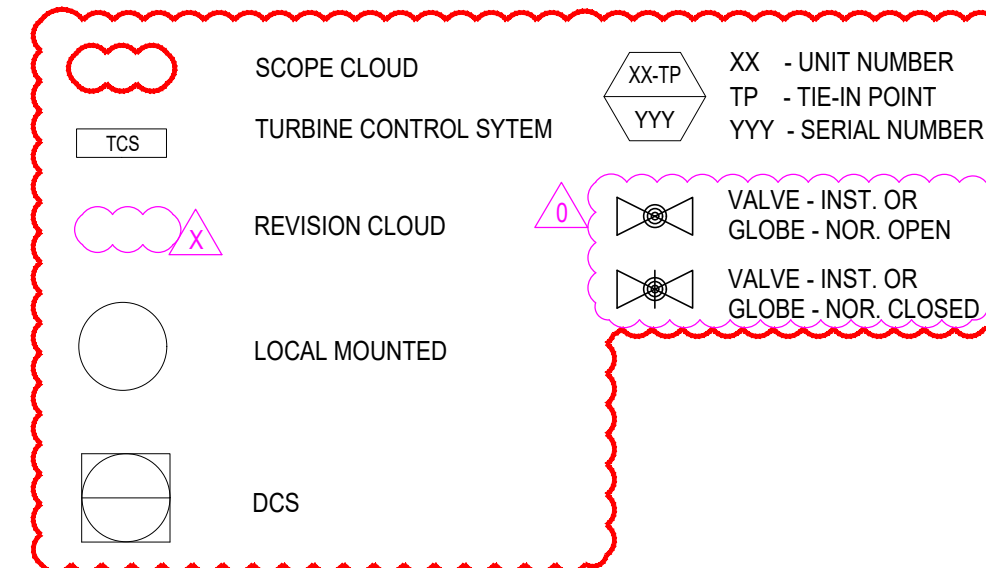

REFERENCE:-

- NM-5323P1-H1-013-15-21-001 - INSTRUMENT INDEX - UNIT 13
- 03-00-30001 TO 007 - LEGEND FOR HABSHAN-1
- NM-5323P1-H1-01-00-40-002 - ALARM AND TRIP SETTINGS LIST - HABSHAN 1

USE THIS DRAWING FOR INFORMATION GIVEN WITHIN CLOUDED AREA

THIS DRAWING IS DEVELOPED FROM ADNOC DRAWING NO. 317-201 SHT 1/1 REV 03 (PACKAGE / VENDOR DRAWING)


REV	DATE	DESCRIPTION	DRAWN	CHKD	APPRD	APPRD (TARGET)
0	09.08.2024	ISSUED FOR CONSTRUCTION (IFC)	PRA	VK/DV	YVR	WAM
B	27.05.2024	ISSUED FOR APPROVAL (IFA)	PRA	VK/DV	YVR	WAM
A	13.01.2024	ISSUED FOR COMPANY REVIEW (ICR)	PT	KG/TS	YVR	WAM

CONTRACTOR:	ADNOC Gas	ENGINEERING SUBCONTRACTOR:	BILFINGER
-------------	-----------	----------------------------	-----------

PROJECT TITLE: HABSHAN & BAB CONTROL SYSTEMS UPGRADE PACKAGE 1

DRAWING TITLE:		PIPING AND INSTRUMENTATION DIAGRAM COMPRESSOR LUBE OIL DIAGRAM FOR 13-C-101A/B	
UNIT:	13	PLANT:	HABSHAN-1
CONTR. PROJ. No.:	AET01074.00	CONT. DWG. No.:	3143227
ADNOC GAS AGREEMENT No.:	4700018747		
ADNOC GAS PROJ. No.:	0405323	ADNOC GAS DWG. No.:	5323P1-H1-013-00-50-007
		SHEET No.:	01/01
		REV:	0

SHEET SIZE : A1

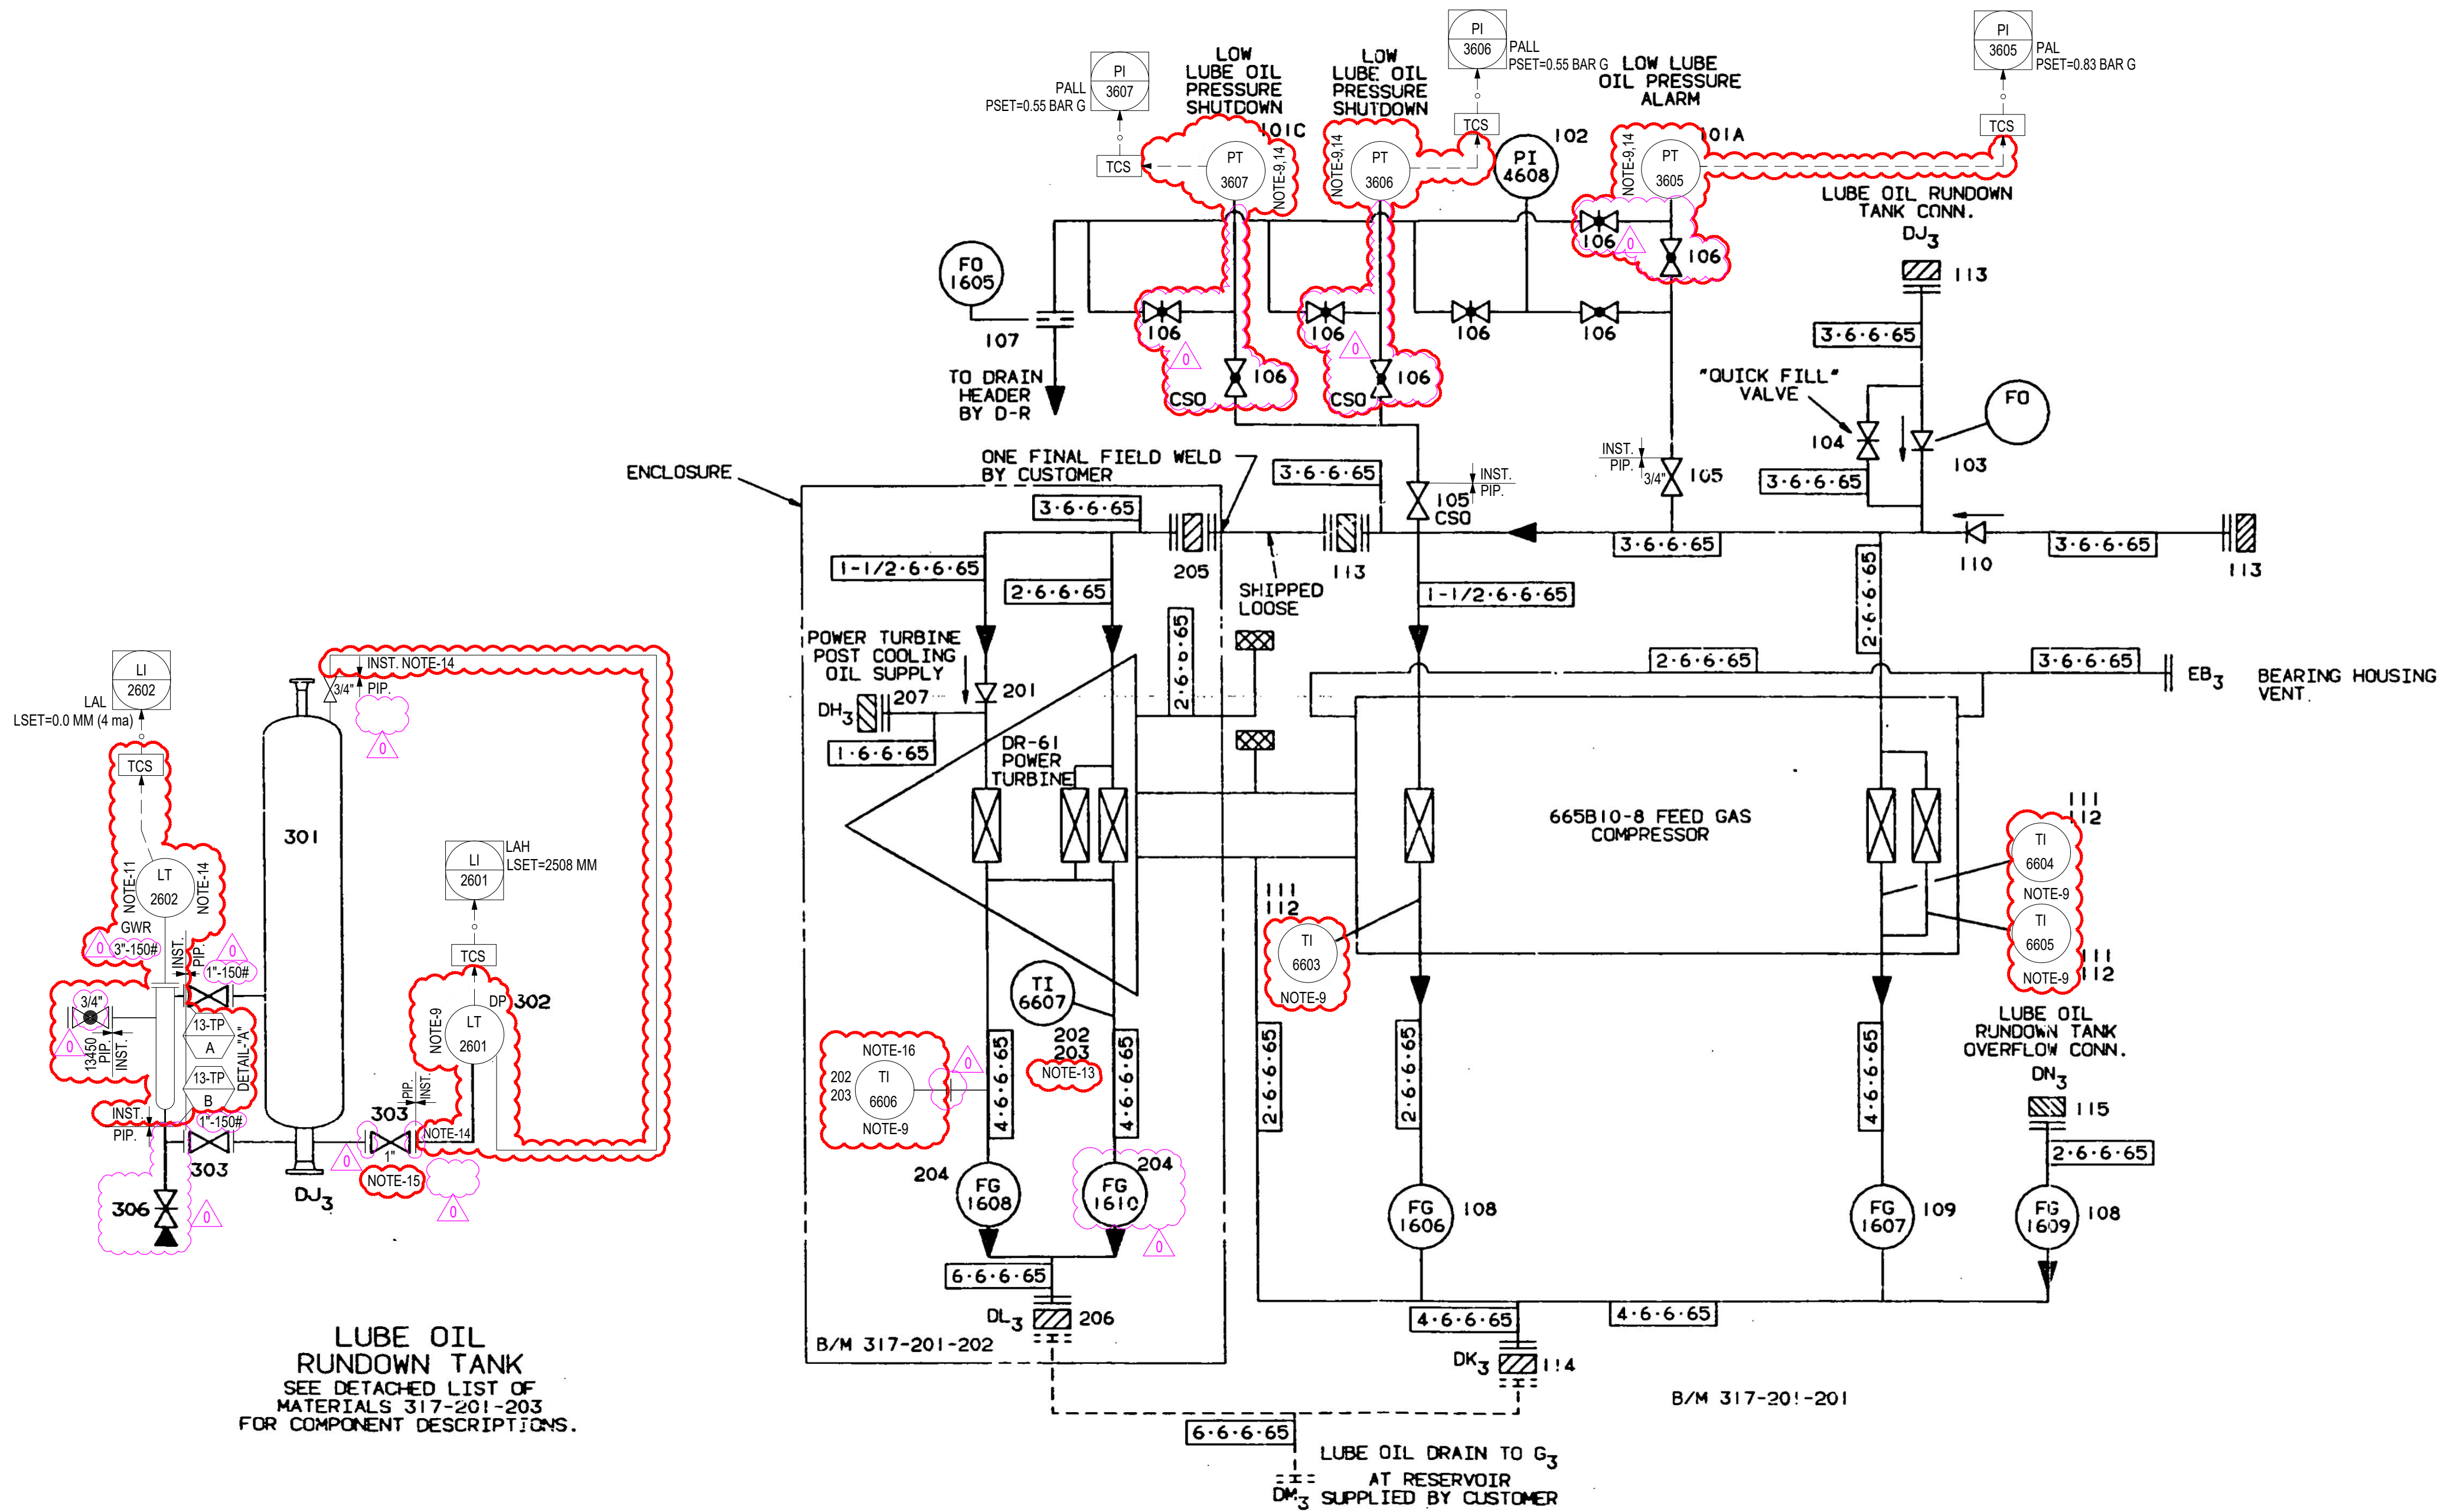

LUBE OIL RUNDOWN TANK
SEE DETACHED LIST OF MATERIALS 317-201-203
FOR COMPONENT DESCRIPTIONS.

LT?

NOTE-19 DETAIL-"B"	
13-C-101A	13-C-101B
13-L-2602	13-L-2702
13-LT-2601	13-LT-2701
13-FG-1610	-
13-PT-3605	13-PT-3705
13-PT-3606	13-PT-3706
13-PT-3607	13-PT-3707
13-TI-6603	13-TI-6703
13-TI-6604	13-TI-6704
13-TI-6605	13-TI-6705
13-TI-6606	13-TI-6706
-	13-TI-6707

DETAIL-"A"		
PACKAGE	INSTRUMENT TAG	TIE-IN NO.
13-C-101A	13-LT-2602	13-TP-814 A/B
13-C-101B	13-LT-2702	13-TP-4021 A/B

CONTRACT NO. 21712C/D	BY	DATE	FEED GAS COMPRESSOR
TYPE INST. DRAWN KMY	04/13/92	LUBE OIL DIAGRAM	
SCALE NONE CHECKED JMJ	04/17/92	DRESSER-RAND	
DEPT. 63.81 REDRAW		TURBO PRODUCTS DIVISION	
DRAFTING APPROVAL	DJL	04/17/92	CLEAN, N.Y. USA
CONTRACT APPROVAL	JAB	04/17/92	
SYSTEM APPROVAL	JMJ	04/17/92	
ADNOC GAS AGREEMENT No.:	4700018747	SHT. 1	REV. 03
317-201			