

			ADNOC GAS HABSHAN & BAB CONTROL SYSTEMS UPGRADE (PACKAGE 1) PROJECT NO. 0405323						  			
			COMMENTS RESOLUTION SHEET									
Document Title:			PIPING AND INSTRUMENTATION DIAGRAM AIR FLOW DIAGRAM FOR 13-C-101A/B/102				AGP Response Code			Prepared By:	VK	
Document No:			5323P1-H1-013-00-50-016		Revision No:	B	1. Revise and Re-submit	3. Approved	✓	Checked By:	DV	
AG Ref. No:			ADNOCGP-WTRAN-007148		Date:	3-Jun-2024	2. Approved with comments	4. For Information only		Approved By:	YVR	
SN	Reference		COMPANY Comments				CONSULTANT Response			COMPANY Resolution		
	Page No.	Clause No.										
1	-	-	No Comments.				-					
							Following changes are made in P&ID w.r.t. Rev.B submission as per piping/instrumentation inputs: 1. Instrument manifold valves for all PT & DPT are shown in project scope cloud based on instrument input. 2.PCV-3529 Tie-in location updated based on piping input.No piping Tie-in required on inlet line of PCV-3529, hence Tie-in number 13-TP-4037 A/B is updated as 13-TP-4037. 3. PCV-3529 rating is deleted as per piping input. 4. Note 20 is added 5. Table to mention instruments in project scope for13-C-102, 13-C-101A and 13-C-101B is added. Refer detail "B".					

NOTICE: THIS DRAWING AND THE INFORMATION IT CONTAINS IS THE SOLE PROPERTY OF ADNOC GAS PROCESSING. IT SHALL NOT BE REPRODUCED OR LENT WITHOUT THE AGREEMENT OF THE OWNER

MASTER COPY

15-Aug-2024 IDM26031C

TEBODIN M.E. LTD.

NOTES:-

- FOR COMPONENT DESCRIPTION SEE BILLS OF MATERIAL # 317-212-201, 317-212-202 AND 317-212-203.
- FOR CUSTOMER CONNECTION LETTER DESCRIPTION SEE: 478-139-601.
- FOR PIPING LINE CODE EXPLANATION SEE DRAWING 003-152-001.
- FOR COMPONENT SYMBOLS AND LETTER DESIGNATIONS SEE DRAWING 478-373-601.
- WARNING-HIGH TEMPERATURE GAS MAY BE VENTED IF VENT OR DRAIN VALVES ARE OPENED WHILE UNIT IS RUNNING.
- TUBING MUST BE CONTINUOUSLY SLOPED TO ENGINE CONNECTION.
- REFERENCE DRAWING
GAS TURBINE WIRING DIAGRAM # 478-130
UTILITY LIST #478-554
INSTRUMENT INDEX - CT 21712B #003-175-151
CT 21712C/D #003-175-152
LOCAL PANEL GENERAL ARRGT.-LP1 #478-450-601
LOCAL PANEL WIRING DIAGRAM.-LP1 #478-131
TURBINE SKID PS & GP GENERAL ARRANGEMENT LP2 #478-127
TURBINE SKID PS & GP WIRING DIAGRAM-LP2 #478-132
OUTLINE AND FOUNDATION DRAWING, CT 21712B #478-144
CT 21712C/D #478-241
- SEE GENERAL ELECTRIC DRAWING #L31705 FOR DESCRIPTION OF CONNECTIONS ON GAS GENERATOR.
- FOLLOWING WATER WASH, PLENUM DRAIN VALVE AND EXHAUST CASING DRAIN VALVE MUST BE OPENED AND ALL ACCUMULATED LIQUID DRAINED FROM THE LINE. THE EXHAUST CASING DRAIN VALVE MUST ALSO BE OPEN FOLLOWING SHUTDOWNS IN WHICH PRECIPITATION OCCURED. ALL DRAIN VALVES MUST BE CLOSED PRIOR TO RE-STARTING THE ENGINE.
- PIPING PER D-R SPEC. 003-230-001 AND DEVADED 003-230-017
- PIPE RUNS CARRYING HOT AIR SHALL BE INSULATED AND / OR SUITABLY RUN SO AS TO PREVENT PERSONNEL FROM CONTACTING HOT PIPE SURFACES.
- TUBING RUN FROM A23 CONNECTION ON GAS GENERATOR TO PT163 SHALL CONSIST OF 1/2" STAINLESS STEEL TUBING AND SHALL NOT EXCEED 10 FEET IN LENGTH.
- FOR ADNOC MP BOOSTER PACKAGE CT 21712B INSTRUMENT TAG NUMBERS WILL BE IN THE FIVE (5) HUNDRED SERIES PREFACED BY AREA LOCATION NUMBER (13). E.G 13-PT-3523.
FOR ADNOC FEED GAS PACKAGE 'A' CT 217.2C. INSTRUMENT TAG NUMBERS WILL BE IN THE SIX (6) HUNDRED SERIES PREFACED BY AREA LOCATION NUMBER (13). E.G 13-PT-3723.
FOR ADNOC FEED GAS PACKAGE 'B' CT 21712D. INSTRUMENT TAG NUMBERS WILL BE IN THE SEVEN (7) HUNDRED SERIES PREFACED BY AREA LOCATION NUMBER (13). E.G 13-PT-3723.
- EXISTING INSTRUMENT/VALVES ARE REPLACED WITH NEW INSTRUMENT/VALVES AS PER PROJECT (0405323) SCOPE.
- NEW INSTRUMENT/VALVES ARE INSTALLED AS PER PROJECT (0405323) SCOPE.
- ALL PIPING /INSTRUMENT INTERFACE CONNECTION WILL BE AS PER HOOK-UP DIAGRAM (5323P1-H1-01-15-38-001 & 5323P1-H1-01-15-38-002).
- INSTRUMENTS APPLICABLE FOR AIR FLOW FOR 13-C-101A AS PER PROJECT (0405323) SCOPE SHALL BE APPLICABLE FOR 13-C-101B & 13-C-102 ALSO.
- THE TURBINE CONTROL SYSTEM (TCS) SHALL BE INTERFACED TO DCS THROUGH REDUNDANT MODBUS TCP/IP COMMUNICATION.
- THE EXISTING UNIT CONTROL PANEL (UCP) RELATED TO GE RX 3I AND WOODWARD IS REPLACED WITH NEW TURBINE CONTROL SYSTEM.
- REFER DETAIL "B" FOR LIST OF INSTRUMENTS/VALVES, WHICH ARE REPLACED OR ADDED AS PER PROJECT (0405323) SCOPE.

LEGENDS:-

	SCOPE CLOUD		LOCAL MOUNTED
	PANEL MOUNTED		DCS
	TURBINE CONTROL SYTEM INSTRUMENT (WIRED TO TCS)		XX - UNIT NUMBER TP - TIE-IN POINT
	REVISION CLOUD		YYY - SERIAL NUMBER
	VALVE - INST. OR GLOBE - NOR. OPEN		VALVE - INST. OR GLOBE - NOR. CLOSED

REFERENCE:-

- NM-5323P1-H1-013-15-21-001 - INSTRUMENT INDEX - UNIT 13
- 03-00-30001 TO 007 - LEGEND FOR HABSHAN-1
- NM-5323P1-H1-01-00-40-002 - ALARM AND TRIP SETTINGS LIST - HABSHAN 1

USE THIS DRAWING FOR INFORMATION GIVEN WITHIN CLOUDED AREA


THIS DRAWING IS DEVELOPED FROM ADNOC DRAWING NO. 317-212 SHT 1/1 REV 04 (PACKAGE / VENDOR DRAWING)

REV	DATE	DESCRIPTION	DRAWN	CHKD	APPRD	APPRD (TARGET)
0	14.08.2024	ISSUED FOR CONSTRUCTION (IFC)	PRA	VK/DV	WAM	WAM
B	27.05.2024	ISSUED FOR APPROVAL (IFA)	PRA	KG/DV	YVR	WAM
A	13.01.2024	ISSUED FOR COMPANY REVIEW (ICR)	PT	KG/TS	YVR	WAM

SCALE: NTS
DRAWN: PRA
CHKD: VK/DV
APPRD: YVR
APPRD (TARGET): WAM

CONTRACTOR:		ENGINEERING SUBCONTRACTOR:	
TARGET		BILFINGER	

PROJECT TITLE:			
HABSHAN & BAB CONTROL SYSTEMS UPGRADE PACKAGE 1			
DRAWING TITLE:			
PIPING AND INSTRUMENTATION DIAGRAM AIR FLOW DIAGRAM FOR 13-C-101A/B/102			
UNIT:	13	PLANT:	HABSHAN-1
CONTR. PROJ. No.:	AET01074.00	CONTR. DWG. No.:	3143236
ADNOC GAS PROJ. No.:	0405323	ADNOC GAS DWG. No.:	5323P1-H1-013-00-50-016
SHEET No.:	01/01	REV:	0
SHEET SIZE: A1			

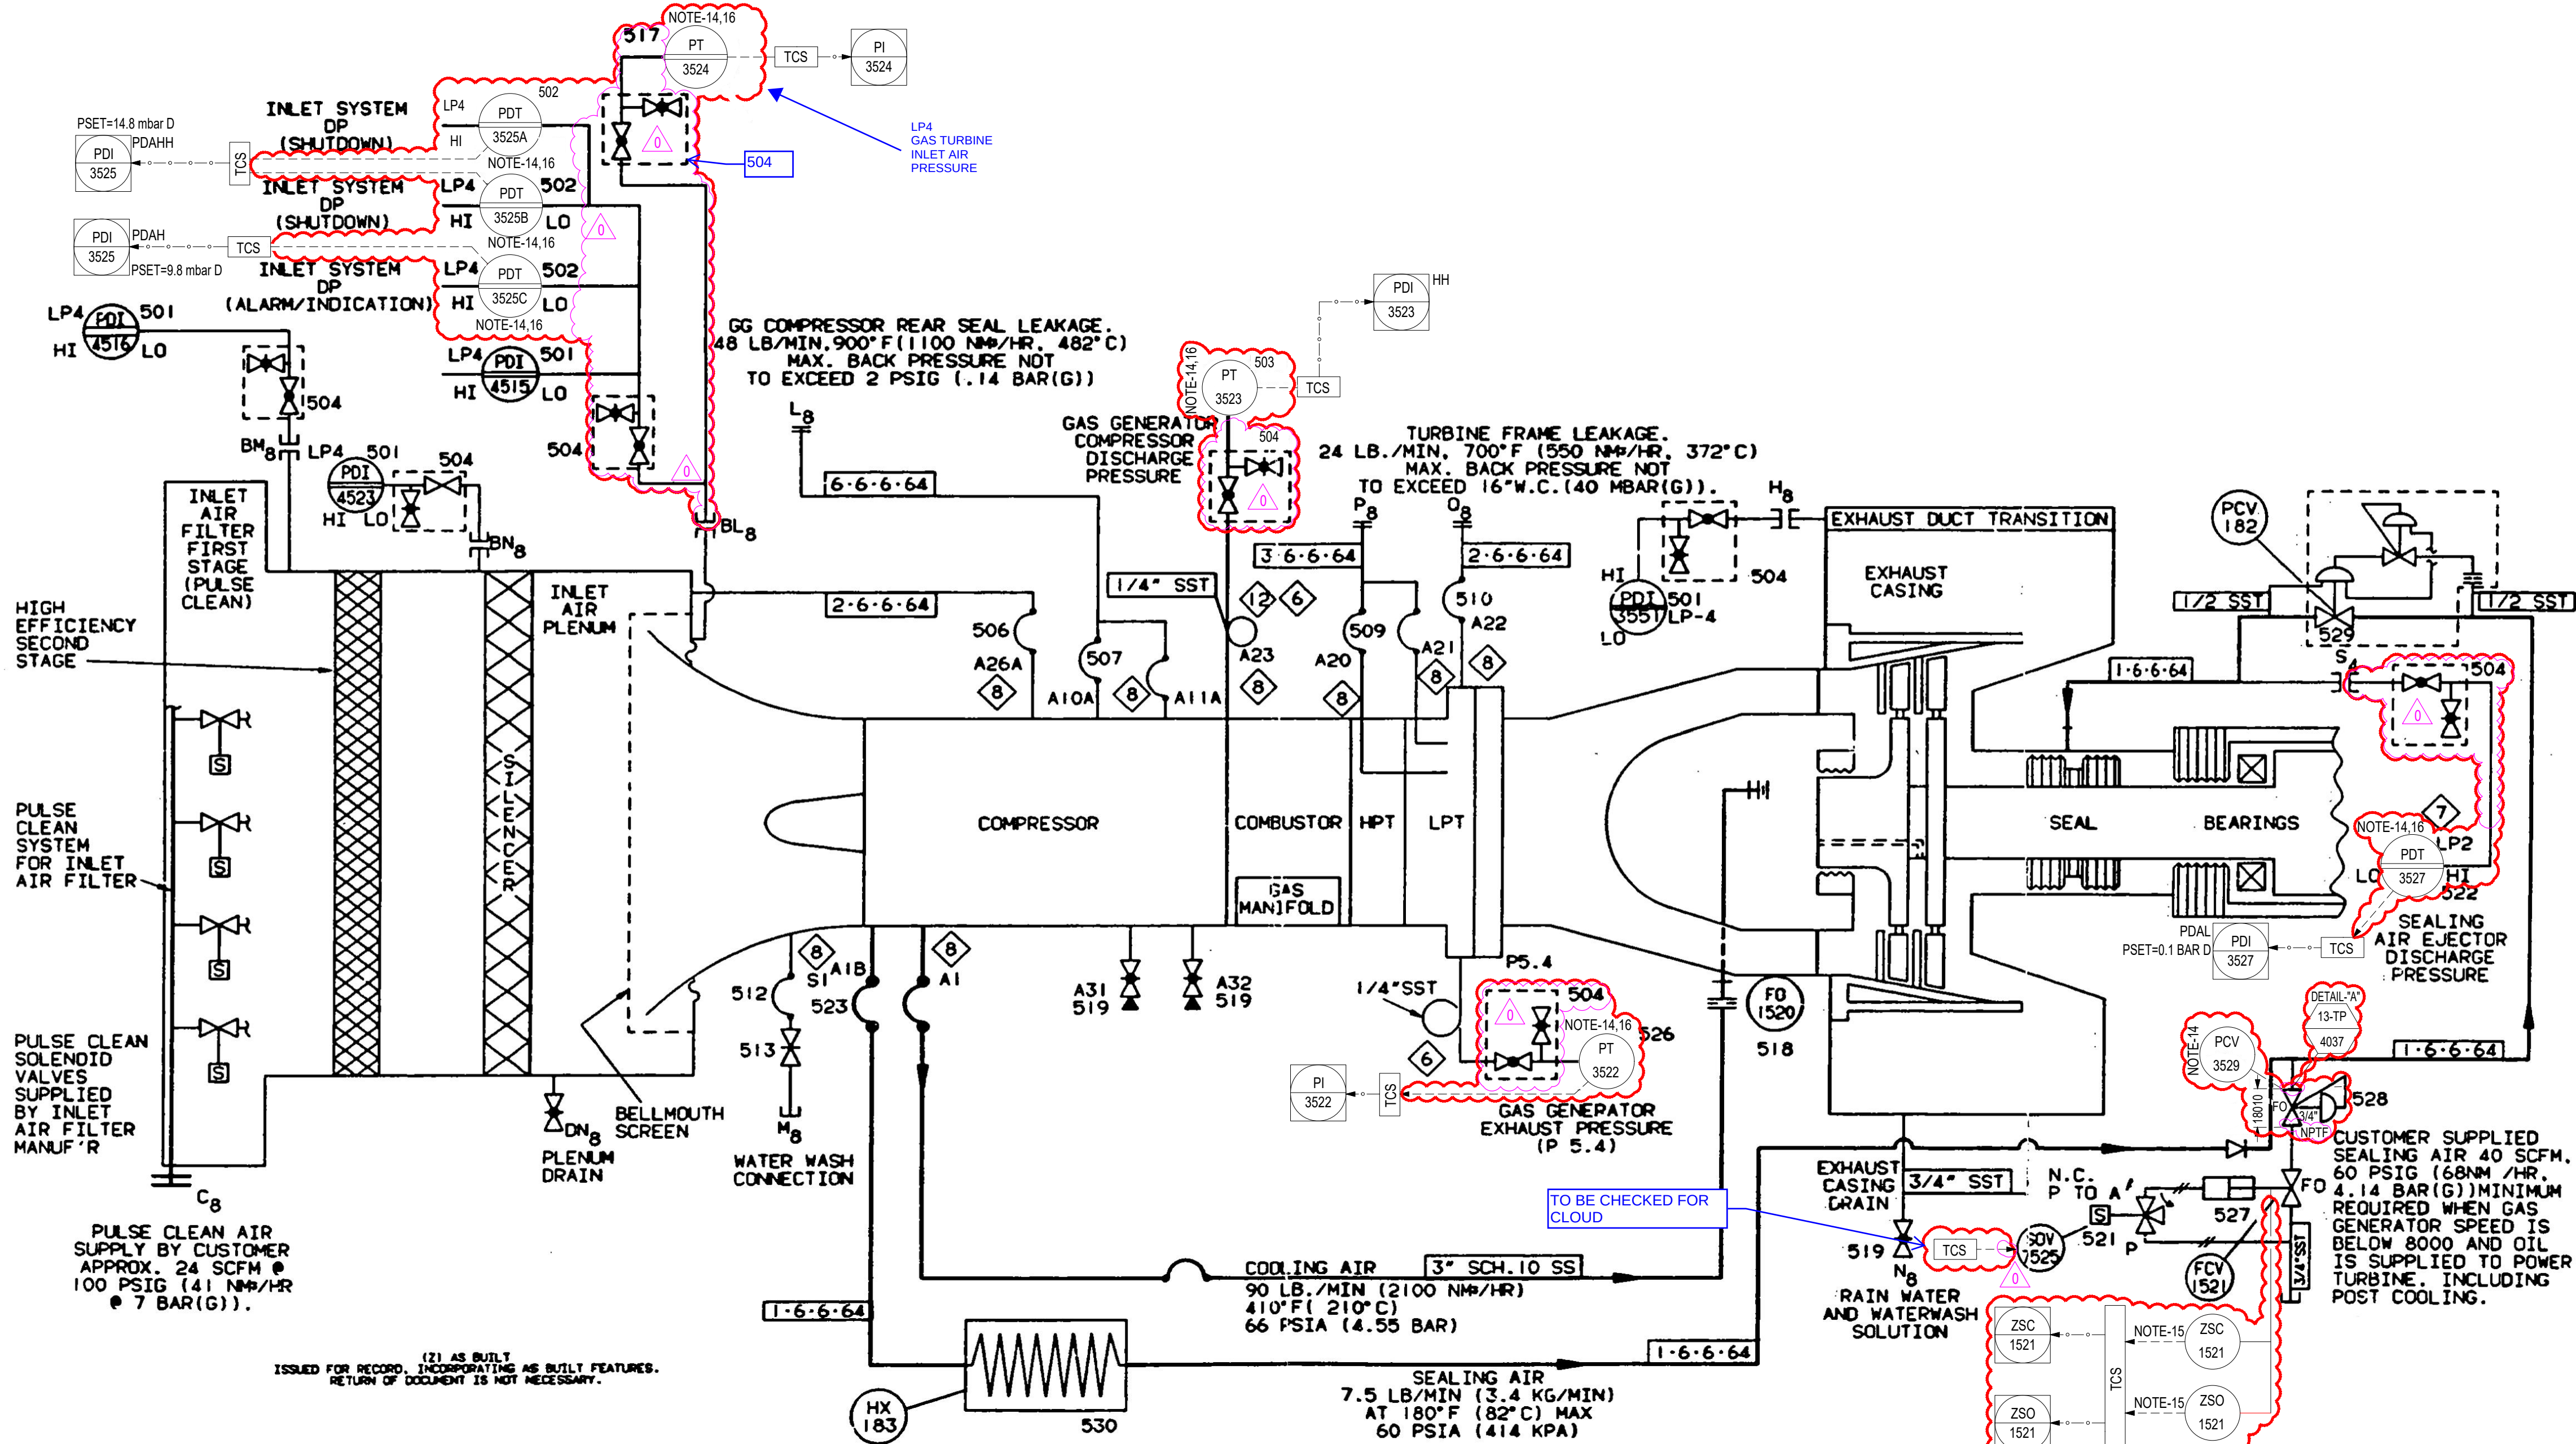

ISSUED FOR RECORD, INCORPORATING AS BUILT FEATURES. RETURN OF DOCUMENT IS NOT NECESSARY.

NOTE-20 DETAIL-"B"		
13-C-102	13-C-101A	13-C-101B
13-PCV-3529	13-PCV-3629	13-PCV-3729
13-PDT-3525A	13-PDT-3625A	13-PDT-3725A
13-PDT-3525B	13-PDT-3625B	13-PDT-3725B
13-PDT-3525C	13-PDT-3625C	13-PDT-3725C
13-PT-3522	13-PT-3622	13-PT-3722
13-PT-3523	13-PT-3623	13-PT-3723
13-PT-3524	13-PT-3624	13-PT-3724
13-ZSC-1521	13-ZSC-1621	13-ZSC-1721
13-ZSO-1521	13-ZSO-1621	13-ZSO-1721

DETAIL-"A"			
PACKAGE	INSTRUMENT TAG	TIE-IN NO	
13-C-102	13-PCV-3529	13-TP-4037	
13-C-101A	13-PCV-3629	13-TP-4038	
13-C-101B	13-PCV-3729	13-TP-4039	

CONTRACT NO. 21712BCD		BY	DATE	DR-61 AIR FLOW	
TYPE DR61		DRAWN	SPN 07/16/92	DIAGRAM	
SCALE NONE		CHECKED	JJM 07/17/92	DRESSER-RAND	
DEPT. 63.81		REDRAW		TURBO PRODUCTS DIVISION	
DRAFTING APPROVAL		DJL	07/17/92	OLEAN, N.Y. USA	
CONTRACT APPROVAL		CAB	07/17/92		
SYSTEM APPROVAL		JJM	07/17/92		
		LICENSEE			

CAD NO.: 5323P-H1-013-00-50-016.DWG