


Bb- 1414 (Th-H)
SINGLE COMPLETION OIL WELL
NOTE 17

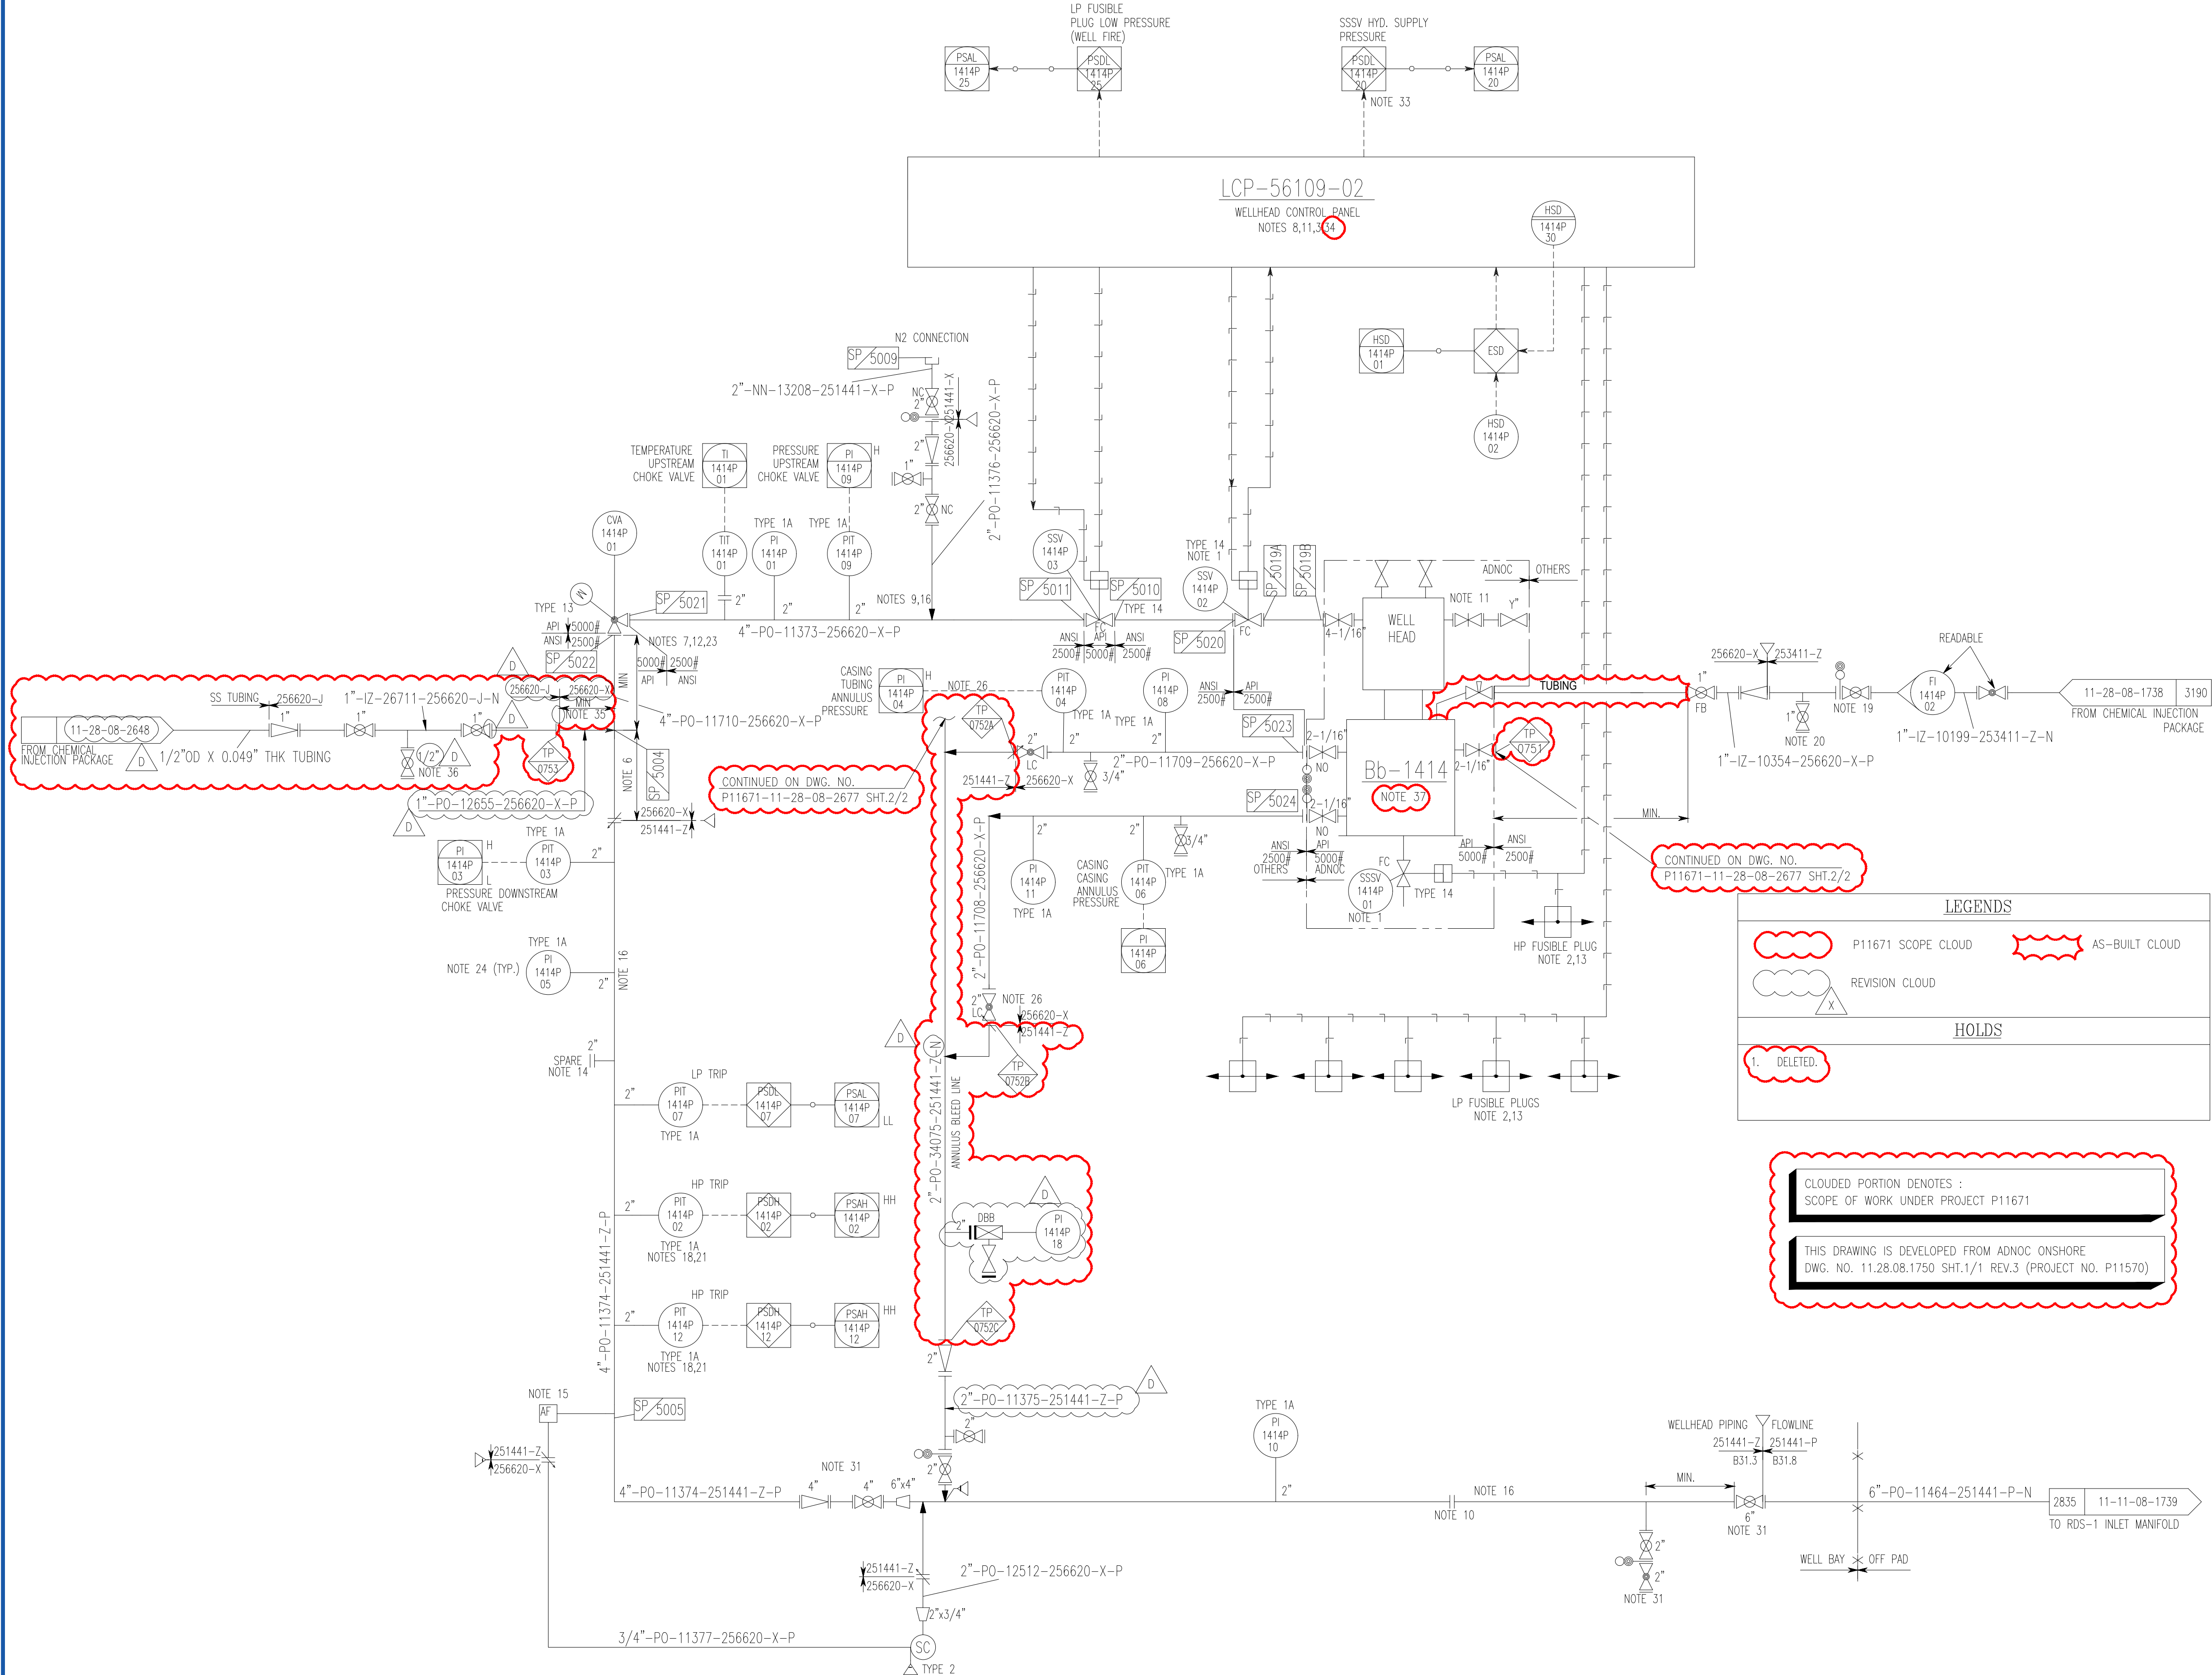

NOTES

- GENERAL NOTES:
- FOR SYMBOL, LEGEND AND GENERAL NOTES, REFER PID'S NUMBER 11.01.08.1752 TO 1755.
 - ALL EQUIPMENT AND INSTRUMENT TAG NUMBERS ON THIS DRAWING ARE PREFIXED BY AREA CODE (11) AND PLANT AREA CODE (28) UNLESS SPECIFIED OTHERWISE.
 - PIPING SPECIALITY TAG NUMBERS ON THIS DRAWING ARE PREFIXED BY AREA CODE (11) PLANT AREA (28) UNLESS OTHER WISE SPECIFIED.
- SPECIFIC NOTES:
- CLOSURE OF SSSV/SSV TO CAUSE THE CLOSURE OF SDV AT INDIVIDUAL HEAD OF PUMP TO TRIP THAT PARTICULAR HEAD OF CHEMICAL INJECTION PUMPS. CHEMICAL INJECTION PUMPS ARE STARTED REMOTELY FROM BCDS CONTROL ROOM.
 - HIGH PRESSURE FUSIBLE PLUGS AND LOW PRESSURE FUSIBLE PLUGS PROVIDED TO SHUTDOWN SSSV AND SSV BY MELTING IN CASE OF FIRE AROUND THE WELL.
 - DELETED.
 - PIPING ARRANGEMENT FOR ALL BLEED CONNECTIONS (PROCESS & INSTRUMENT) TERMINATES 1M AWAY FROM THE MANUAL BLEED VALVES IS OPERATED BY THE OPERATOR.
 - PROVISION FOR REMOTE SHUTDOWN OF WELL FROM BCDS/RDS/WELLBAY OWS.
 - CRA SPOOL IS PROVIDED UP TO 10 D DOWNSTREAM OF CORROSION INHIBITOR INJECTION POINT.
 - CHOKE VALVE IS REMOTE ADJUSTABLE OPENING FROM CDS.
 - LOCATE PANELS 100m DISTANCE IN THE UPWIND DIRECTION.
 - SPOOL BETWEEN SSV AND CHOKE VALVE ARE OF CRA MATERIAL AS PER RELEVANT PIPING MATERIAL CLASS.
 - PROVIDE BREAK FLANGES TO FACILITATE REMOVAL OF PIPING DURING WORKOVER / RIG MOVEMENT UPTO PIPE SLEEPERS.
 - DELETED.
 - LOCAL/REMOTE SOFT SWITCH AT BCDS FOR LOCAL OPERATION OF CHOKE VALVE FROM WELLHEAD AREA.
 - FUSIBLE PLUGS ARE LOOSE SUPPLIED BY WHCP VENDOR.
 - SPARE CONNECTION FOR FLUSHING OR FUTURE CHEMICAL INJECTION.
 - ACCESS FITTING IS COSASCO OR EQUIVALENT TYPE.
 - TWO PHASE LINE (SLUG FLOW), PROVIDE ADEQUATE SUPPORT. INSTRUMENT IS MOUNTED WITH ADEQUATE SUPPORT.
 - REFER TO THE WELLHEAD TABLE PROVIDED IN P&ID 11.99.08.1802 SHT. 1-3 FOR WELL ALLOCATION DETAILS.
 - A MECHANICAL INTERLOCK IS PROVIDED WHICH ALLOWS ISOLATION OF ONLY ONE PRESSURE TRANSMITTER AT A TIME, WHILE ALL INTERLOCKED VALVE SP TAG NUMBER IS SP-5051.
 - ISOLATION VALVE IS LOCATED 100m AWAY FROM WELLHEAD IN UPWIND/CROSSWIND DIRECTION WITHIN WHCP FENCE AREA.
 - TEMPORARY DRUM IS USED FOR DRAINING OF THE CHEMICAL LINE DURING WORK OVER OPERATION.
 - NUMBER OF PRESSURE TRANSMITTER FOR HP TRIP IS 2. THE PTs ARE CERTIFIED FOR SIL2@HFT=0, THE HFT IS RELAXED AS PER IEC 61511.
 - HIPPS PROVIDED AS THE CONNECTING ANNULOID IS #1500 RATED. HOWEVER PIPELINE IS CONSIDER #2500 RATED AS PER SCOPE.
 - DISTANCE BETWEEN WELL HEAD AND CHOKE VALVE IS AS MINIMUM AS POSSIBLE.
 - PROVIDE INTEGRAL DOUBLE BLOCK & BLEED VALVES FOR ALL PRESSURE INSTRUMENT CONNECTION.
 - DELETED.
 - CASING TO CASING AND/OR CASING TO TUBING BLEED OFF OPERATION IS MANUAL UNDER OPERATING PROCEDURES. WHEN ANNULUS HIGH PRESSURE IS DETECTED, OPERATOR TO ENSURE THAT THERE IS NO FLUID STAGNANCY.
 - DELETED.
 - DELETED.
 - TRANSMITTERS ARE NOT MOUNTED ON FLOW LINE. IT IS MOUNTED SEPARATELY WITH ADEQUATE SUPPORT.
 - DELETED.
 - DELETED.
 - DOUBLE BLOCK AND BLEED ARRANGEMENT FOR WELL ISOLATION.
 - FOR WHCP DETAILS REFER VENDOR P&ID 11-28-08-3634.
 - THIS SIGNAL IS USED FOR SSSV CLOSED STATUS.
 - LOCAL CONTROL PANEL SHALL BE PROVIDED AS PART OF BRIP PROJECT P11570 AND P11671 WILL INTEGRATE THE SIGNALS IN SAME PANEL.
 - STANDARD INJECTION NOZZLE AND ACCESS FITTING (COSASCO OR EQUIVALENT FITTING). REFER DETAIL 'A' OF LEGEND SHEET 11-99-08-2601.
 - TEMPORARY DRUM SHALL BE USED FOR DRAINING OF THE CHEMICAL LINE DURING WORK OVER OPERATION.
 - ADNOC WILL UPDATE THIS WELL TO Y-TYPE CHRISTMAS TREE, AS PER ADNOC STANDARDIZATION PHILOSOPHY.

LEGENDS

- P11671 SCOPE CLOUD
- AS-BUILT CLOUD
- REVISION CLOUD

HOLDS

1. DELETED.

CLOUDED PORTION DENOTES :
SCOPE OF WORK UNDER PROJECT P11671

THIS DRAWING IS DEVELOPED FROM ADNOC ONSHORE
DWG. NO. 11.28.08.1750 SHT.1/1 REV.3 (PROJECT NO. P11570)

REFERENCE DRAWINGS

TITLE	DRG. No.
LEGEND SHEET	11.01.08.1752 TO 1755
P&ID LEGEND SHEET	P11671-11-99-08-2601
SINGLE COMPLETION OIL WELL Bb-1414 (Th-H) WITH HIPPS WELLBAY - 109 (DEMOLITION)	P11671-11-28-08-2678

REV.	DATE	DR'N.	CH'D.	AP'D.	DESCRIPTION
D	18.07.2025	VP	TL/ST	AJ	ISSUED FOR DESIGN (IFD)
C	09.05.2025	VP	TL/ST	AJ	ISSUED FOR HAZOP (IFH)
B	04.03.2025	VP	TL/ST	AJ	ISSUED FOR DESIGN REVIEW (IDR)
A	31.01.2025	PRA	TL/ST	AJ	ISSUED FOR REVIEW (IFR)

SCALE: N.T.S	LOCATION: BAB/HABSHAN	PROJECT No. P11671
--------------	-----------------------	--------------------

CONSULTANT / CONTRACTOR / VENDOR	EPC CONTRACTOR
DRAWING No. AET01342-00-3143075	

PROJECT:

DRG. TITLE:
**PIPING & INSTRUMENT DIAGRAM
SINGLE COMPLETION ARTIFICIAL LIFT OIL WELL Bb-1414P
GASLIFT RATING 2500# HIGH H2S MINIPAD 109 :BAB**

DRG.No.	1128082677D	1/2
AREA	P/AREA	DOC. CODE
SERIAL No.	REV.	SHT
OF	SHT	